



Take Home

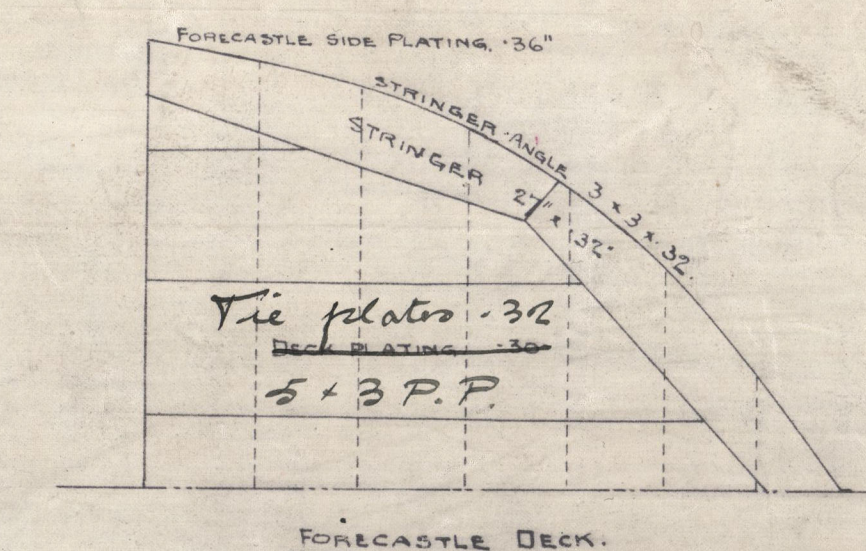

C. f.  
28.6.16

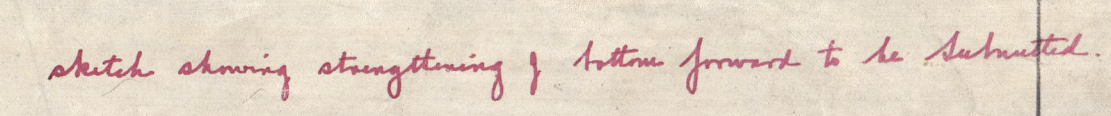









GLASGOW REPORT No. 37185

95 Garthchyle

River Clyde SB Wh  
Profile  
ex. 2

7/11  
ex. 5  
emailed

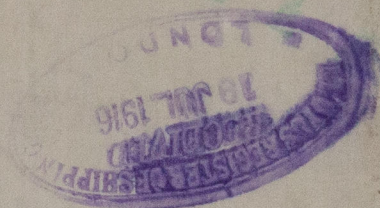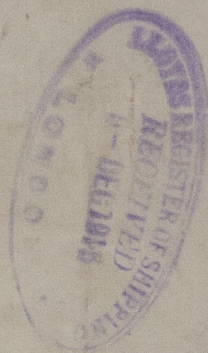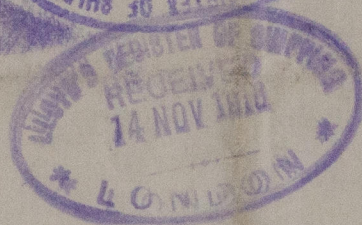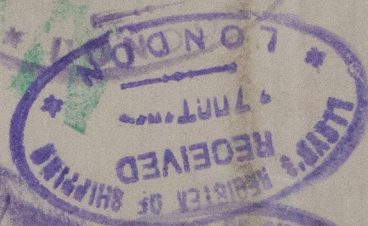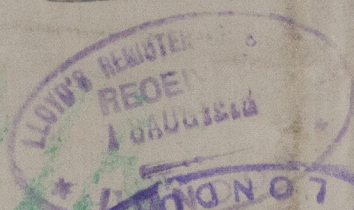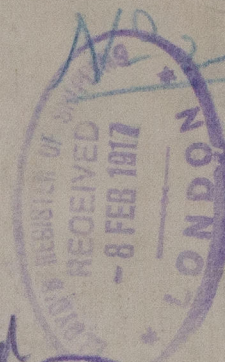

© 2020

Lloyd's Register  
Foundation