
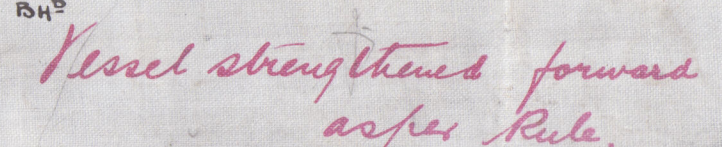


21.1.09

DOCK SHIPBUILDING & REPAIRING CO. LTD.
SHIPBUILDERS & ENGINEERS
15/1/09 JW
VICTORIA SHIPYARD, COOLE

21.1.09

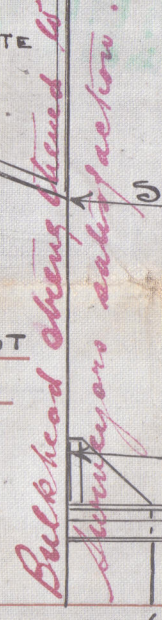

Good S. & R. Co. Ltd.
No 128.

Profile & Deck Plan

S/S Breaksea
Null Report No. 21546

RETAIN



© 2020

Lloyd's Register
Foundation

W902-0077