
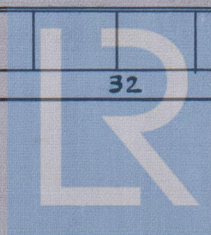


- No 128 -

AMENDED POSITION OF QUARTER DECK END.

SCALE $\frac{1}{4}" = 1 \text{ FOOT.}$

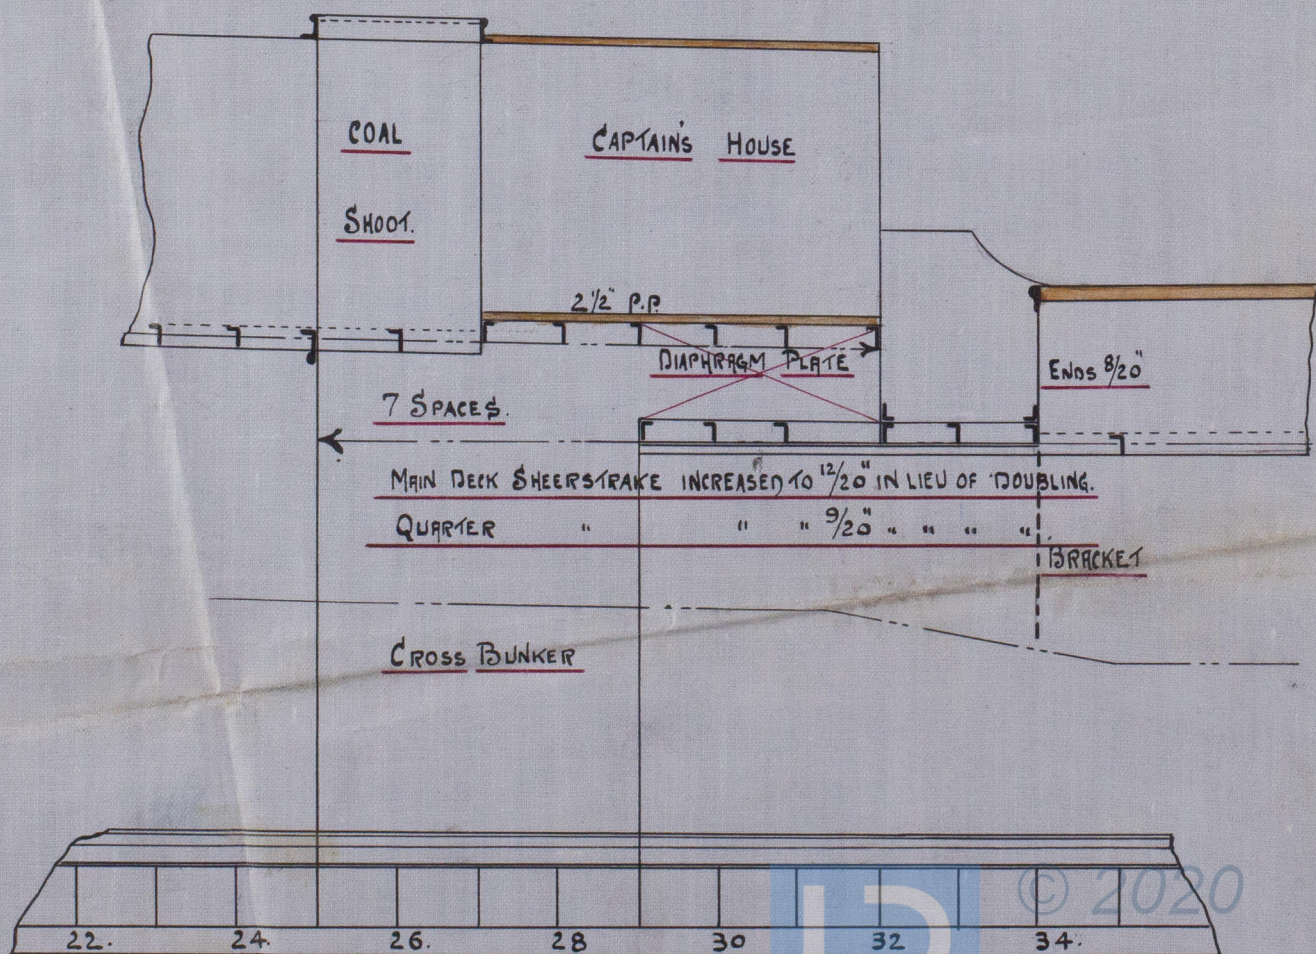

© 2020

Lloyd's Register
Foundation

W902-0078