


23.1.01
2.5.01

Cargo Steamer.

Principal Dimensions.
Length overall 358'-0"
Length between perps 345'-0"
Breadth extreme 47'-6"
Depth moulded 25'-6"

Scale 1/8" = 1 Foot.
Pillars shown thus O.

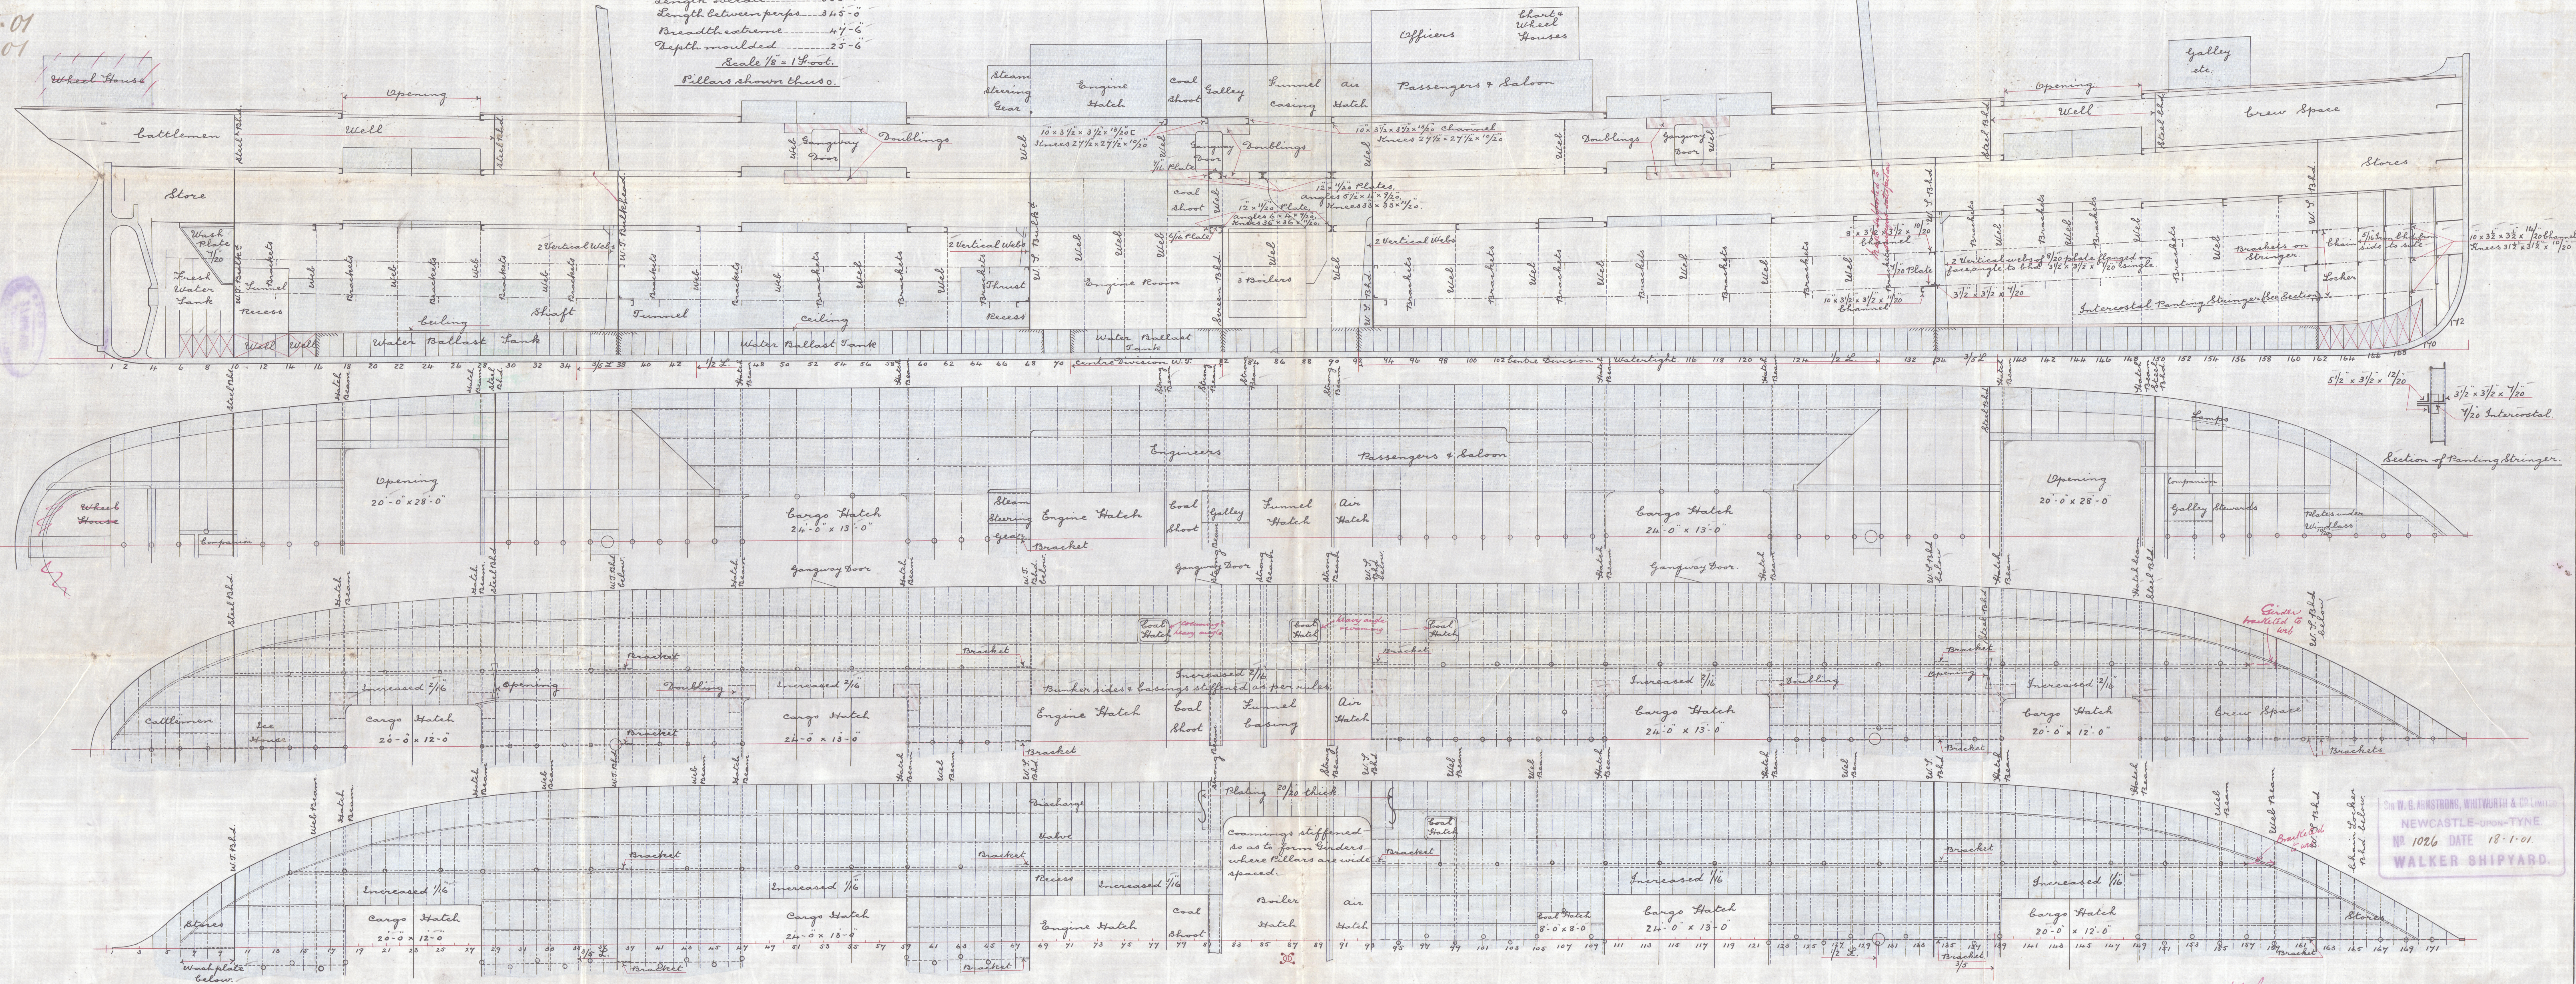

By W.B. ARMSTRONG, WHITWORTH & CO. LIMITED
NEWCASTLE-UPON-TYNE
No 1026 DATE 18.1.01.
WALKER SHIPYARD.

