


HOWALDTSWERK
KIEL.
15845 d. 7.5.03
EIGENTUMS- & VERVIELFÄL-
TIGUNGSRECHT VORBEHALTEN

— DIMENSIONS. —

LENGTH BETWEEN PERPENDICULARS	225'-0"
BREADTH MOULDED	34'-6"
DEPTH INCLUDING CROP TO UPPER DECK	18'-10"


-1:25

ENGL. LLOYD'S 100 A1+

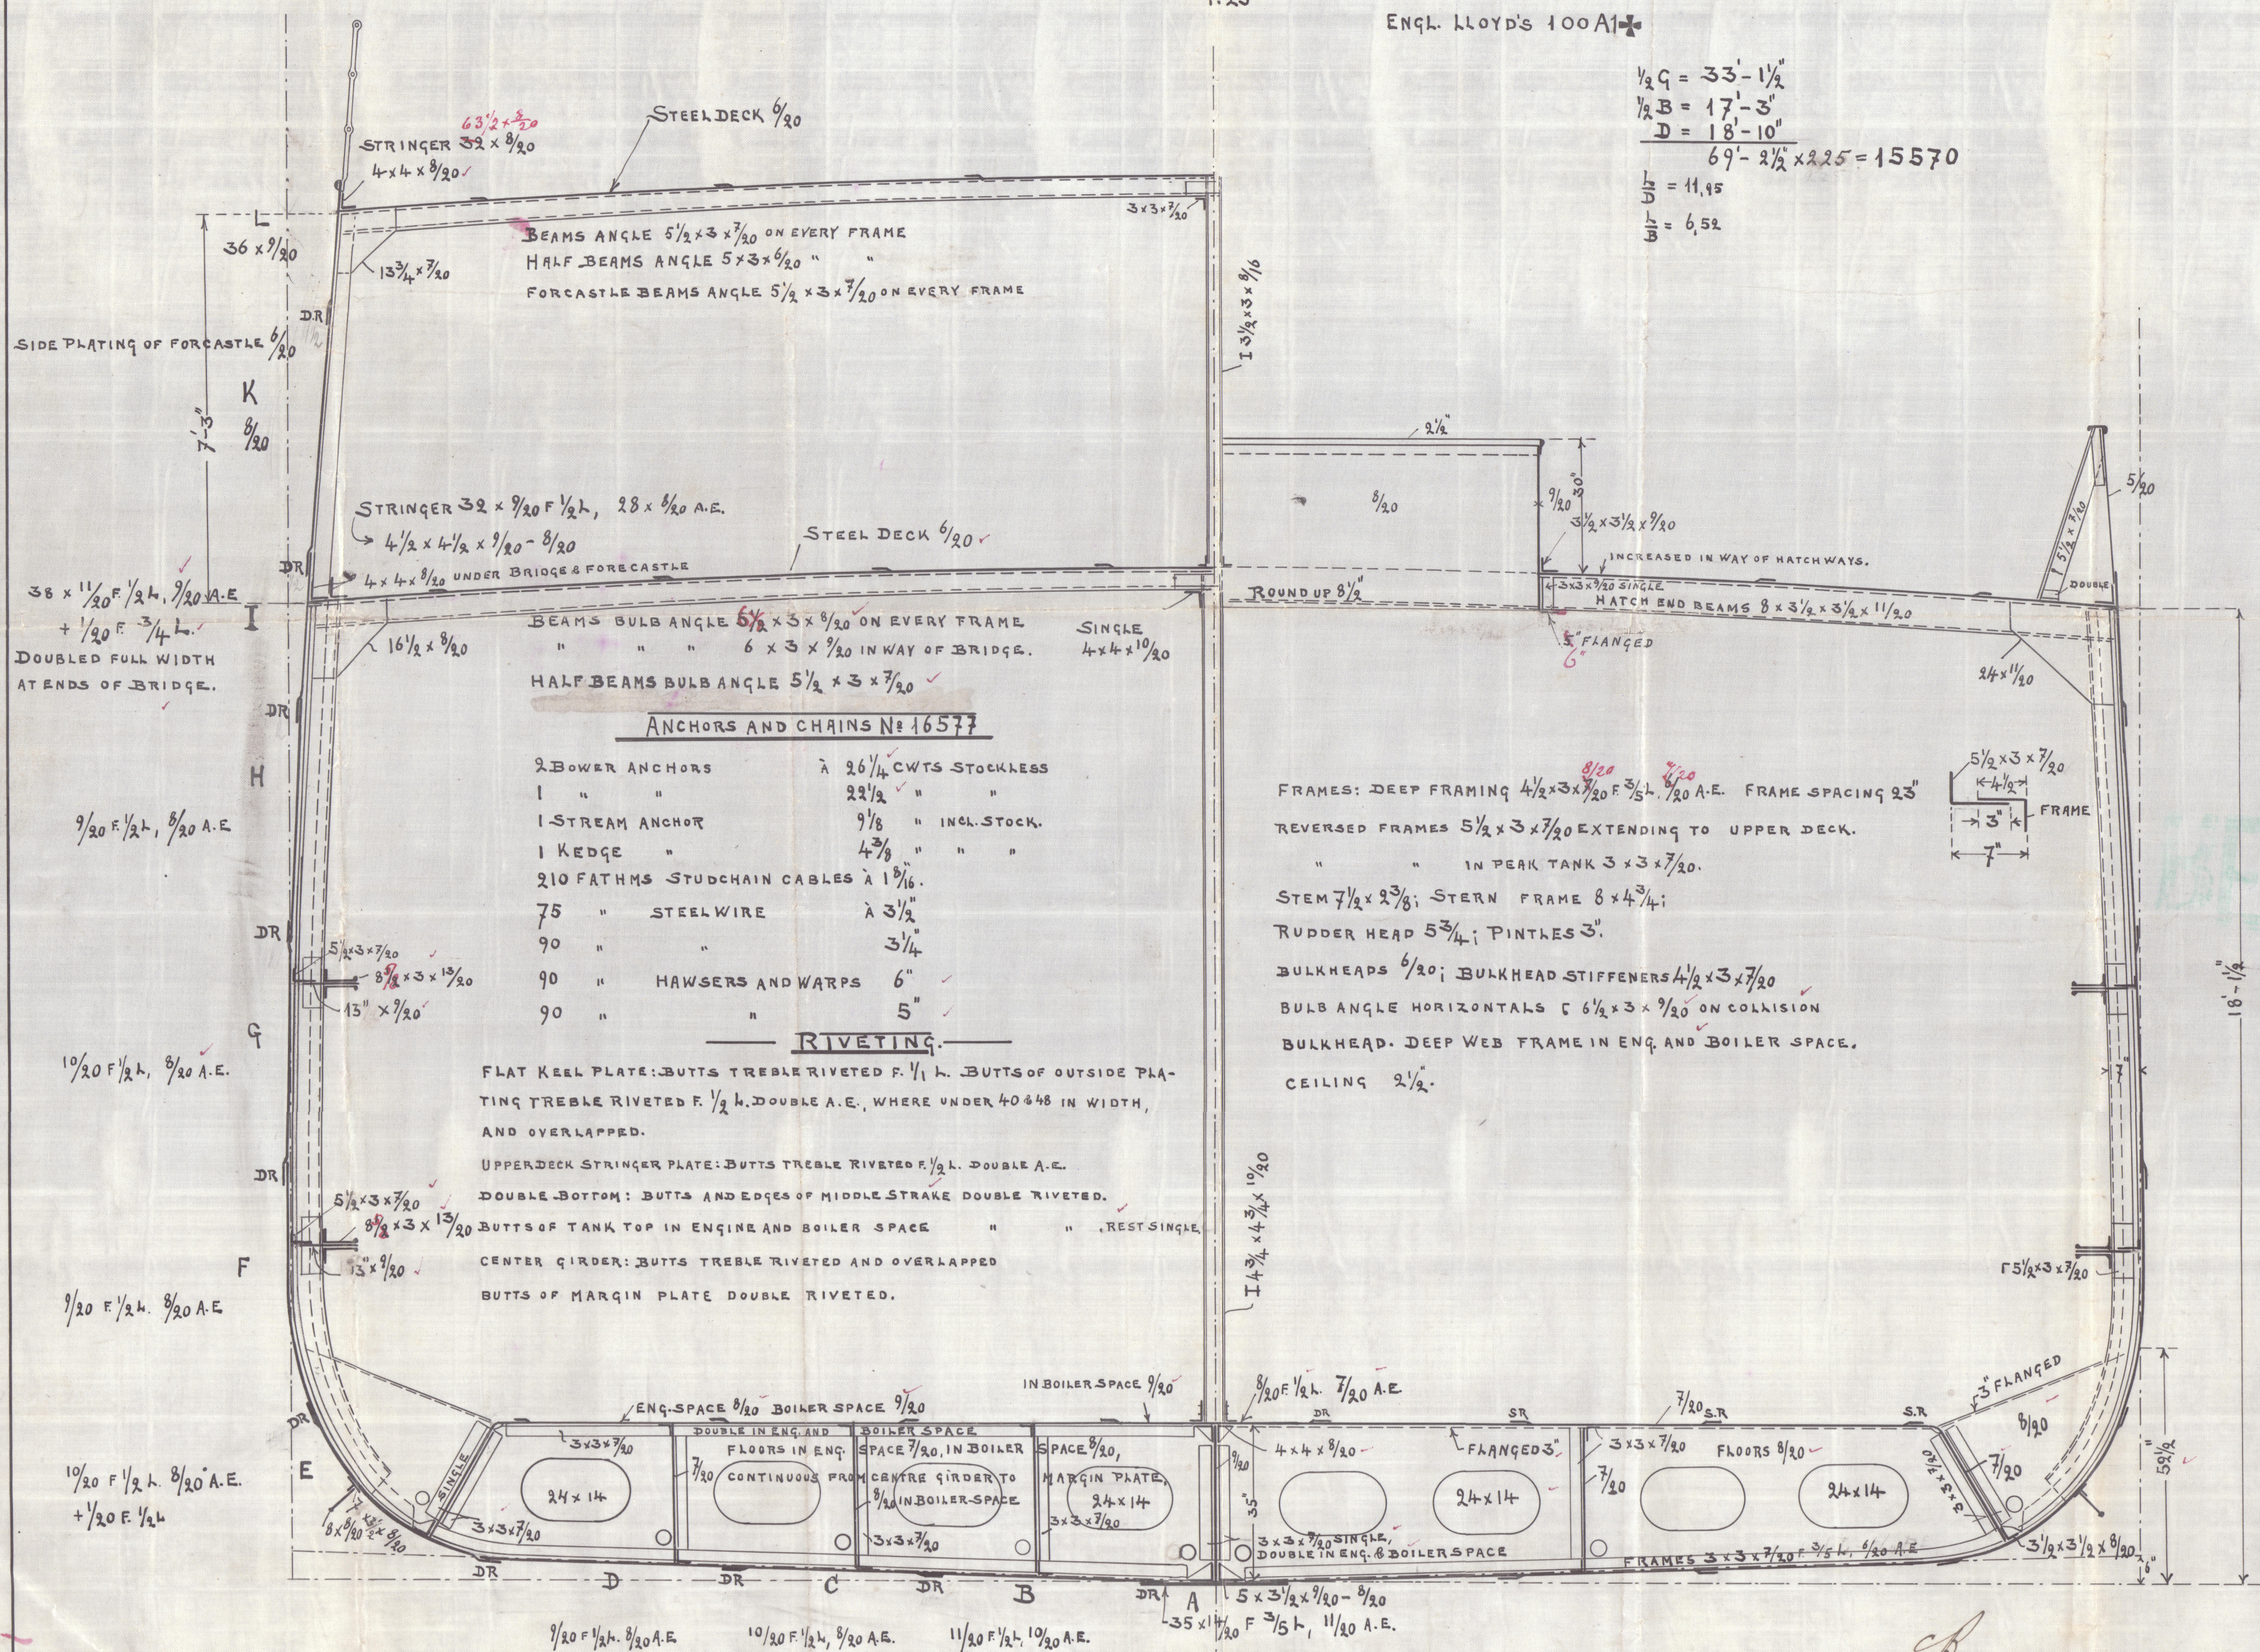
$$\begin{array}{r} \frac{1}{2}C = 33' - 1\frac{1}{2}'' \\ \frac{1}{2}B = 17' - 3'' \\ \hline D = 18' - 10'' \\ 69' - 2\frac{1}{2}'' \times 225 = 15570 \\ \hline \frac{1}{D} = 11.95 \\ \frac{1}{B} = 6.52 \end{array}$$


12.5.05

Ostergötland
Ham. Rep. N. 7867
Transverse Section
Howaldtswerke
No 401
Hamburg Letter 9/5/03

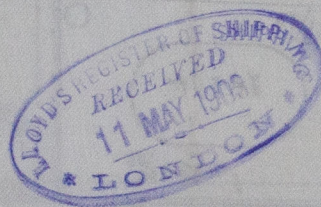

RETAIN

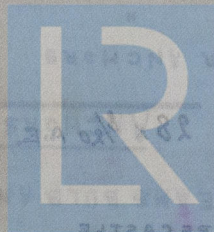

© 2020

Lloyd's Register
Foundation

W982-0253