
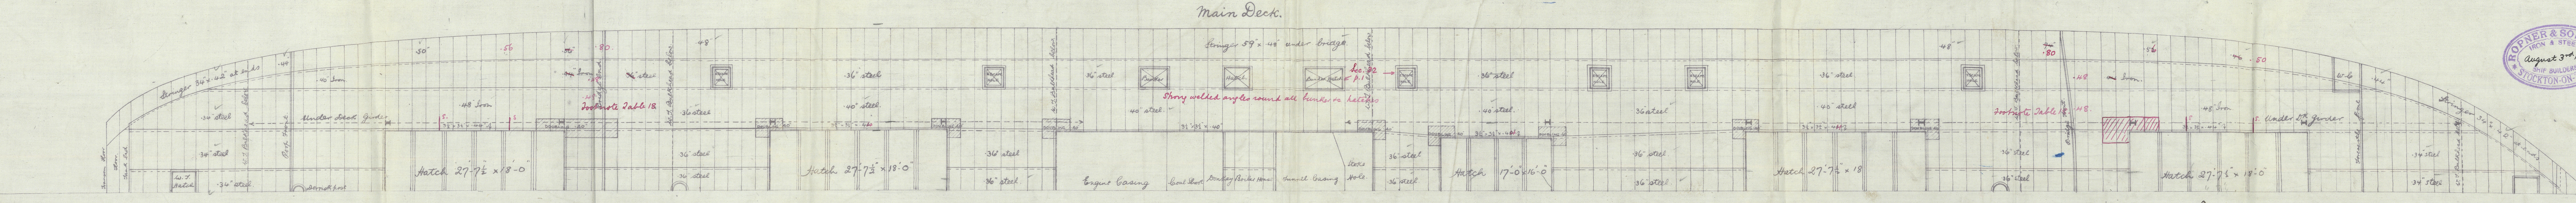
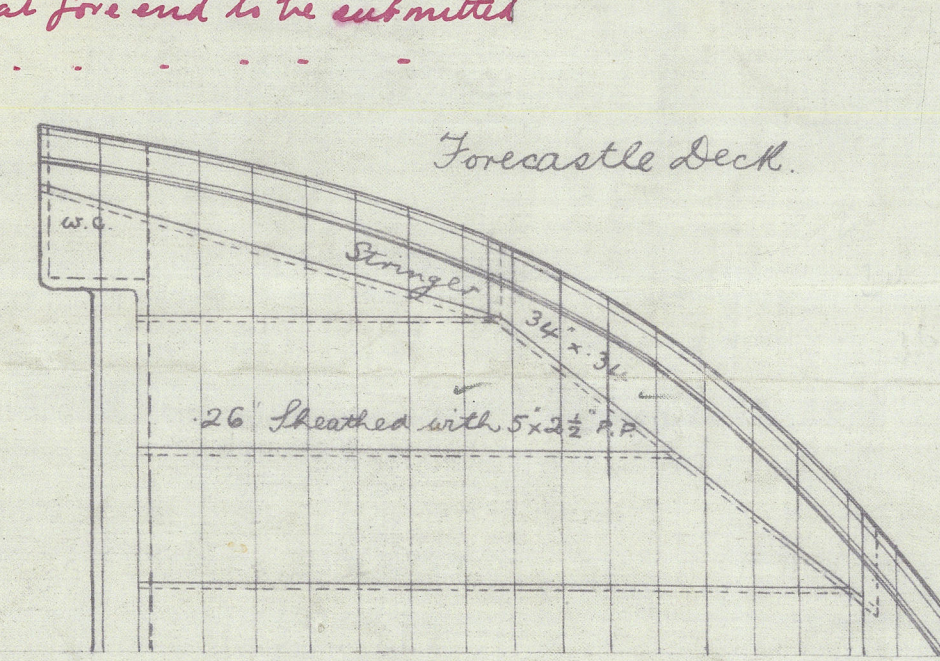
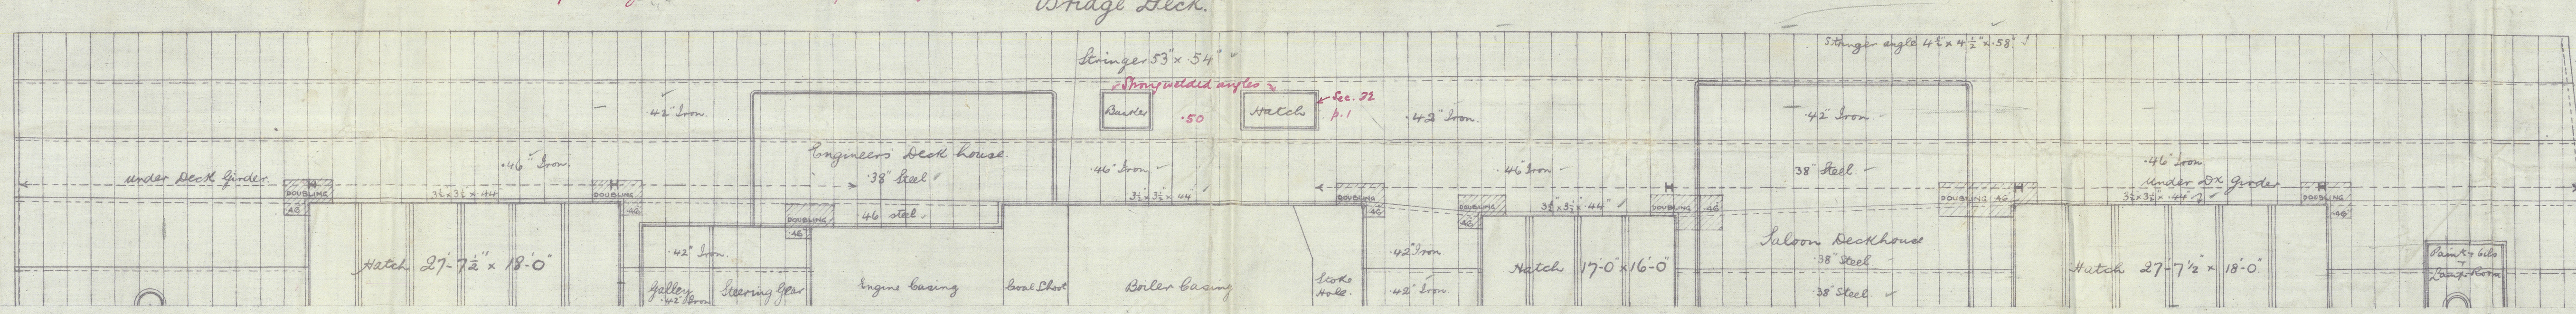
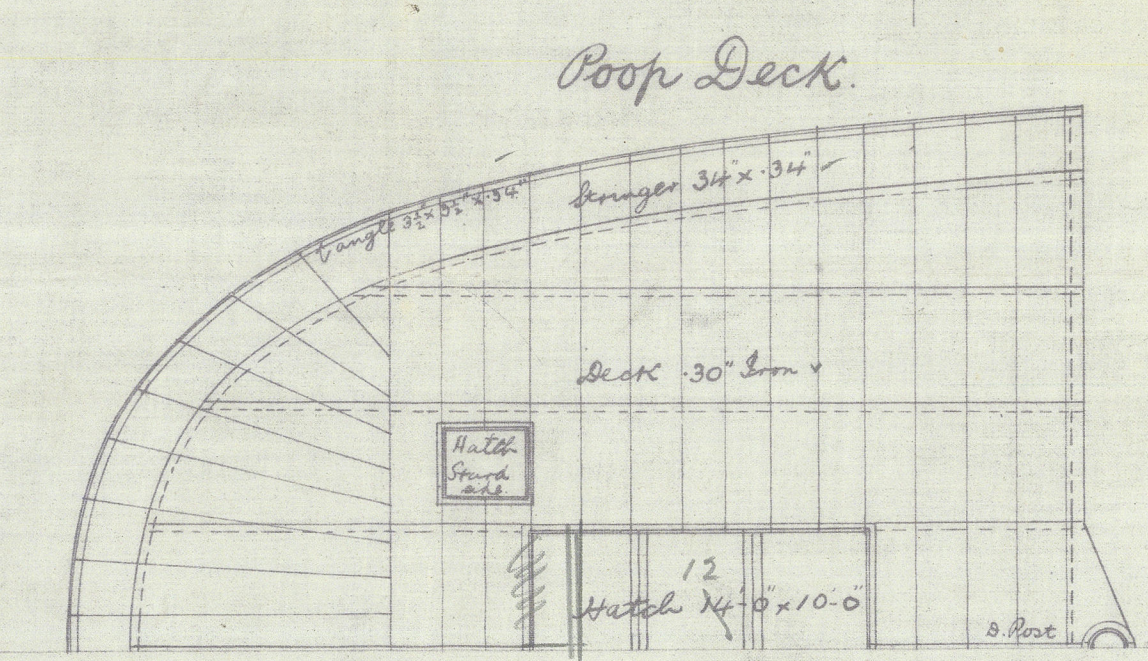


17.8.16
26.9.16

PROFILE & DECK PLANS.
DIMENSIONS - 385'-0" x 53'-0" x 27'-6" MOULDED.
TO CLASS 100 A.I. AT LLOYDS.
SCALE 1/8" INCH = 1 FOOT.

Hatch Coaming Stayed
Sec. 32 para. 3.

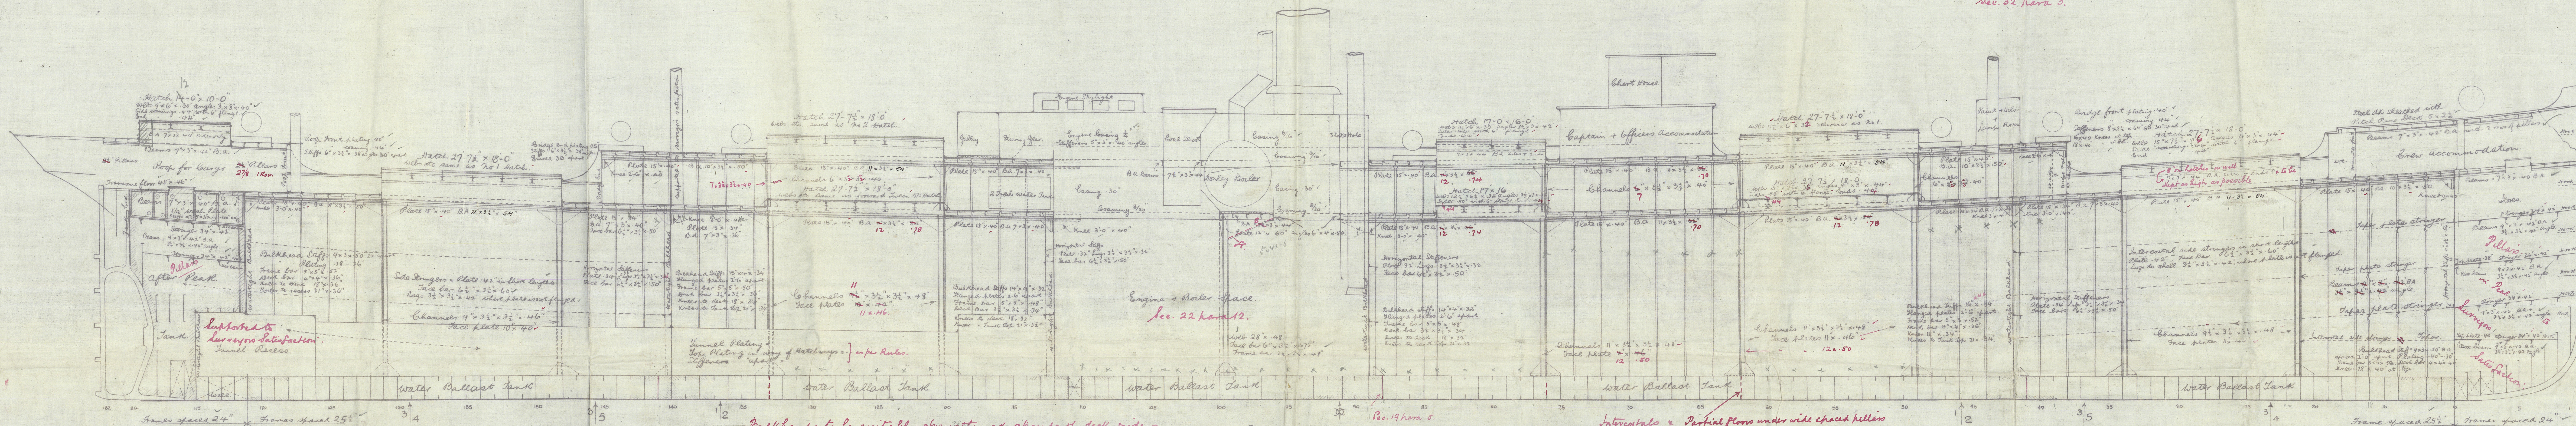

ROPER & SONS, LTD.
August 3rd 1916
BUILDERS
STOCKTON-ON-TEES

C.F.
17.8.16

Mr. Rapner & Sons Ltd


WVS 09

Profile & Becks

S/S. Emberton




Mr. Rapner & Sons Ltd 9869^b

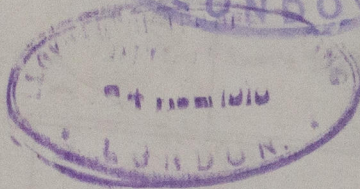

London Copy

Anglo-Beck's

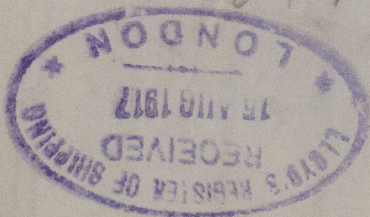

WVS 09

RETAIN

RETAIN



© 2020

Lloyd's Register Foundation

W905-0063