


To CLASS 100. A.I. AT LLOYDS

SCALE  $\frac{1}{2}$  = ONE FOOT.

$$\begin{array}{r} 2025 \\ 30911 \\ \hline 32936 = y \end{array}$$

BRIDGE DECK 36 STEEL  
BRIDGE DECK 42' FOR LENGTH STEEL OF 1/2" THICKNESS  
BUTTS DOUBLERIETED FOR 1/2" LENGTH SINGLE AT ENDS.

Nº 509.

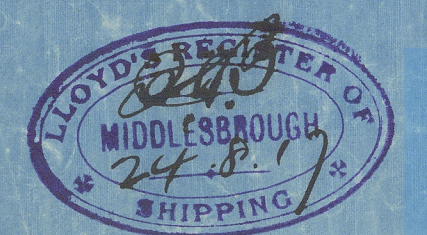

W905-0064



Messrs. Ropner & Sons Ltd  
No 509.

Mid. Sec:  
as built

Sp. Embleton

Indb report No. 986<sup>6</sup>



REMAIN

REMAIN



© 2020

Lloyd's Register  
Foundation

W905-0064