


== SCALE  $\frac{1}{2}" = 1 \text{ FOOT}$  ==

25.3.14

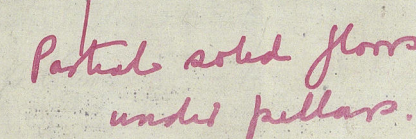

Cf.  
22.1.14





SUNDERLAND



Midship Section

S. S. No 234

Bartram Sons.

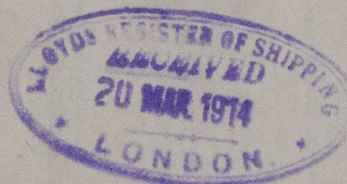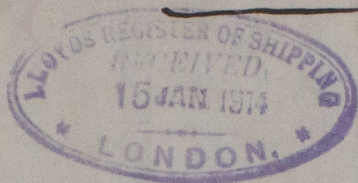

RECEIVED

E/S Exford

SUNDERLAND RPT. No. 26266



© 2020

Lloyd's Register  
Foundation