


# MIDSHIP SECTION.

SCALE  $\frac{1}{2}$ " = 1 F.I.

27.7.14  
31.7.14

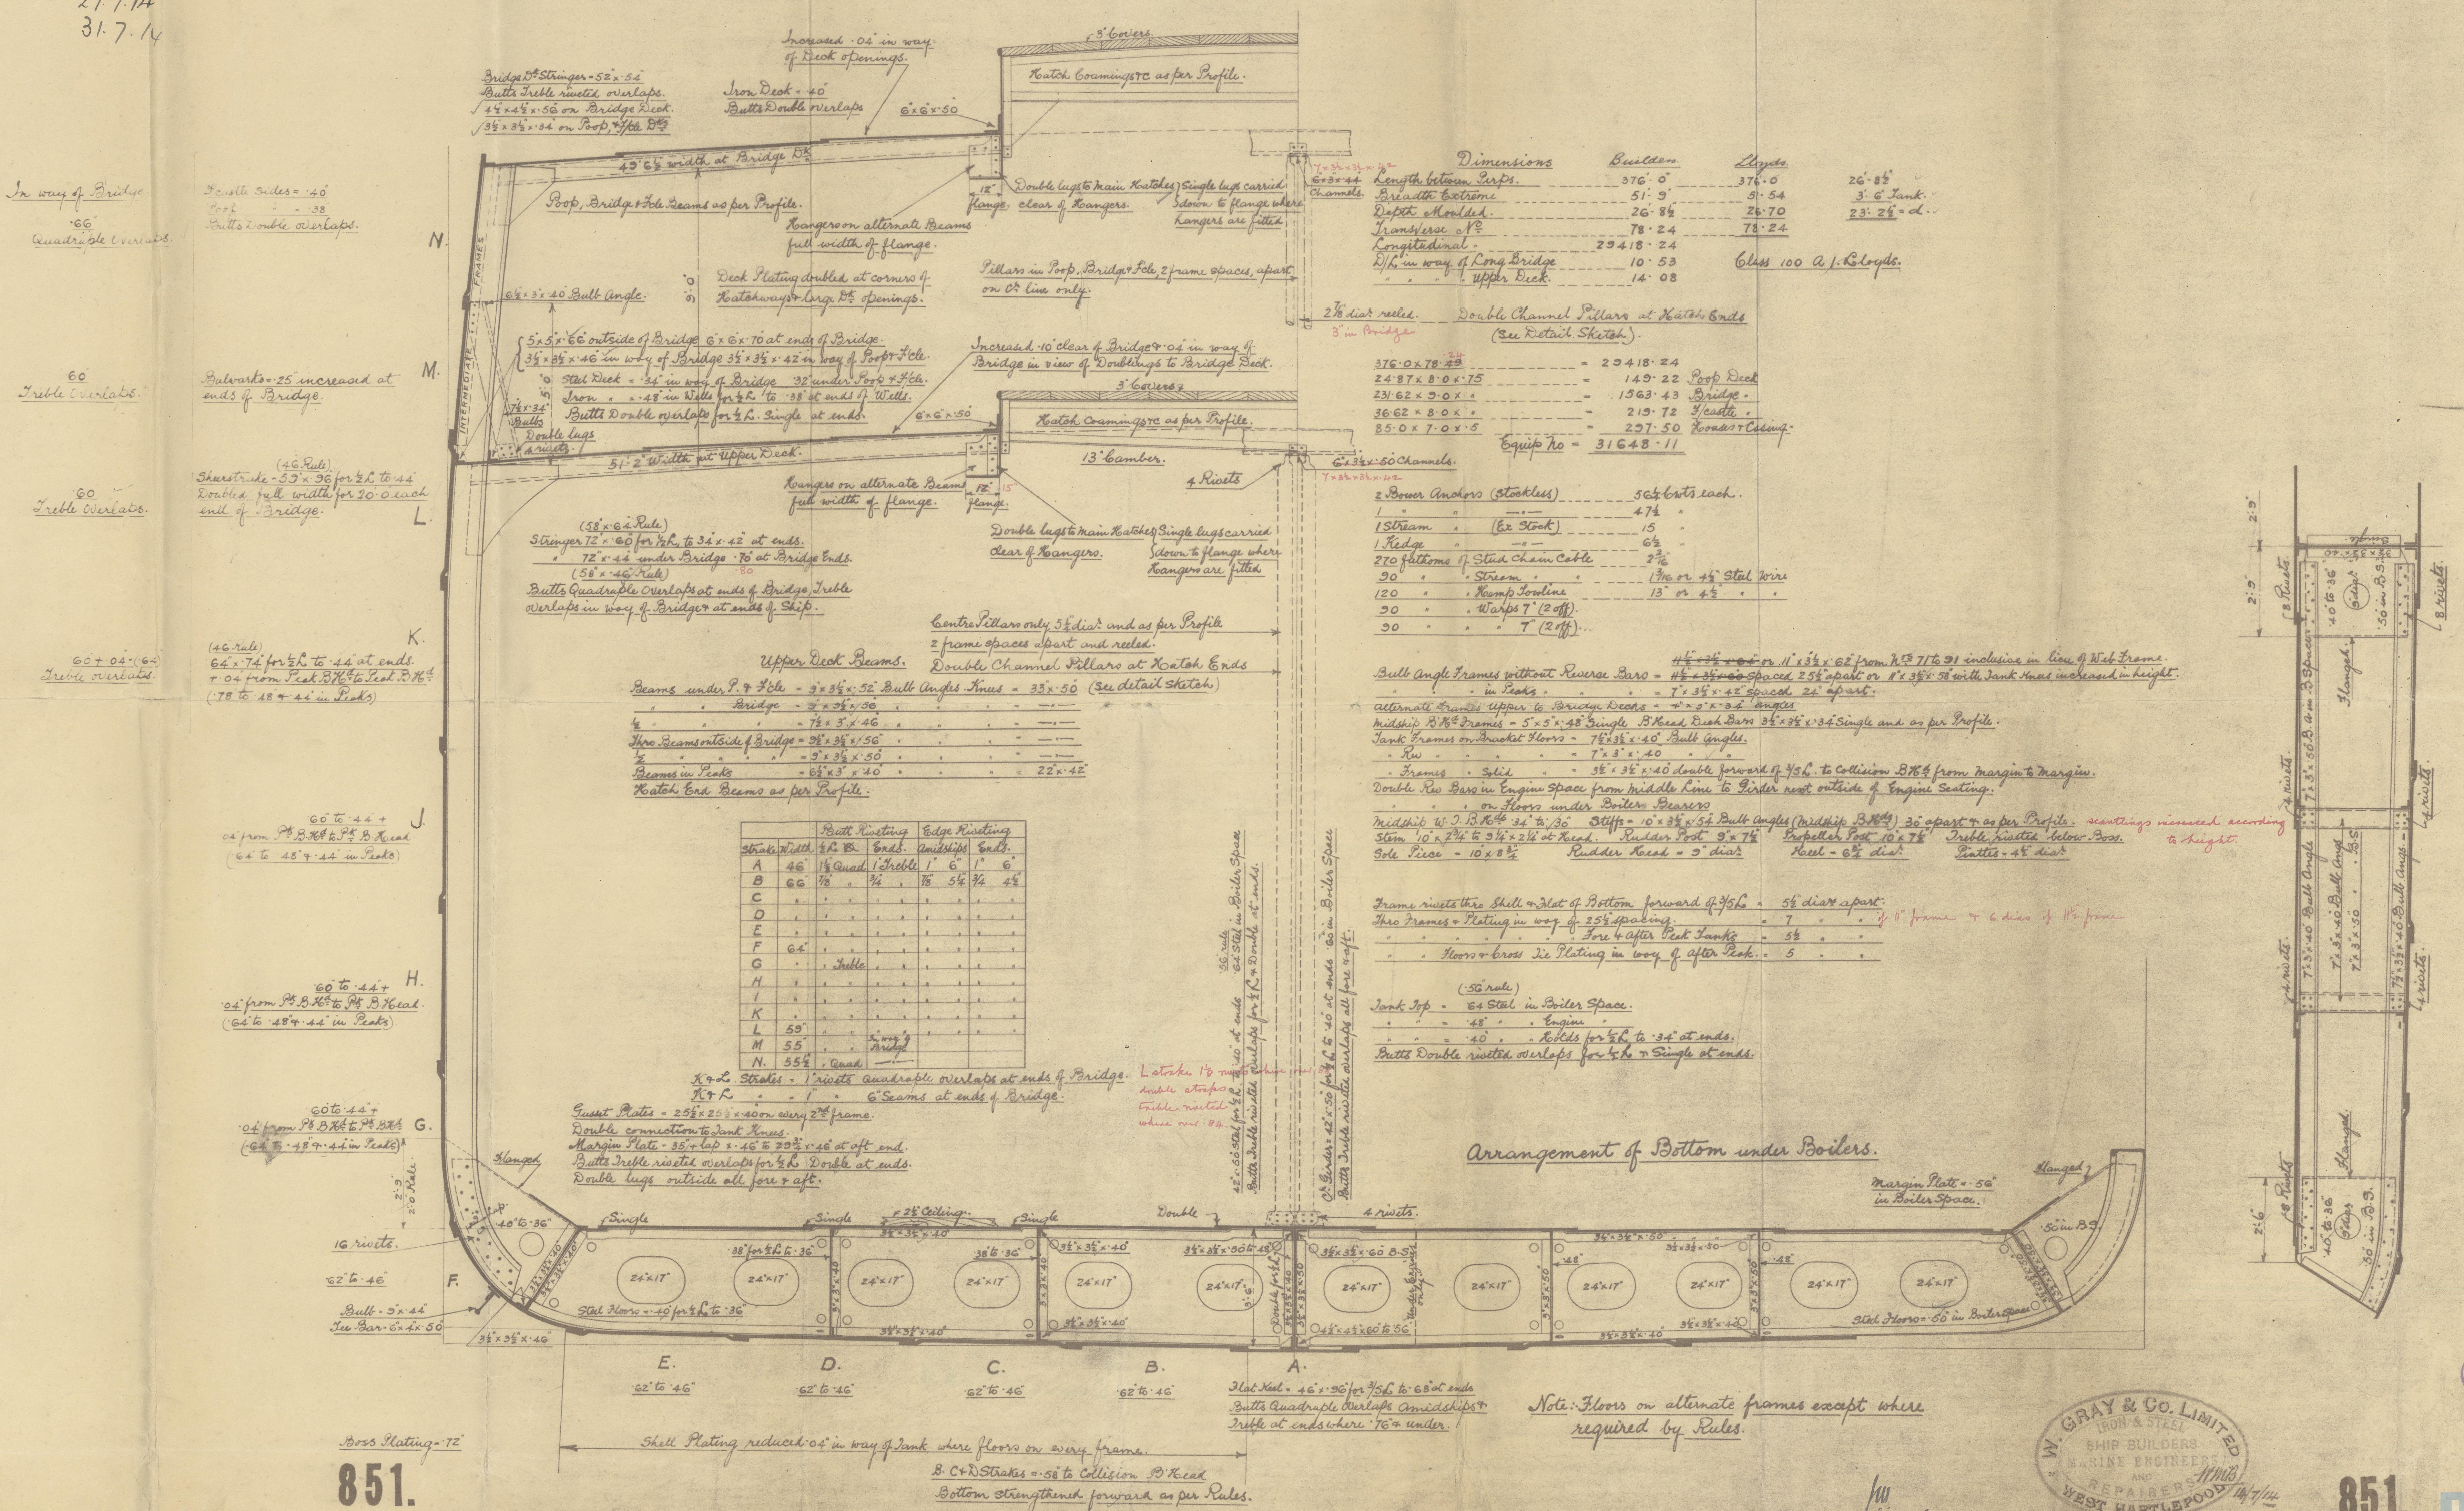

## SECTION IN WAY OF INTERMEDIATE FRAMES.



— Midship Section. —

W. Gray & Co. No. 851.

S.S. "Firfield"

W. Adm. Reg. No. 15067.



RE TAIN



RE TAIN

