

NUMERALS

CLASS 100. A. 1. LLOYDS

STEEL

<u>POOP</u>	<u>44'4" x 8</u>	} $\times \frac{3}{4}$	=	2190
<u>BRIDGE PILE</u>	<u>3206 x 8</u>			
<u>SALOON</u>	<u>21 x 8</u>	} $\times \frac{1}{2}$	=	372
<u>CASING</u>	<u>72 x 8</u>			

EQUIPMENT No. = 37330 = (Z

EQUIPMENT(2)

3 BOWERS STOCKLESS 60³/₄ CWT'S OWNERS REQUIREMENTS
1 STREAM EX STOCK 17¹/₂ "
1 KEDGE " 7¹/₂ "
270 FMS 2⁴/₁₆ STUDCHAIN CABLE
120 FMS 4³/₄ STEEL WIRE
120 FMS 5" STEEL WIRE } WIRE SPECIFIED BY OWNERS
40120 FMS 3¹/₄ STEEL WIRE }

THE FOLLOWING IN ADDITION TO LLOYDS.

4 @ 120 FMS 6 1/2" MANILLA
4 @ 120 FMS 6" "
2 @ 20 FMS 10" " WITH THIMBLES & SHACKLES AT
EACH END FOR TOWING SPRINGS

ALTERNATE FLOORS

FRAMES. INSIDE TANK $7\frac{1}{2} \times 3\frac{1}{2} \times .44$ B.A.

REVERSES " " $7\frac{1}{2} \times 3 \times .40$ BH

GUSSETS EVERY FRAME
3 1/2 x 3 x .50

10 1/2 x 27

PROP. POST $10\frac{1}{2} \times 8$

RUDDER 9' x 8'

Lloyd's Register
Foundation

W907-0066

Mrs. Craig Taylor & Co. Ltd


No 170

Mid: Sec:

as Built.

Sp. Hinson.

Indt input No 9339

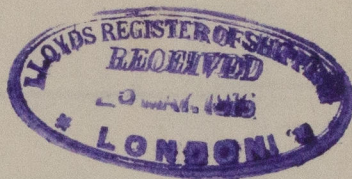

W907-0066



© 2020

Lloyd's Register
Foundation