


— S. S. No 171-183-185-172 —
MIDSHIP SECTION
SCALE 1/2" = 1'
CLASS 100 A.I. FLOORS
STEEL

Messrs Cuning & Co. Ltd
No 183.

Mit: Sec: as built

sp. Fisco.

Mit report 2nd 97#3.

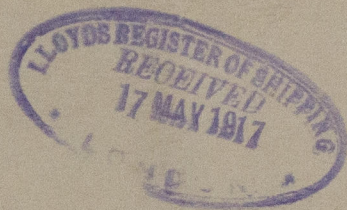

RETAIN



© 2020

Lloyd's Register
Foundation

W907-0080