


8-1-13
4-2-13
17-7-13

10° 11' 11"
S.S. No. 21
Longitudinal and Deck Plan
Mackay Brothers
Drawing Office
21/12
DATE 21/12/12

ELEVATIONS.

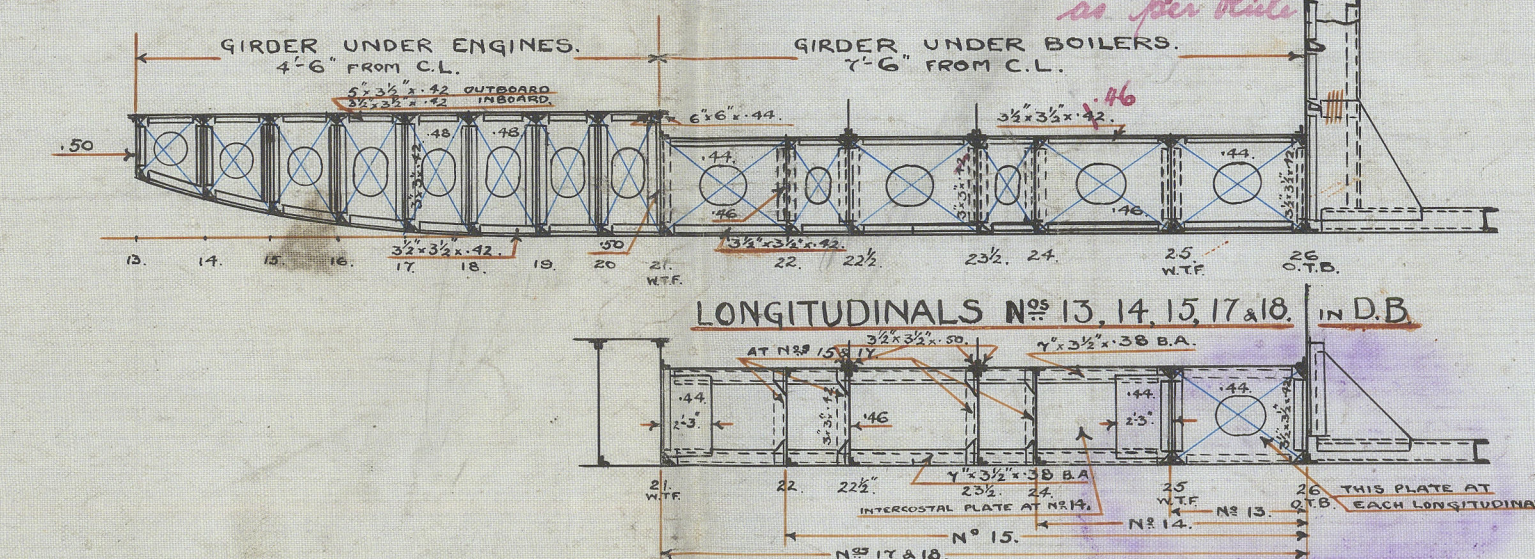

S.S. No. 21.

LONGITUDINAL AND DECK PLAN.



DIMENSIONS:- 325'-0" x 44'-6" x 28'-6" M.B.

SCALE 1/8" = 1 FOOT.

NUMERALS:-

TRANSVERSE No. 73'-0"

LONGITUDINAL No. 2372.5

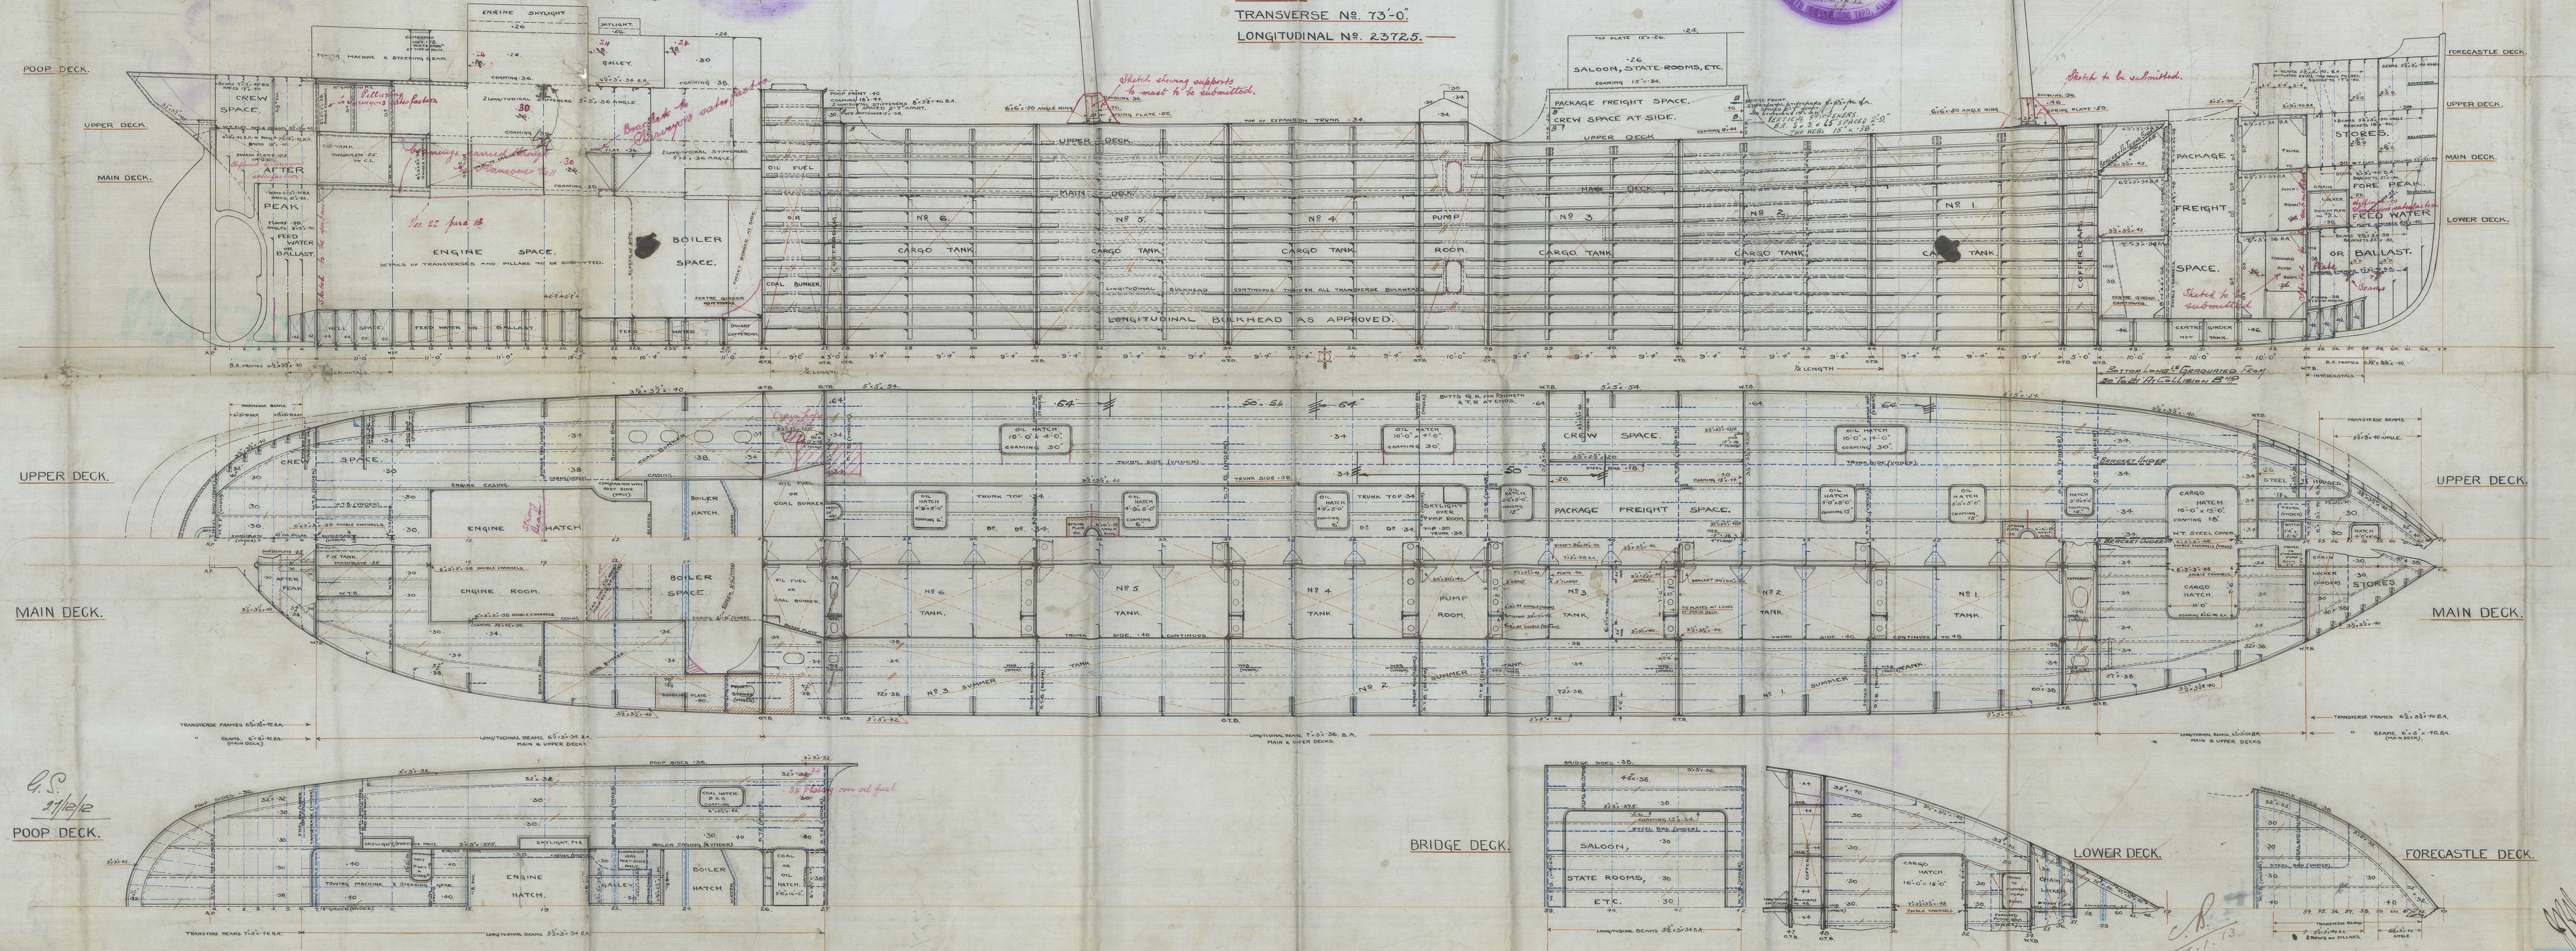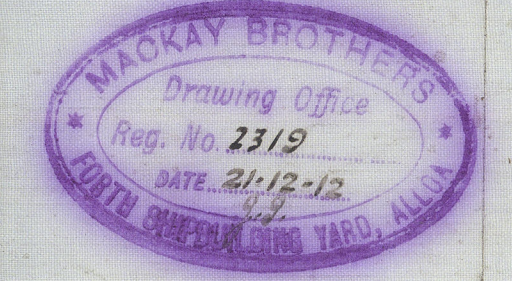

P.O.
21/12/12
POOP DECK.

BRIDGE DECK.



LOWER DECK.

FORECASTLE DECK.

S. S. No 21
(Carrying Oil in Bulk)
Profile Plan

Messrs Mackay Bros
Alloa

Ch. Inpion
Lh 14798.

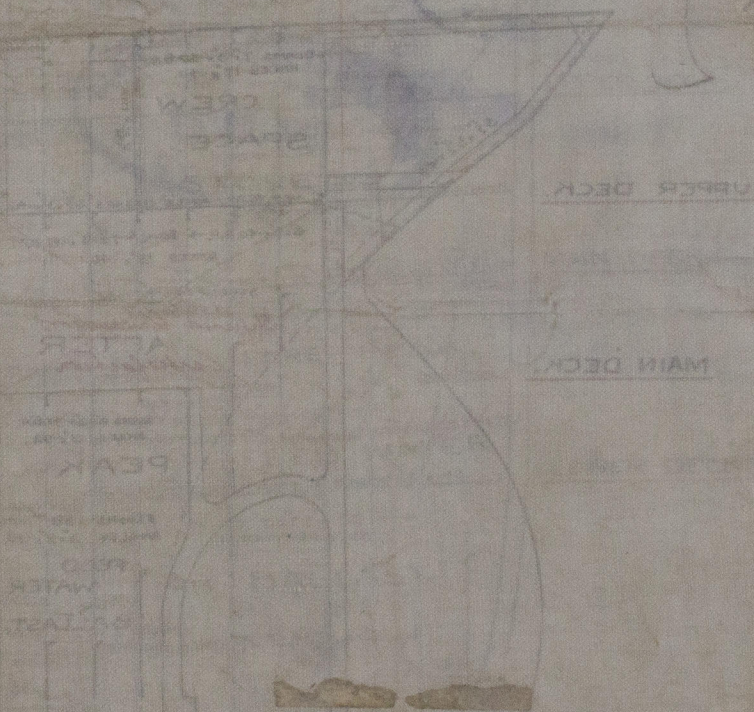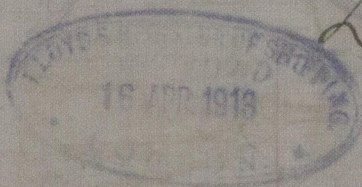

© 2020

Lloyd's Register
Foundation

W912-0146