

MIDSHIP SECTION.

LENGTH BP 350'0" BREADTH EX 51'0 1/2" DEPTH MLD 26'3".


SCALE 1/2" = ONE FOOT.

CLASS 100.A.1 AT LLOYDS.

SHELTER DECK.

FORECASTLE DECK = 32'6" x 7'6" ✓
FORECASTLE DECK BEAMS (SEE PROFILE) ✓
BEAM KNEES = 20" x 40" x 5" x 3/4" RIVETS ✓
STRINGER PLATE = 33" x 34" ✓
STRINGER ANGLE = 3 1/2" x 3 1/2" x 34" ✓
STRINGER BUTTS DOUBLE RIVETED OVERLAPS ✓
STEEL DECK (WOOD STRENGTH) = 25" ✓
SIDE PLATING = 40" DOUBLE RIV OVERLAPS ✓
STANCHION 2 FRAMES APART = 2 1/2" DIAM. ✓

SHELTER DECK STRINGER 50" x 52" FOR 1/2 LENGTH TO 33" x 42" ✓
BUTTS TREBLE RIVETED THROUGHOUT ✓
STEEL DECK 34" TO 32" ✓
HATCH CORNERS DOUBLED ✓
STRINGER ANGLE 4 1/2" x 4 1/2" x 50" TO 3 1/2" x 3 1/2" x 42" ✓

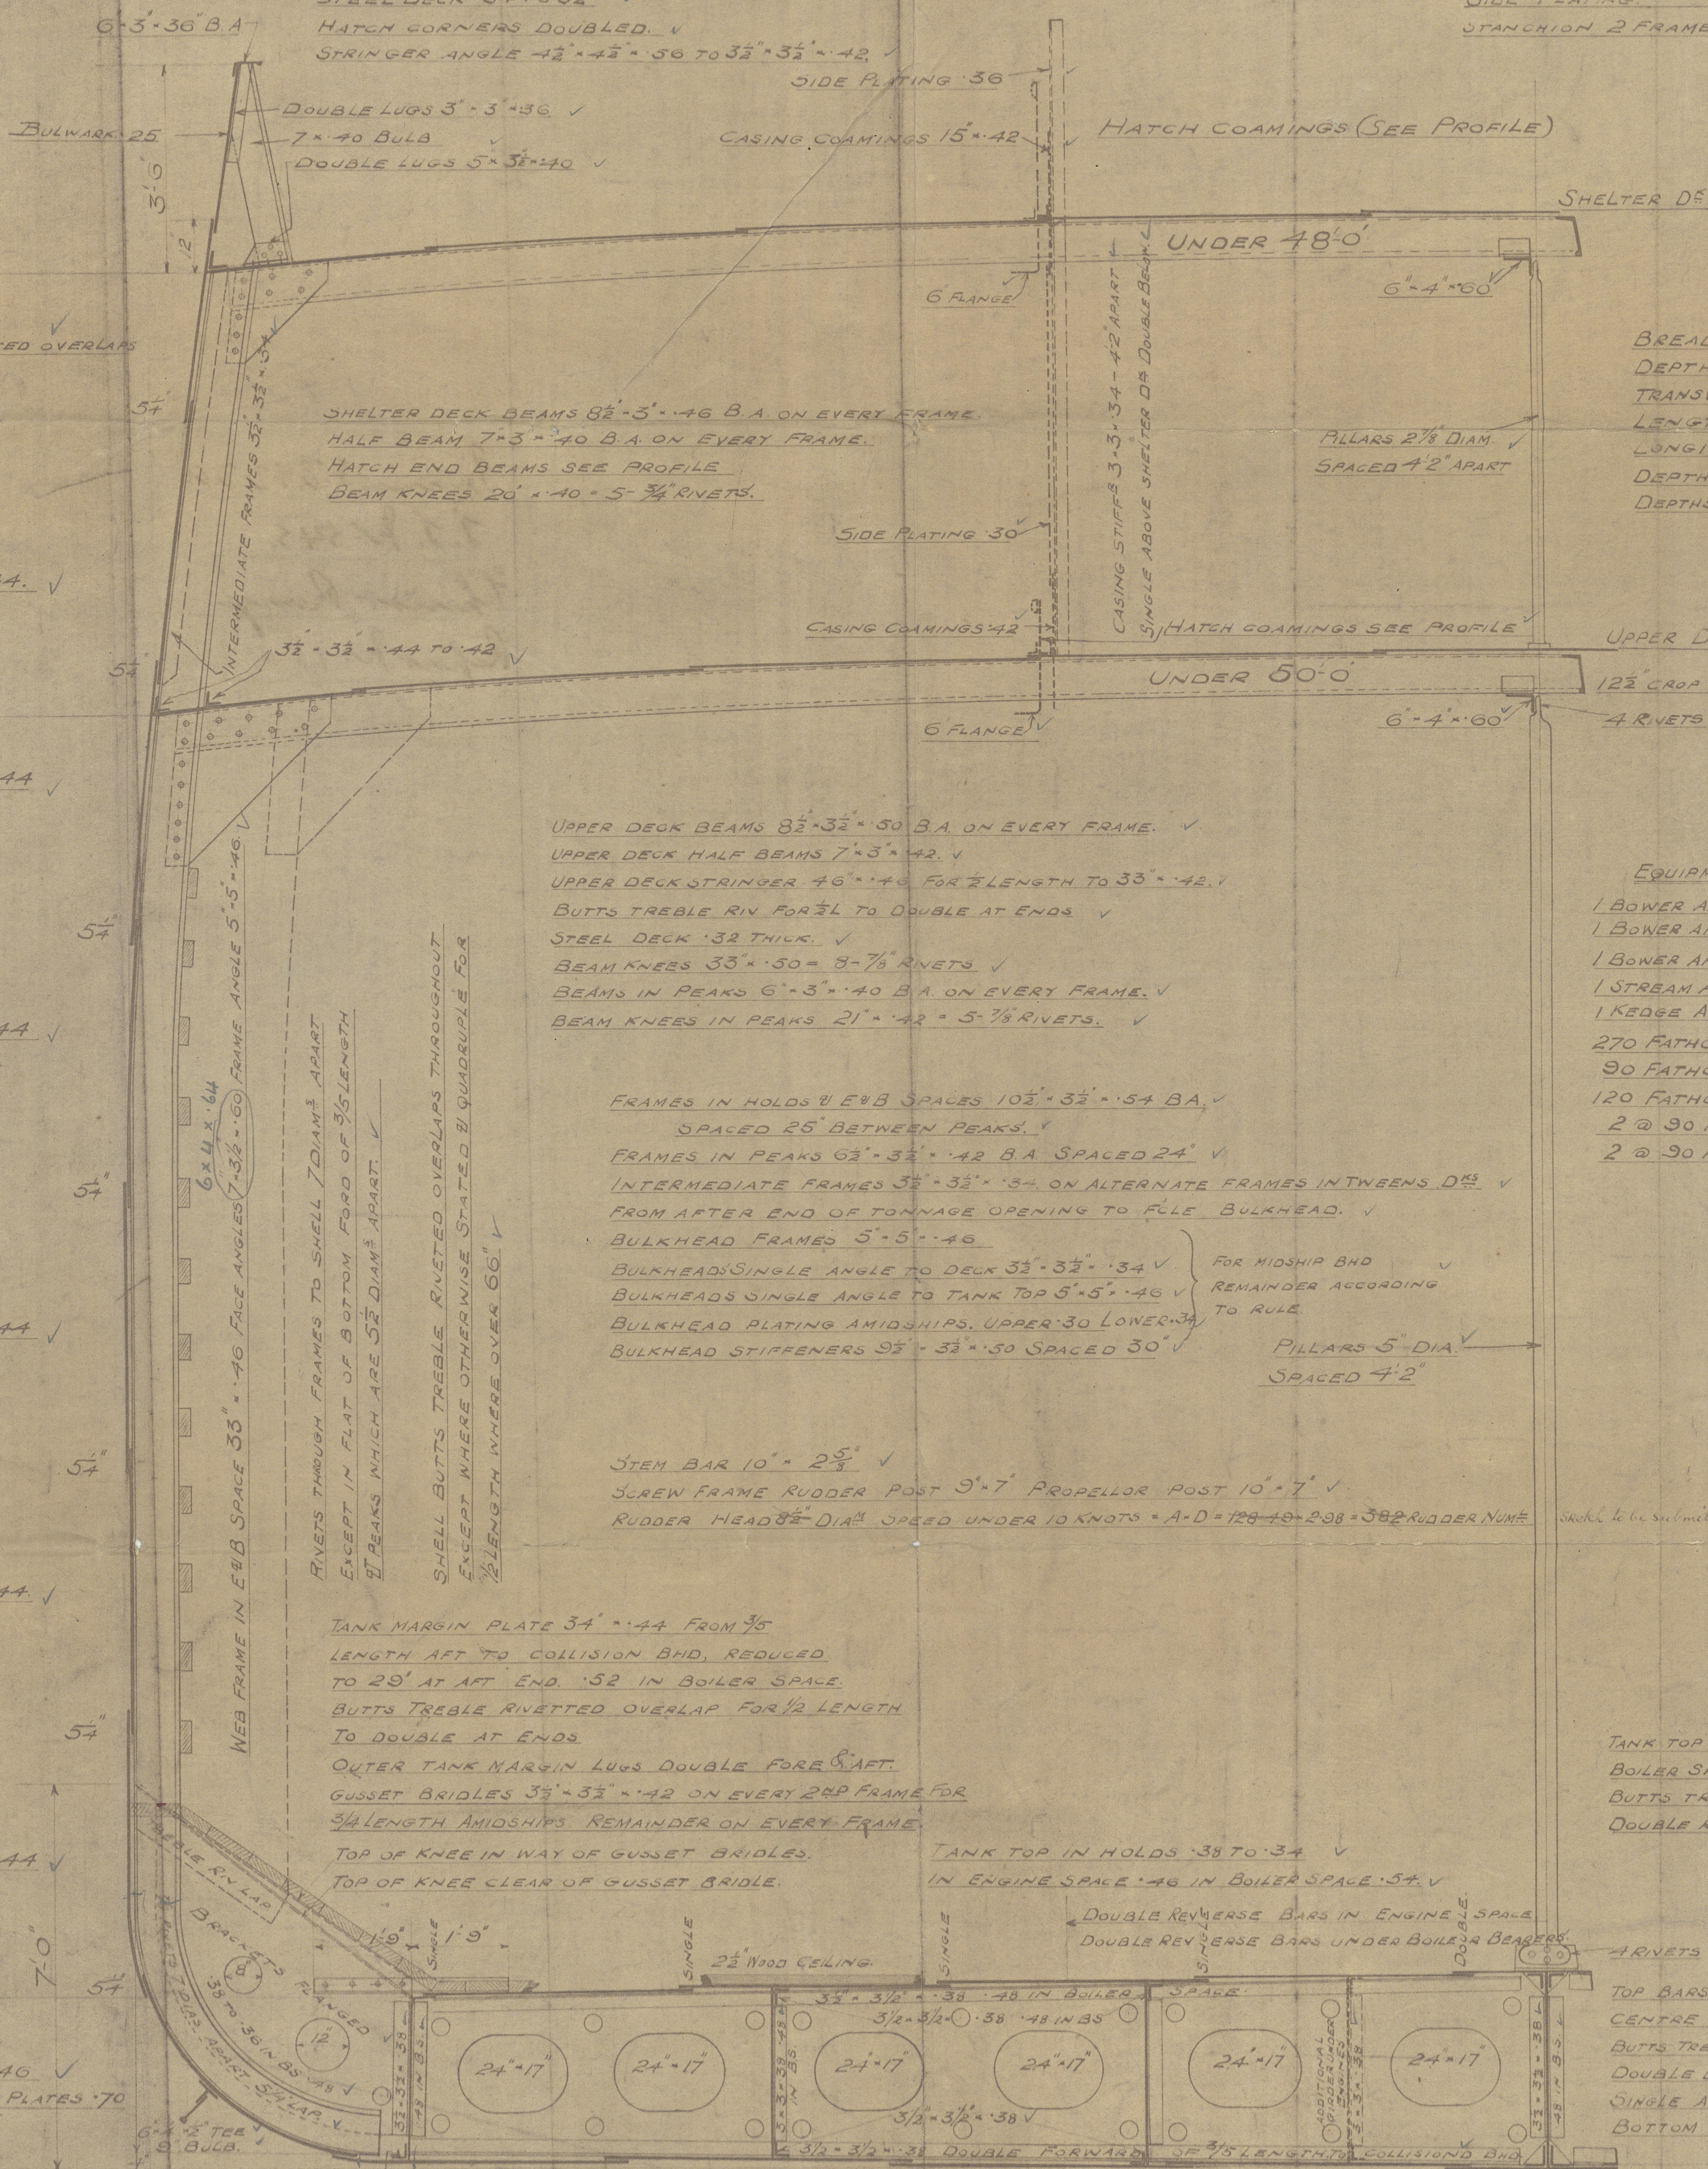

LLOYDS NUMERALS

BREADTH MOULDED 50.83 ✓
DEPTH MOULDED 26.25 ✓
TRANSVERSE NUMBER 77.05 ✓
LENGTH B.P. 350.00 ✓
LONGITUDINAL NUMBER 26978.00 ✓
DEPTHS IN LENGTH TO UPPER DECK 15.35 ✓
DEPTHS IN LENGTH TO SHELTER DECK 10.22 ✓

EQUIPMENT NR = 29464

1 BOWER ANCHOR STOCKLESS 52 1/2 CENTS ✓
1 BOWER ANCHOR STOCKLESS 52 CENTS ✓
1 BOWER ANCHOR STOCKLESS 45 CENTS ✓
1 STREAM ANCHOR EX STOCK 14 CENTS ✓
1 KEDGE ANCHOR EX STOCK 6 CENTS ✓
270 FATHOMS 2 1/8" STUD CHAIN CABLE ✓
90 FATHOMS 1 7/16" STREAM OR 4 1/2" STEEL WIRE ✓
120 FATHOMS 4 1/2" STEEL WIRE TOW LINE ✓
2 @ 90 FATHOMS 7" WARR MANILLA ✓
2 @ 90 FATHOMS 7" HANSEN MANILLA ✓

Nos 542 & 3.

IRVINE'S
SHIP BUILDING
AND
DRY DOCKS CO LTD
WEST HARTLEPOOL

Irvine: S.B. & D.D.C.

T. I. No. 543.


"Cheviot Range"

Rept. No. 15012.

Midship Section.

RETAIN

RETAIN

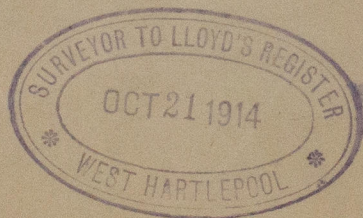

W919 - 0161



© 2020

Lloyd's Register
Foundation