

S. S. "TRELAWNY."

MIDSHIP SECTION.

CLASS LLOYDS 100 A.I.

LLOYDS EQUIPMENT N° 37,269.


FORECASTLE SCANTLINGS.
SIDE PLATING .42"
STRINGER ANGLE $3\frac{1}{2} \times 3\frac{1}{2} \times 36$
STRINGER PLATE .36"
DECK PLATING .34"
BEAMS $9 \times 3 \times 40$ B.A. ON ALTERNATE FRAMES.

DIMENSIONS :- 405'-0" B.P. x 54'-6" B.M.D. x 27'-8" D.M.D. TO SECOND DK.
x 36'-2" D.M.D. TO UPPER DK.

SCALE $\frac{1}{2}$ " = 1 FOOT.

ERECTIONS :- COMPLETE SHELTER DECK WITH ONE TONNAGE OPENING.

EQUIPMENT
2 BOWER ANCHORS EACH $63\frac{1}{2}$ CWTs. STOCKLESS.
1 BOWER ANCHOR $54\frac{1}{2}$ " " "
1 STREAM ANCHOR $17\frac{1}{2}$ " " " Ex - STOCK
270 FATHOMS $2\frac{1}{16}$ STUD CHAIN CABLE
2 AT 45 FMS. $4\frac{1}{2}$ STREAM STEEL WIRE.
1 AT 120 " 5" STEEL WIRE TOWLINE.
4 AT 90 " 3" STEEL WIRE
6 AT 90 " 8" MANILLA } WARPS.

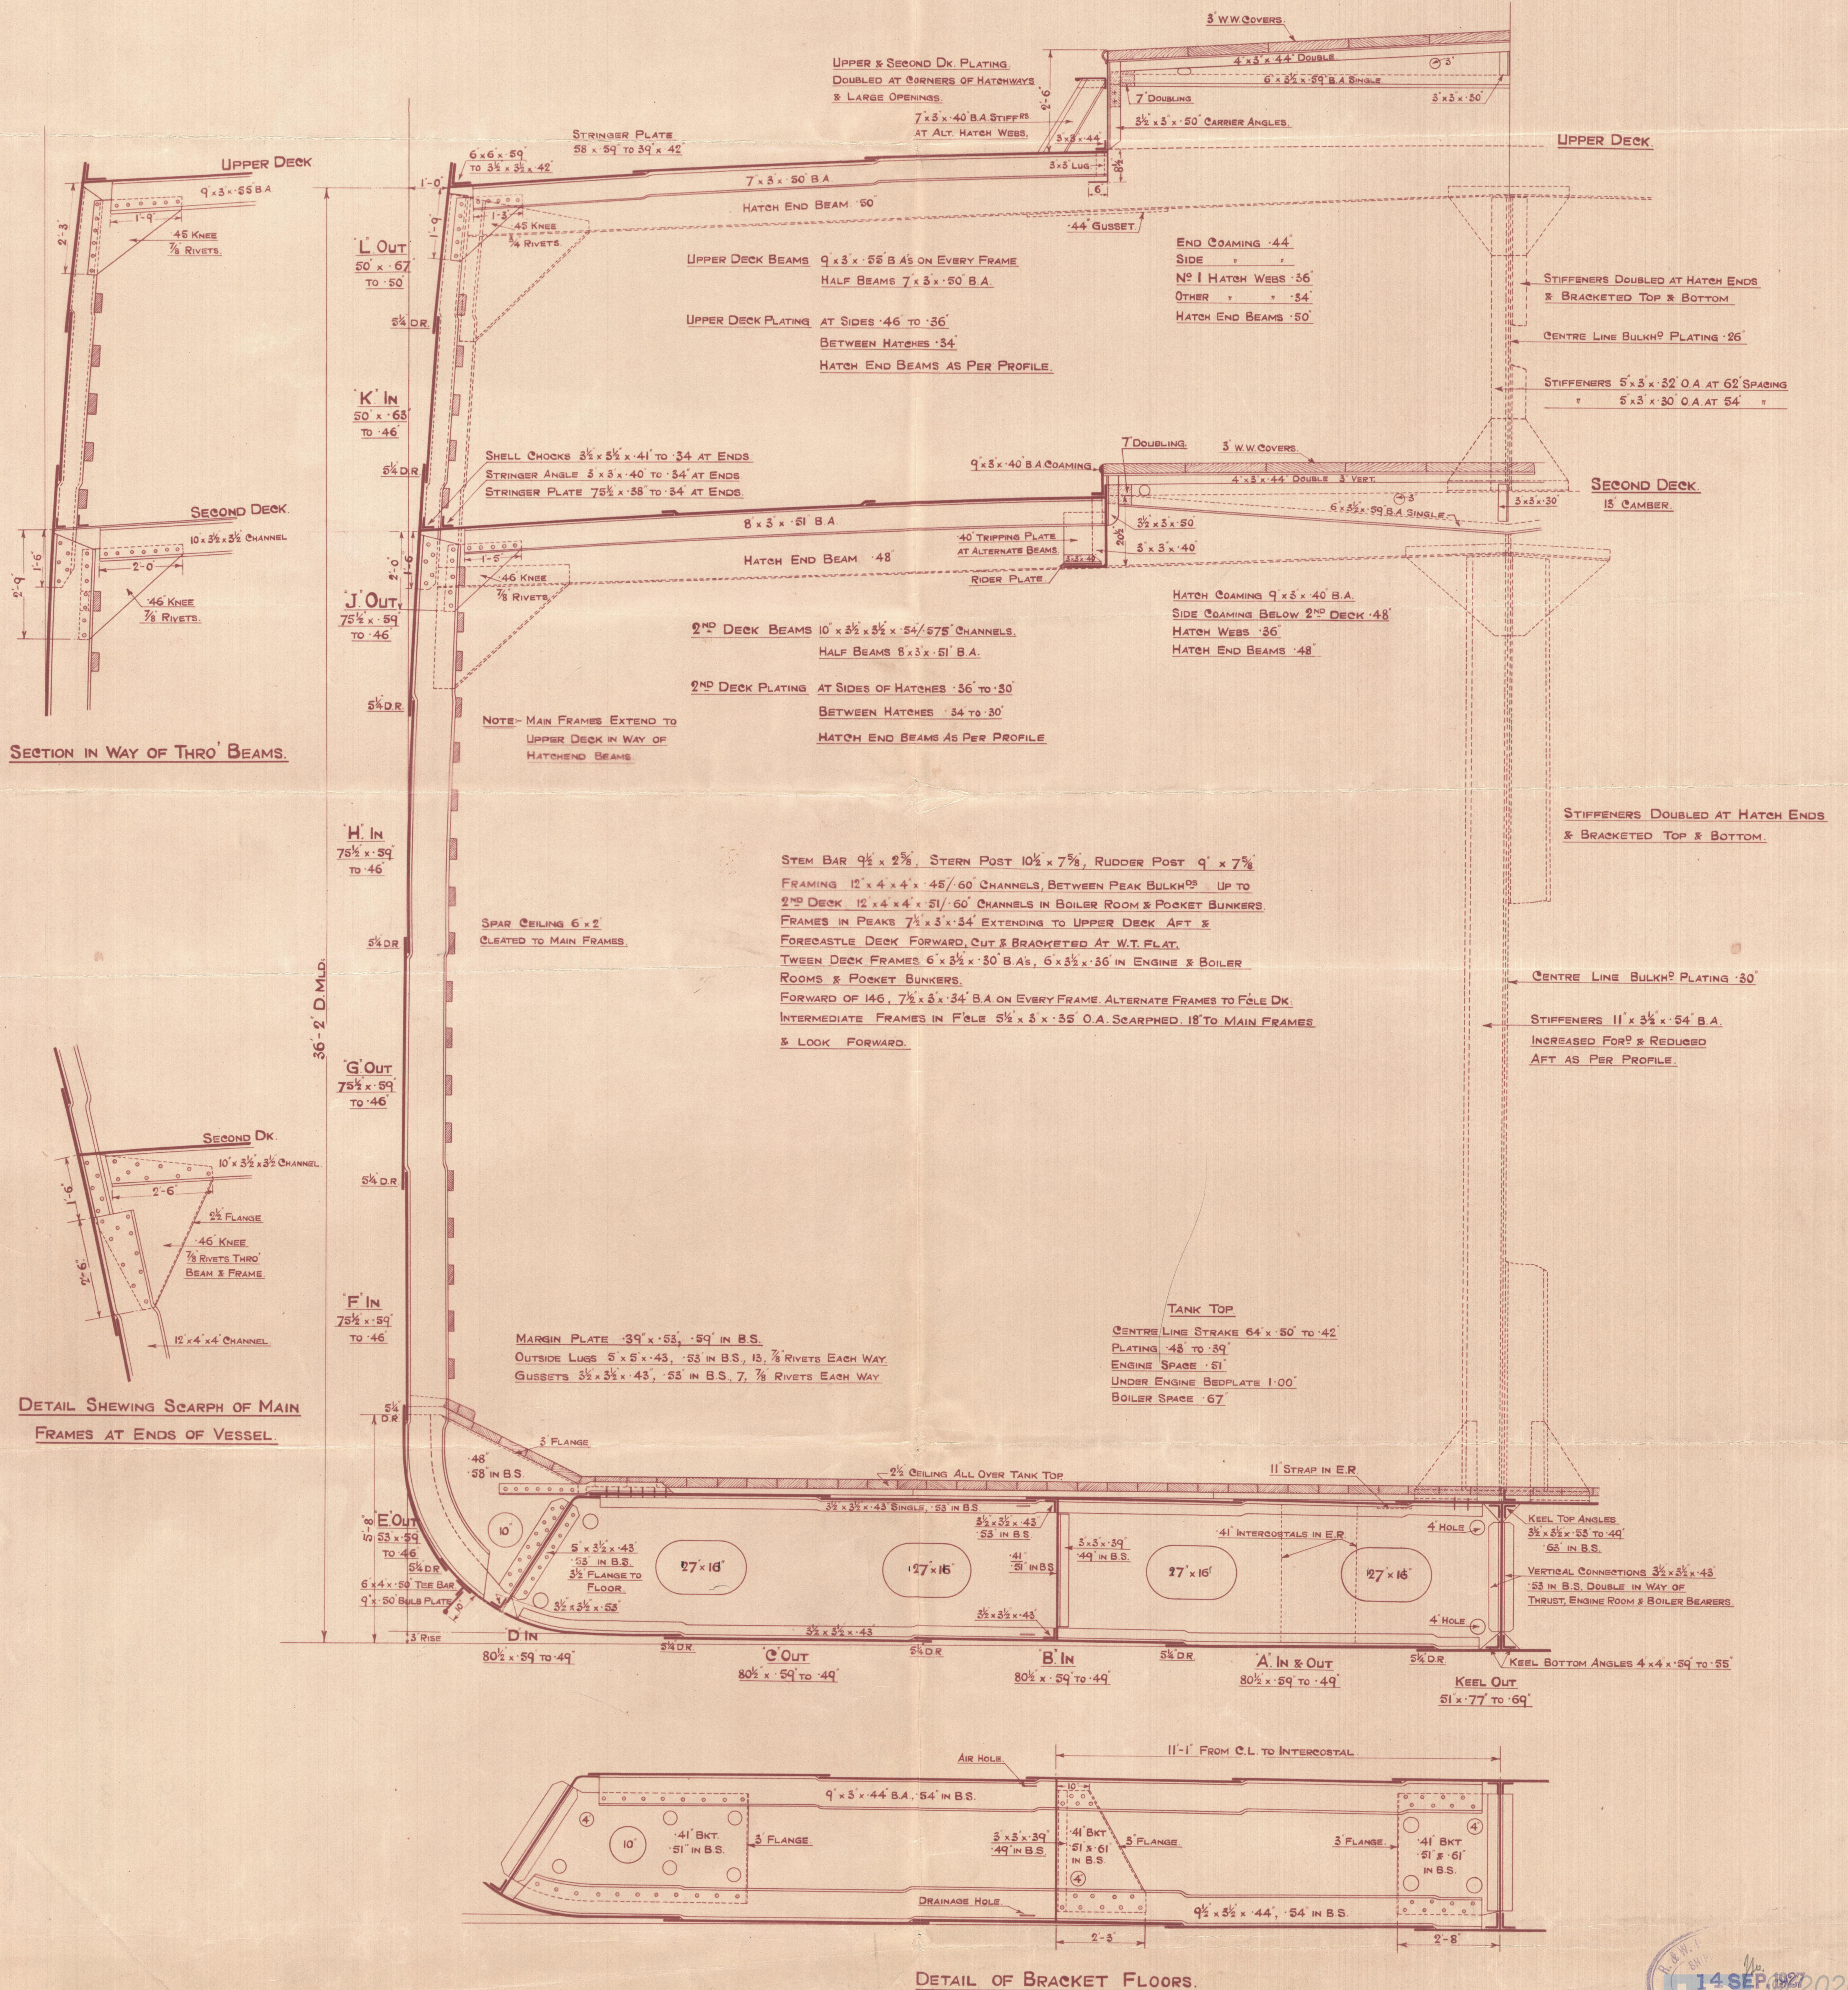

Hawthorn Leslie

346

"TRELAWNY"

Mid-Section (vessel as built)

S. S. "TRELAWNY"

NEWCASTLE ON TYNE.

Report No. 81827.

W92-0040



© 2020

Lloyd's Register
Foundation

ENCLOSURE TO

Mr Brown & Co

31/02832.

FROM R. & W. HAWTHORN, LESLIE & CO. LTD.,
HEBBURN-ON-TYNE.

W 92-0040