

 — de la légende et de la chute
 — de la belle robe et rangs de
 — du pont suspendu à 2 rangs
 — d' — principal —
 — Bordé du château à 2 rangs
 — de la légende et de la chute
 — au belle robe et à 2 rangs
 — du pont suspendu à 2 rangs
 — du pont principal —

Diamètre des trous

		Chateau	Longue Dunette	Chateau	Grand Joli	Grand Joli
Loulouard	M	24 ⁱⁿ	20	24	24	24
	E			20	20	20
Borde	M	20	16	20	20	20
	E			20	16	16

Bridge	Pump Forecast	Helix OK	Upper D.L.	Man D/H
19" 20	16" 20	19" 20	19" 20	19" 20
		16" 20	16" 20	16" 20
16" 20	12.5" 20	16" 20	16" 20	16" 20
		16" 20	12.5" 20	12.5" 20

Recting of Deck.


Plan de Construction.

Echelle 0,01 % $\frac{1}{100}$ $\frac{1}{100}$ $\frac{1}{100}$

Coupe longitudinale.

Dunette

Bridg
Chateau.

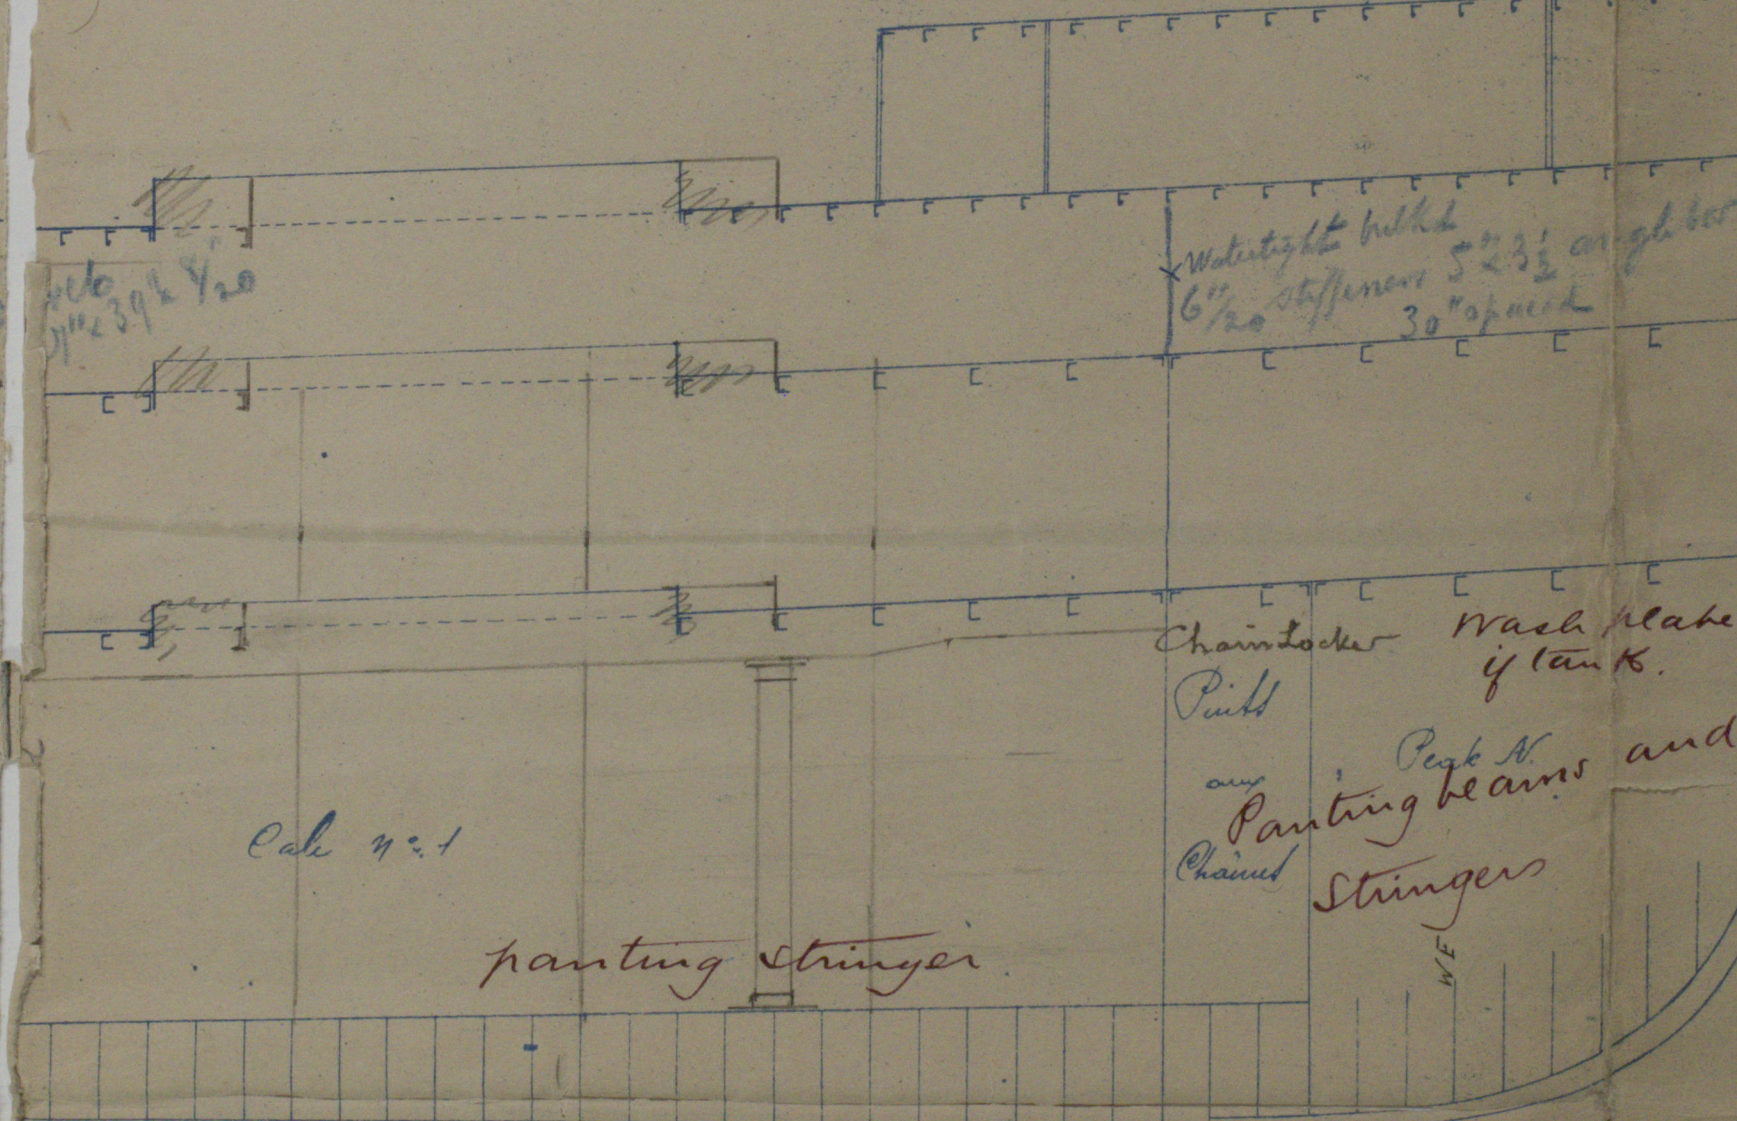
Beams at Hatchway in Shelter Rock

$\begin{array}{l} \wedge \\ 9'' \\ 2' \end{array} \quad \begin{array}{l} \text{Post} \times 12 \\ \text{Plate} \\ \text{Post} \times 12 \\ \text{L} \end{array} \quad \begin{array}{l} 5' \frac{3}{4} \times 5' \frac{3}{4} \times 9' \frac{5}{8} \\ \frac{20}{20} \\ 3' \frac{3}{4} \times 3' \frac{3}{4} \times 9' \frac{5}{8} \\ \frac{20}{20} \end{array}$

Upper Deck
Pont Supérieur.

Main Deck
Pont Principal.

beams to be fitted to every frame abreast openings as per Sec 23, par 44
or deck plating to be of increased thickness as indicated.
beams were fitted at every frame abreast openings.



Zeugue.

CHANTIER DE GRAVILLE. CE 90
INGENIEUR
INGENIEUR EN CHEF
Bois

3

W932-0127

Lloyd

FORGES ET CHANTIERS

de la Méditerranée

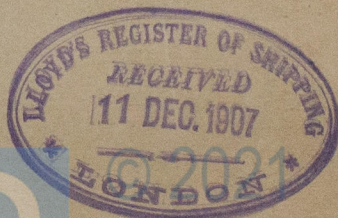
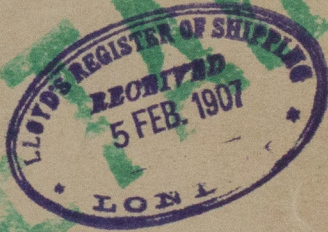
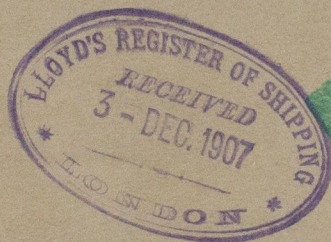
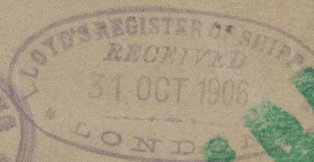
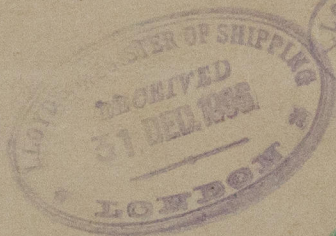
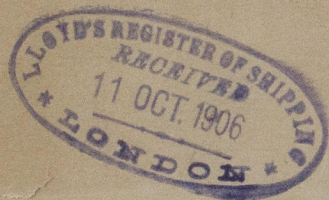
HAVRE

S. S. Colbert

377 feet steamer for Mr. Grosset-Hare

Cargo boat de 7.200 t⁺ p. M^{re} Grosset
Propriété de M. Grosset-Hare

Plan de Construction

Lloyd's Register
Foundation