


No 103.
 4.2.07
 2.3.07.
 24 16.0.07

LLOYD'S REGISTER
 OF SHIPPING.
 8 MAR 1907
 HULL

S. S. No 103.
LONGITUDINAL SECTION.
 SCALE 1/8" = 1 FT.

The Goolie shipbuilding & repairing Co. Ltd.
 Goolie. 20/2/1904.

28 1907
 Goolie

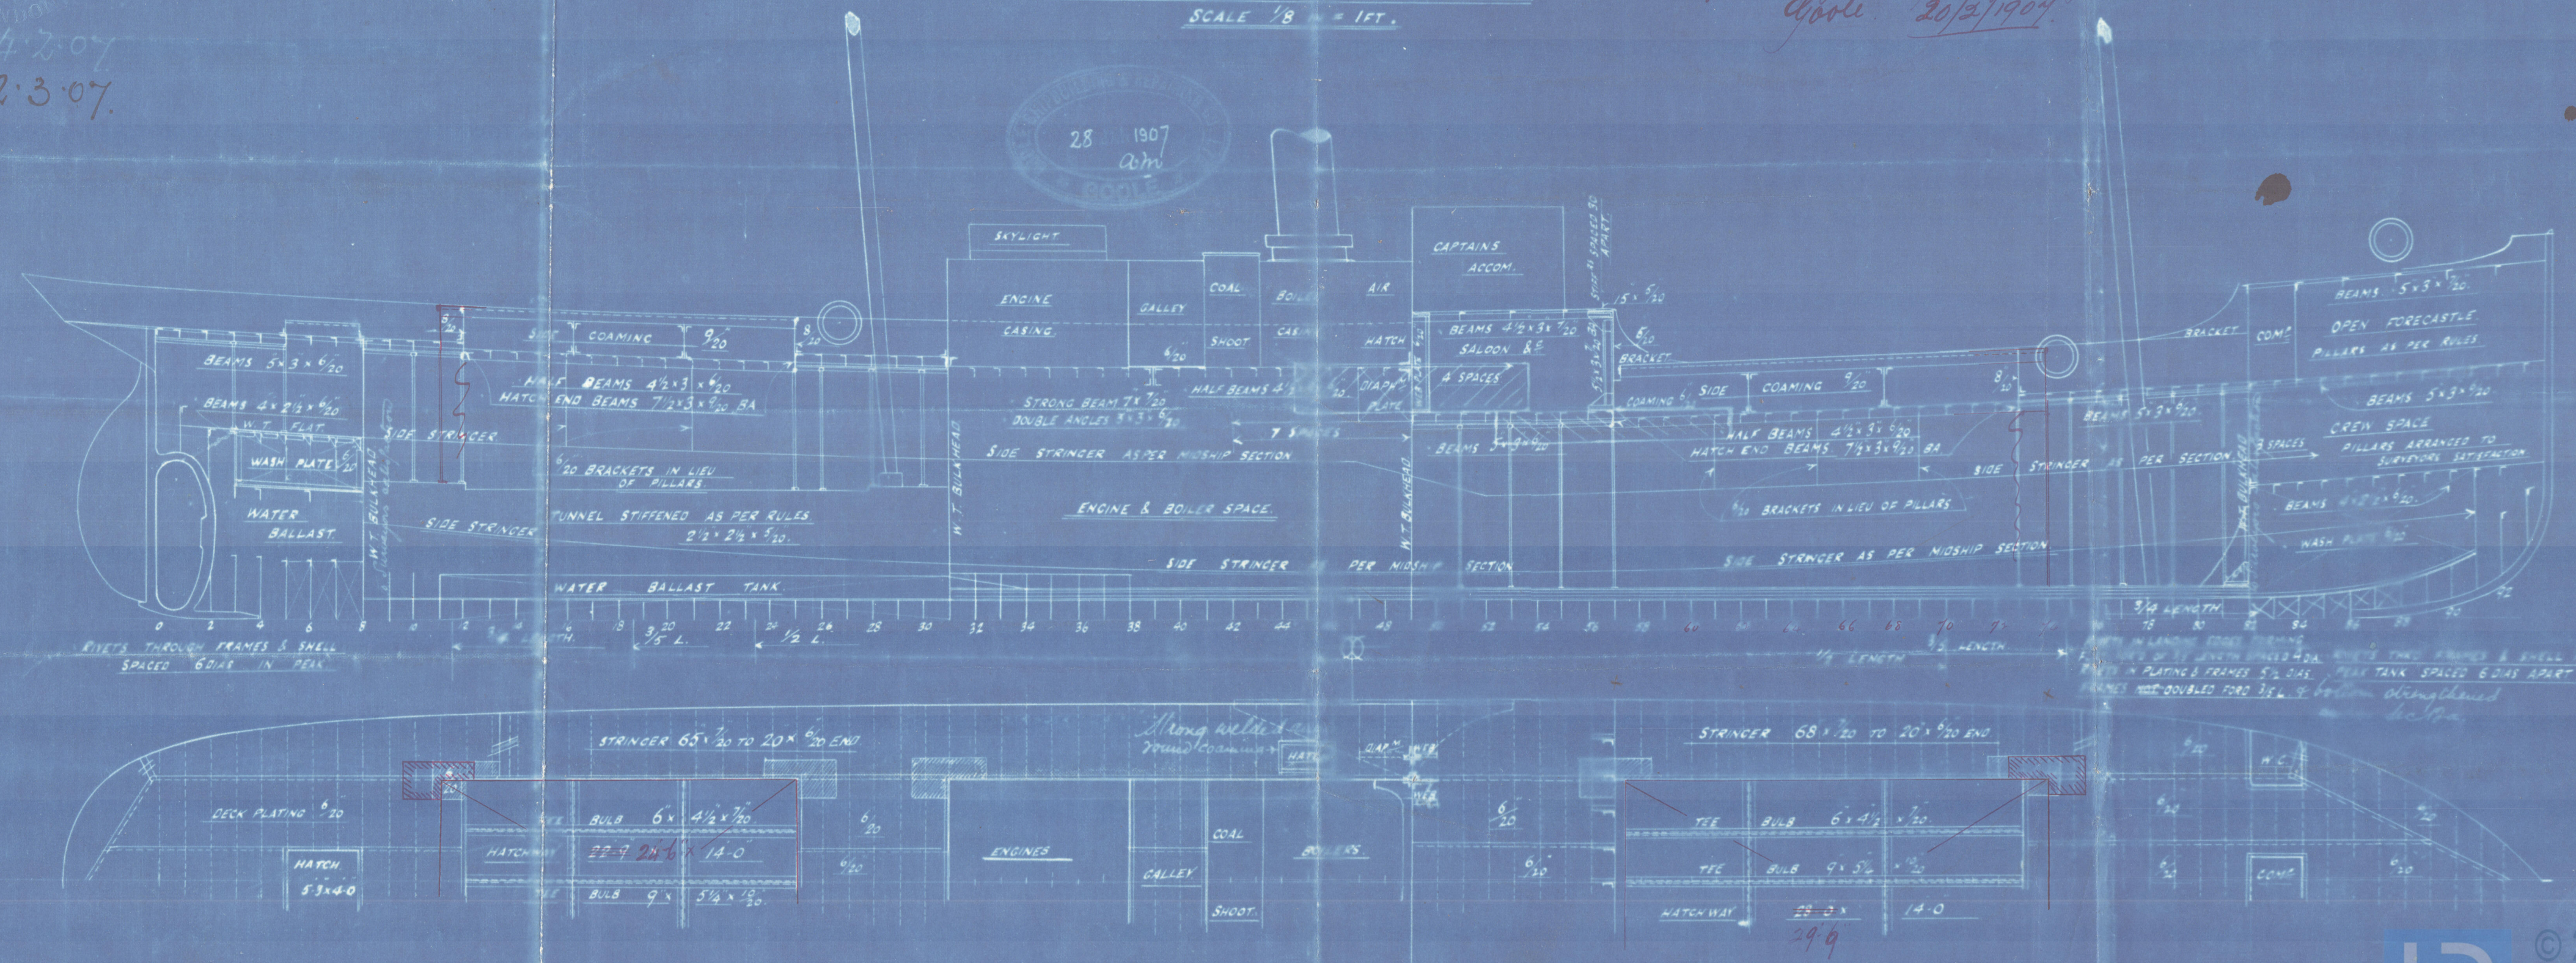


J.H.L.
 12/3/07

Wool S. & R. Co. Lim.

No 103

Amended

Profile + Deck Plans
"Cottingham"
Hull 19899

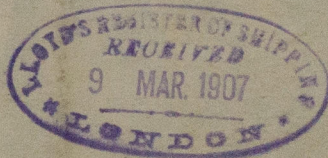

© 2021

Lloyd's Register
Foundation

W440-0032