
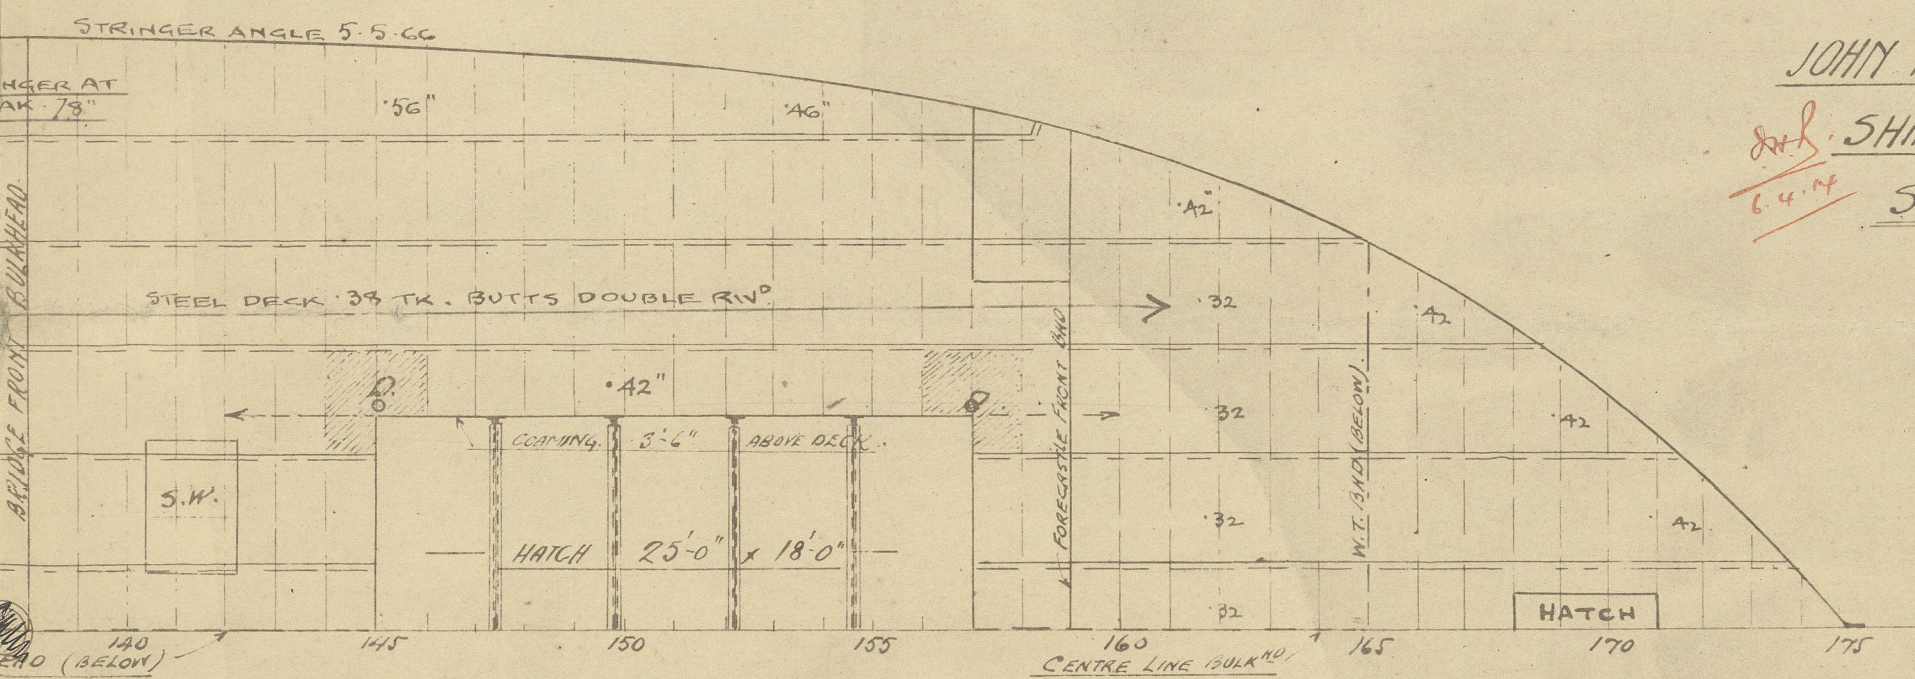
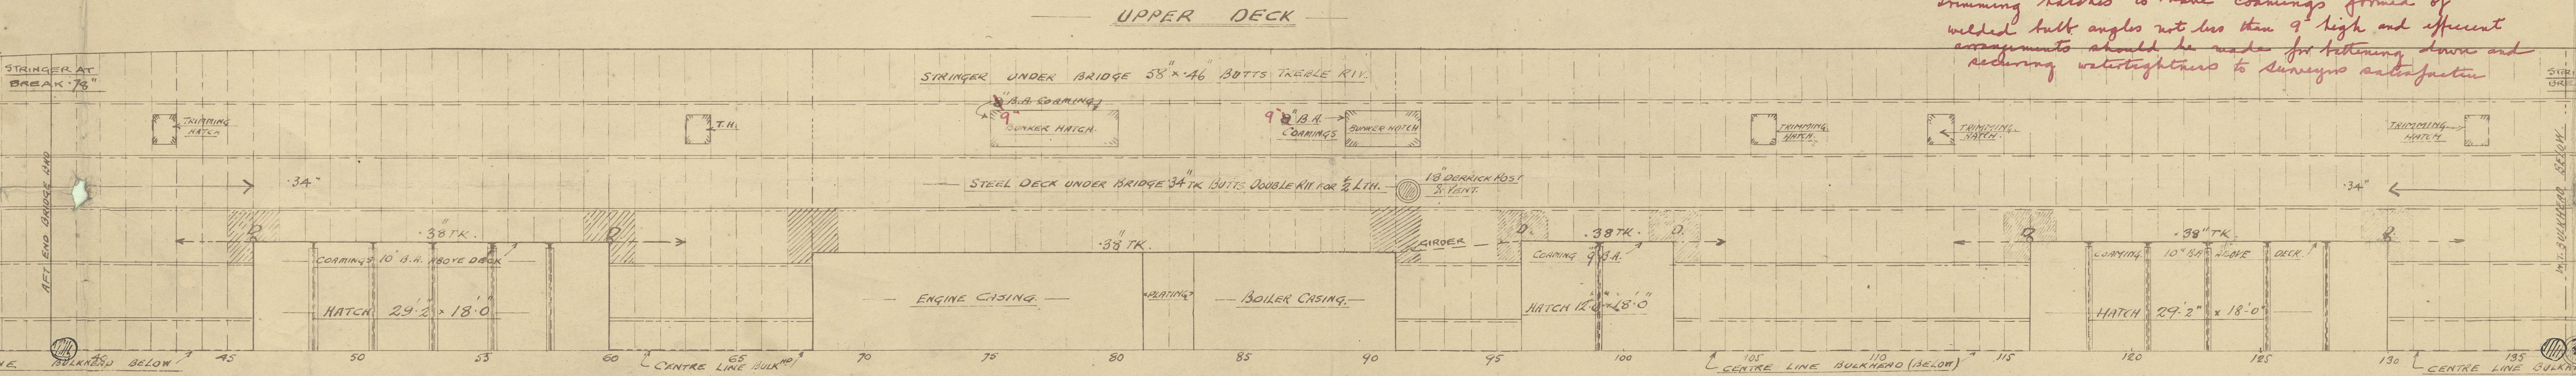
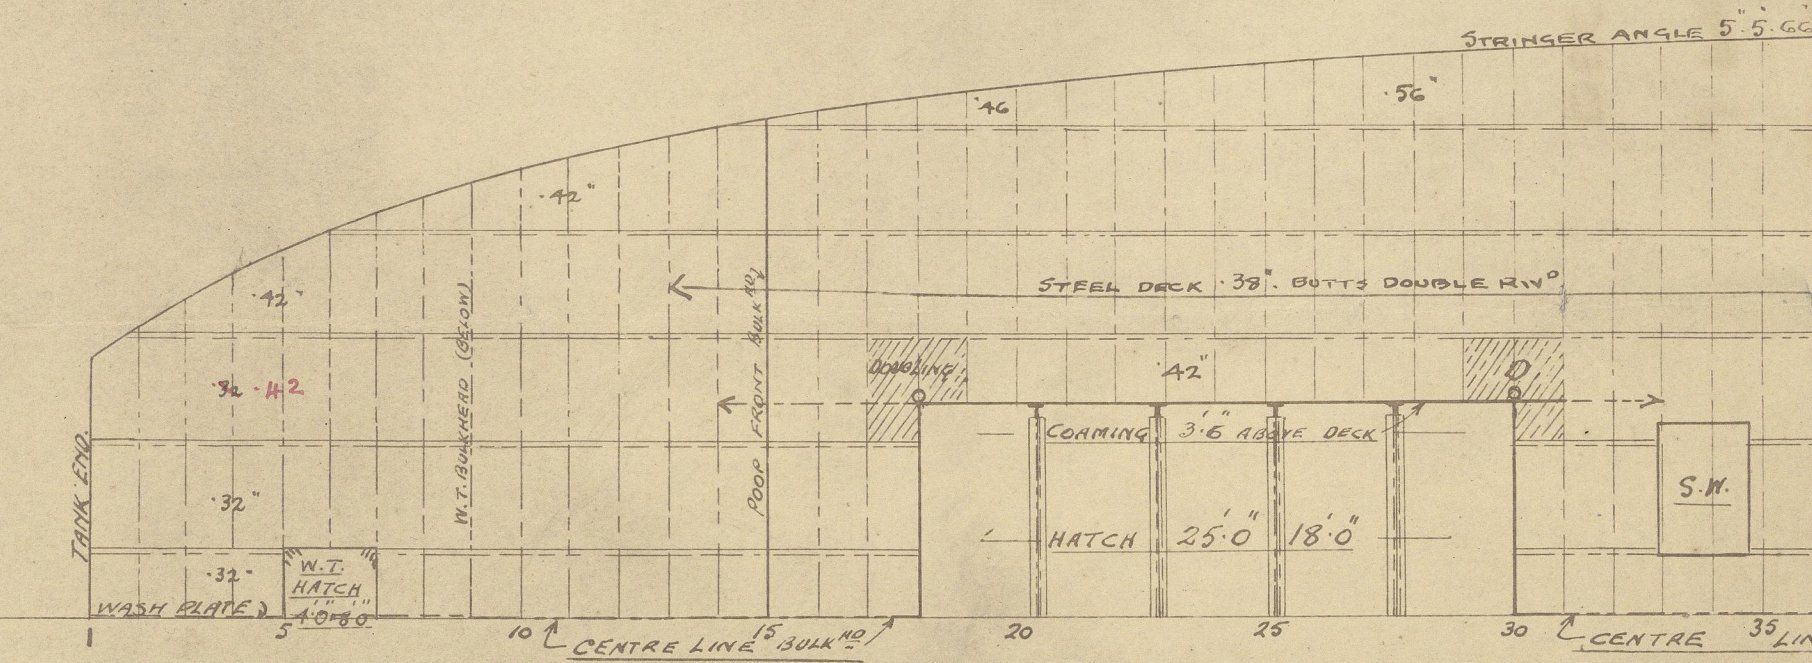
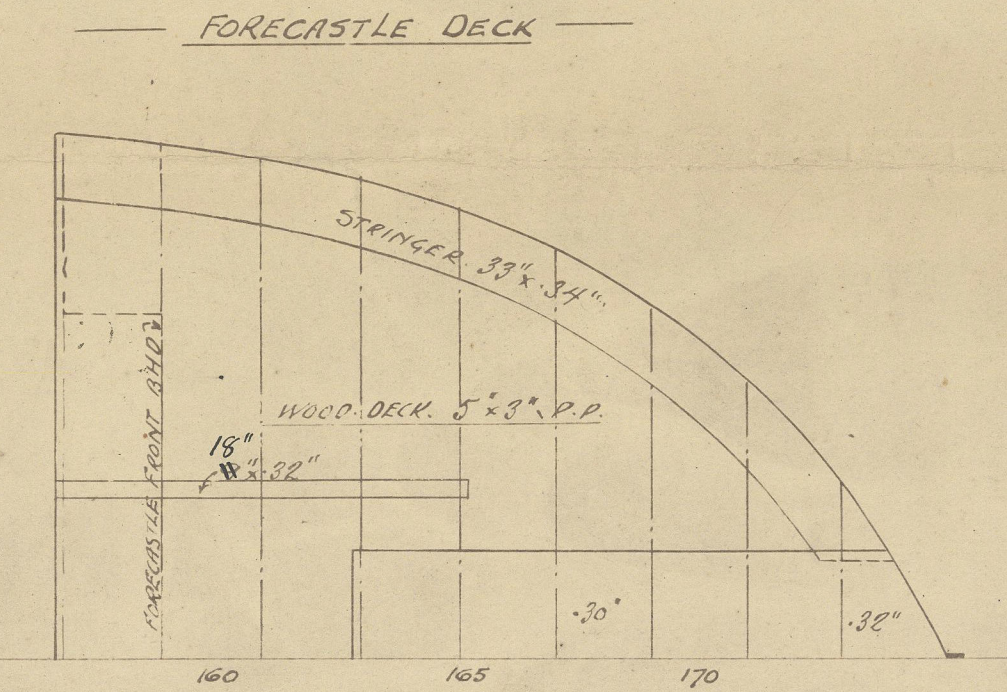
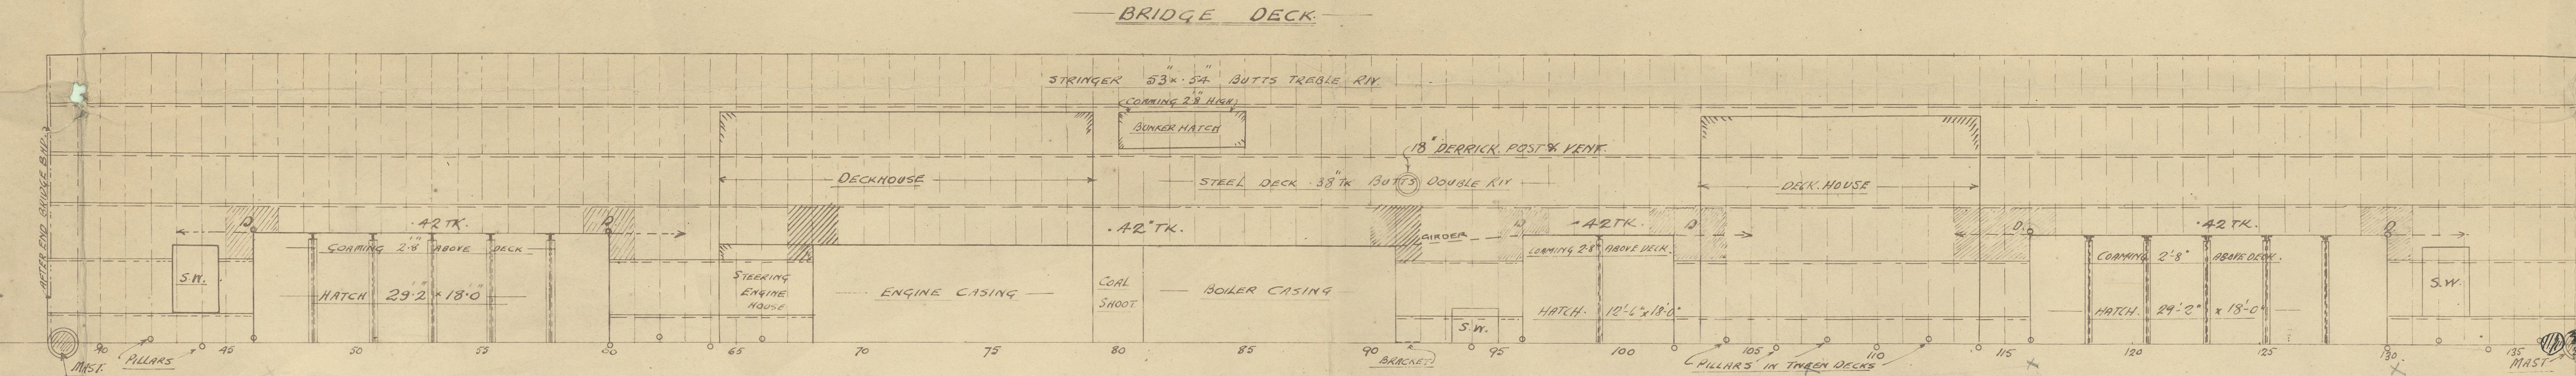


DECK PLANS.

NOS 249 & 250.

SCALE $\frac{1}{8}$ " = ONE FOOT.

9.4.14
22.4.14
6.5.14

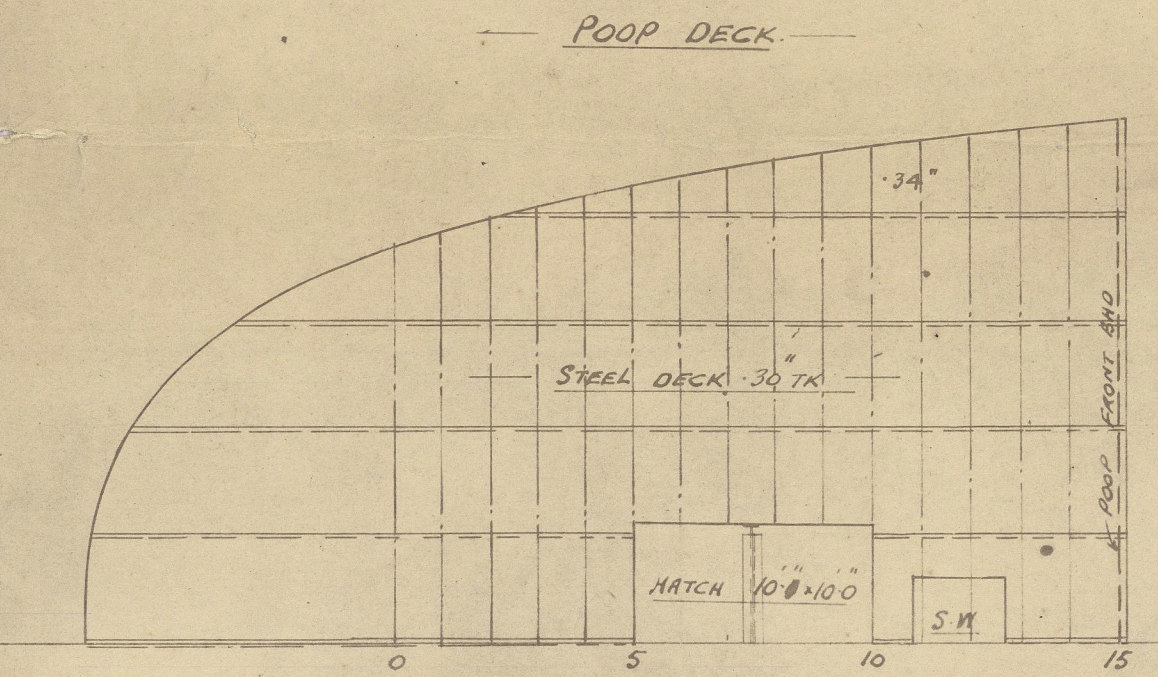

Trimming hatches to have coverings formed of welded bulk angles not less than 9" high and efficient arrangements should be made for bettering down and reducing watertightness to surveyor's satisfaction

JOHN PRIESTMAN & CO
SHIPBUILDERS
SUNDERLAND

9.4.14







W946-0012

N^{os} 249 AND 250


J. PRIESTMAN + C^o

DECK PLANS

N^o 249 S.S. DEVIAN SLD RPT N^o 26340
250 S.S. BISTRITA " " " 26408

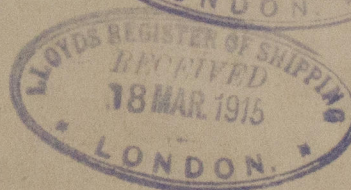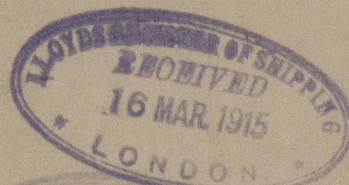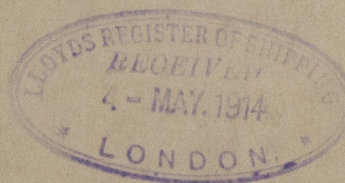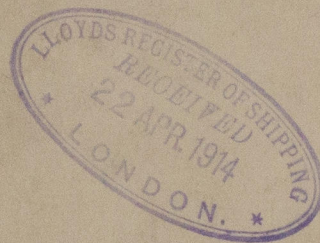

RETAIN

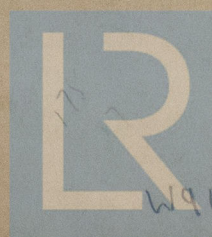

© 2020

Lloyd's Register
Foundation

W946-0012