

MIDSHIP SECTION FOR PROPOSED S.S.

N^{os} 249 & 250.

9.4.14.
22.4.14
6.5.14

SCALE $\frac{1}{2}$ " = ONE FOOT.

DIMENSIONS.

LENGTH B.P. 365'-0"
BREADTH EXT. 51'-6"
DEPTH MLD. 24'-6"


TO CLASS 100-A.1 LLOYDS.

ROOF SCANTLINGS.

BEAMS $6\frac{1}{2} \times 8 \times 40$ B.A. EVERY FRAME IRON OF PILLARS $2\frac{1}{2}$ " DIA.
STRINGER ANGLE $3\frac{1}{2} \times 3\frac{1}{2} \times 34$ STEEL DECK 30×18

DECK SCANTLINGS.

BEAMS $8\frac{1}{2} \times 8\frac{1}{2} \times 40$ ON ALL FRAMES. 2 ROWS. PILLARS $2\frac{1}{2}$ " DIA.
STRINGER ANGLE $3\frac{1}{2} \times 3\frac{1}{2} \times 34$ STRINGER 33×34
WOOD DECK $3\frac{1}{2} \times 8$ R.P. DECK PLATING 40×18

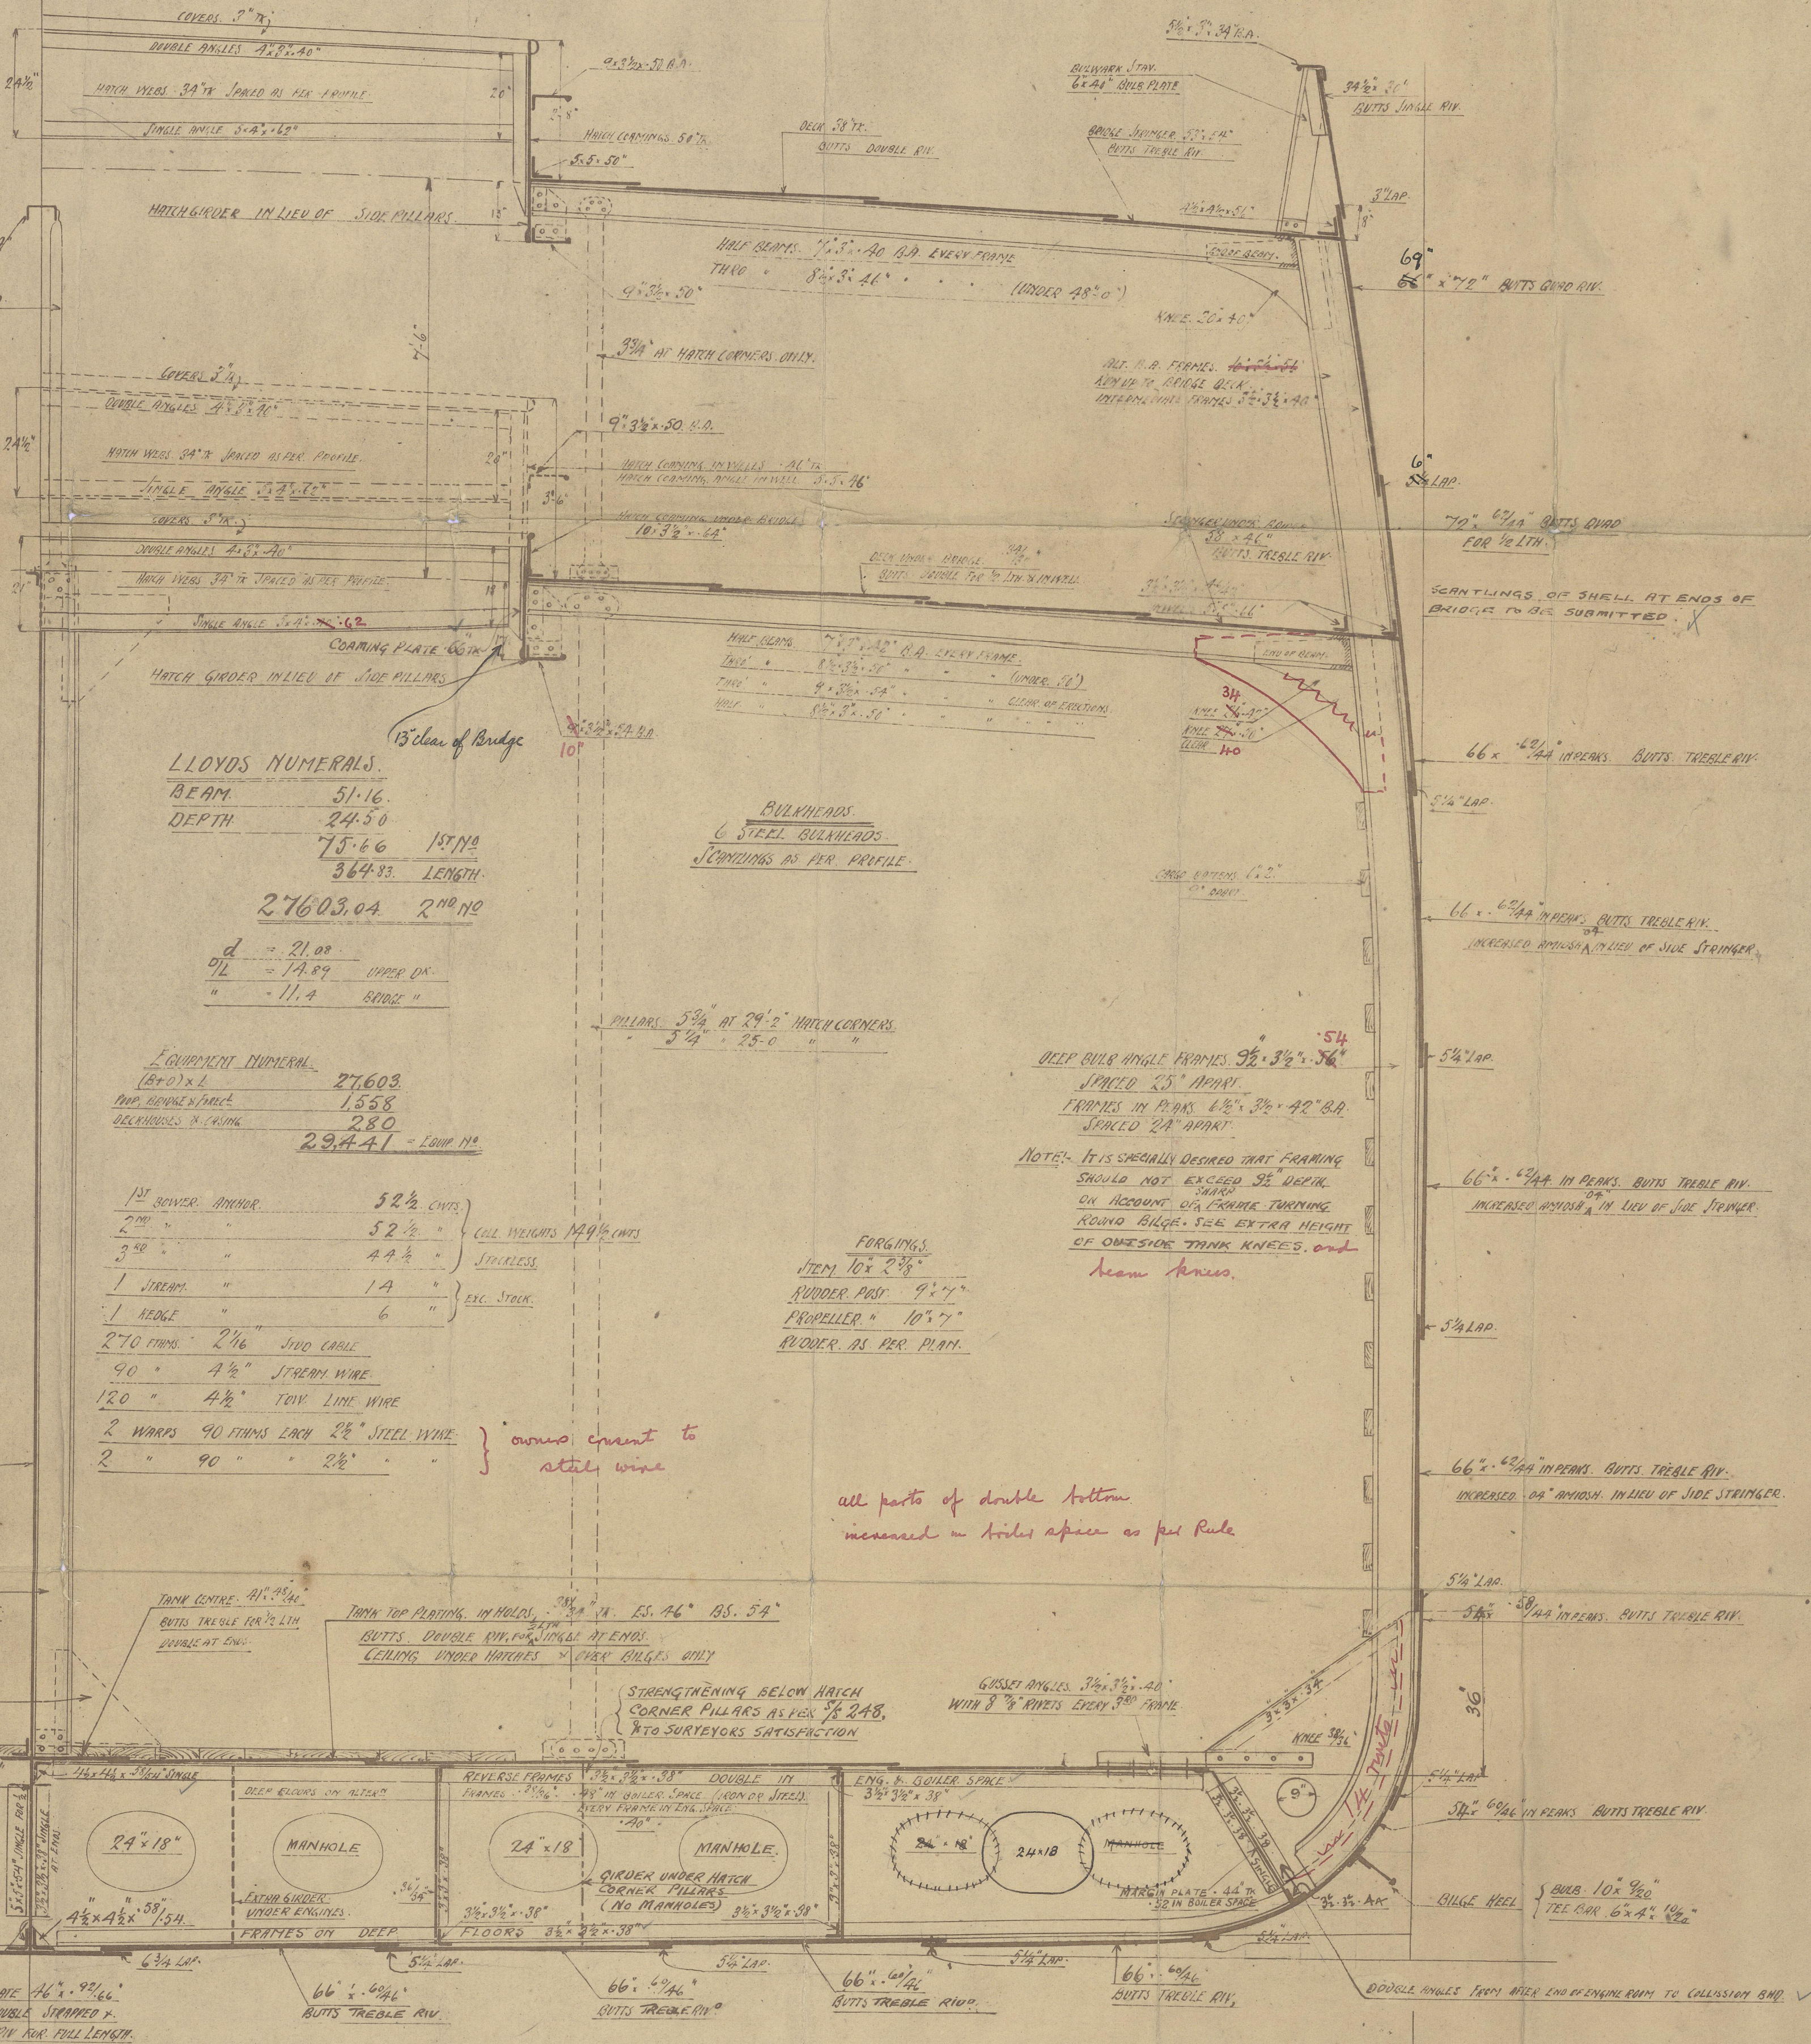

LLOYDS NUMERALS.

BEAM 51.16
DEPTH 24.50
75.66 1ST NO
364.83 LENGTH
27603.04 2ND NO
d = 21.08
92 = 14.89 UPPER DECK
" = 11.4 BRIDGE

EQUIPMENT NUMERAL
(B+O) x L 27603
HULL WEIGHT 1558
DECK WEIGHT 280
29441 = EQUIP W.

1 ST BOWER ANCHOR	52 1/2 CWT	ALL WEIGHTS 1496 CWT
2 ND "	52 1/2 "	
3 RD "	44 1/2 "	
1 STREAM "	1 A "	ECC. STOCK
1 KEDGE "	6 "	
270 FMS. 2 1/2" SWD CABLE		
90 " 4 1/2" STREAM WIRE		
120 " 4 1/2" TOW LINE WIRE		
2 WARPS 90 FMS EACH 2 1/2" STEEL WIRE		
2 " 90 " " 2 1/2" "		

BULKHEADS.

6 STEEL BULKHEADS

SCANTLINGS AS PER PROFILE


DEEP BUILD ANGLE FRAMES $3\frac{1}{2} \times 3\frac{1}{2} \times 36$
SPACED 25" APART
FRAMES IN PEAKS $4\frac{1}{2} \times 3\frac{1}{2} \times 42$ B.A.
SPACED 24" APART

NOTE: IT IS SPECIALLY DESIRED THAT FRAMING
SHOULD NOT EXCEED 3% USED
ON ACCOUNT OF CORRUDE TURNING
ROUND BILGE. SEE EXTRA HEIGHT
OF OUTSIDE TANK KNEES, and
beam knees.

FORGINGS
ITEM 10 x 2 1/2"
RUDDER POST 9' 4"
PROPELLER 10' 7"
RUDDER AS PER PLAN.

all parts of double bottom
measured in holes space as per Rule

SECTION AT INTERMEDIATE FLOORS.

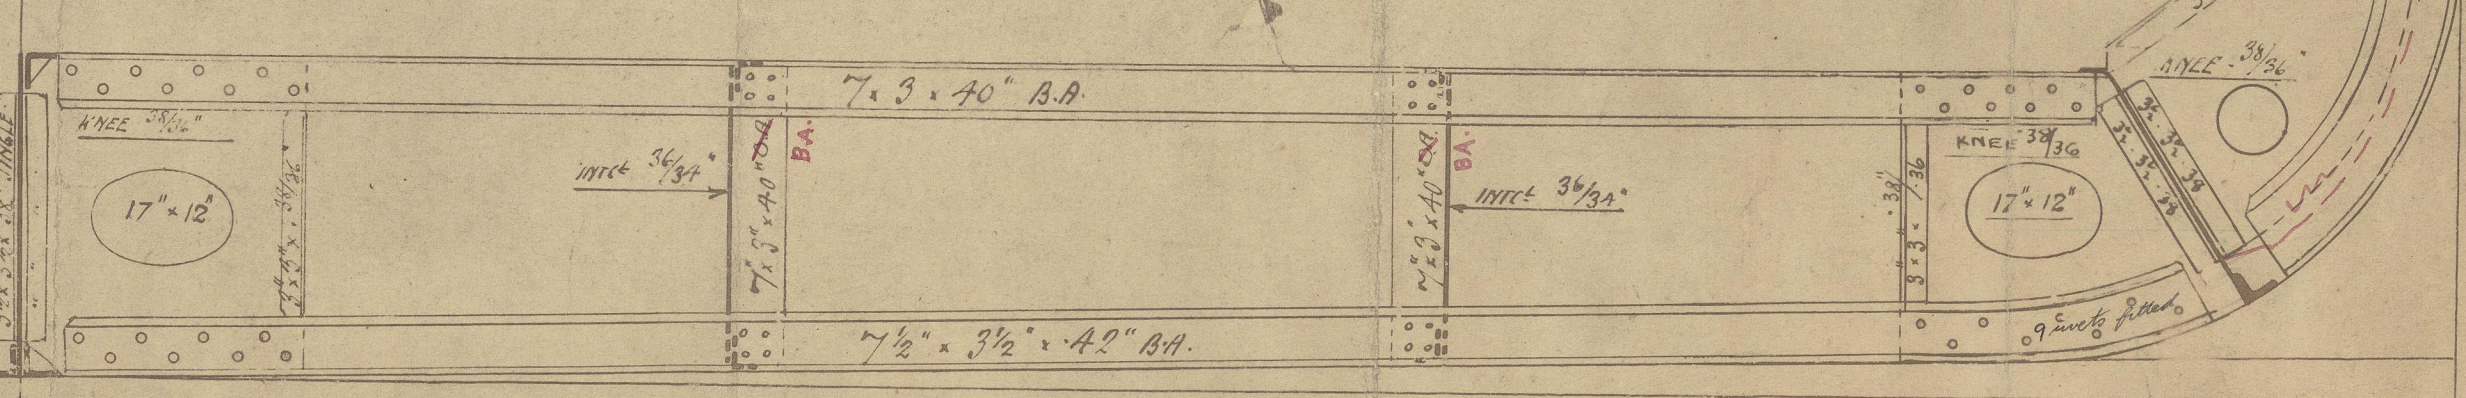

9.4.14



JOHN PRIESTMAN & CO

SHIPBUILDERS.

SUNDERLAND 2020

4946-006



Lloyd's Register Foundation

RETURN



Nos 249 AND 250

J. PRIESTMAN + Co

MIDSHIP SECTION.

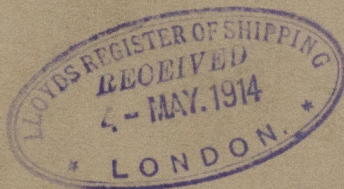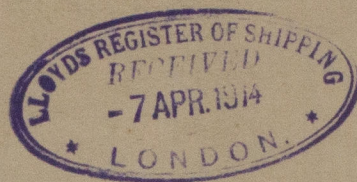

Nº 249 S.S. DEVIAN SLO RPT Nº 26340
250 S.S. BISTRITA " " " 26408

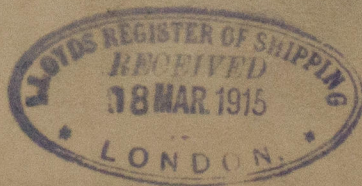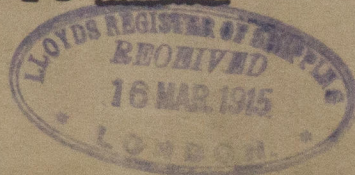

© 2020

Lloyd's Register
Foundation

W9x6 - 0015