


S.S. Dartmeet.


Sketch showing position of Donkey Boilers in Reels.

Plan

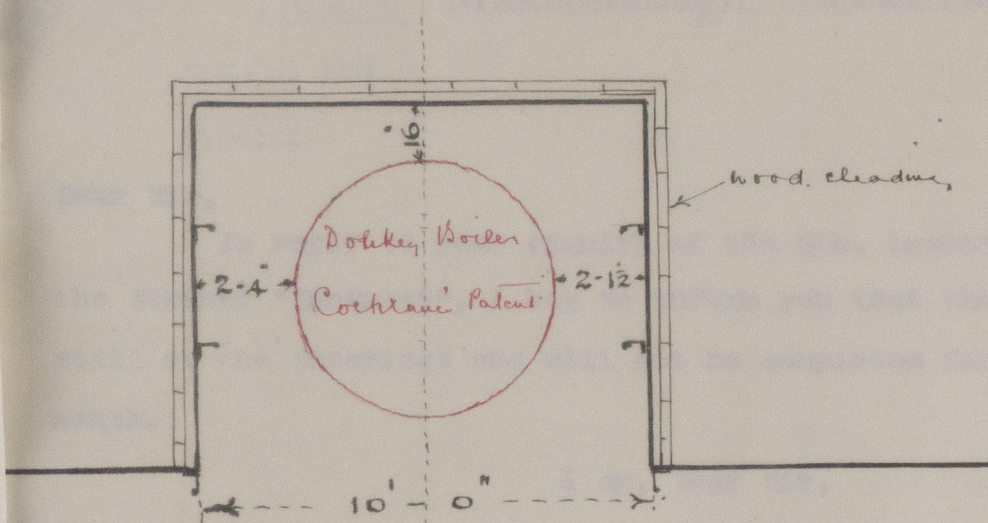

Elevation

Cabin Accommodation

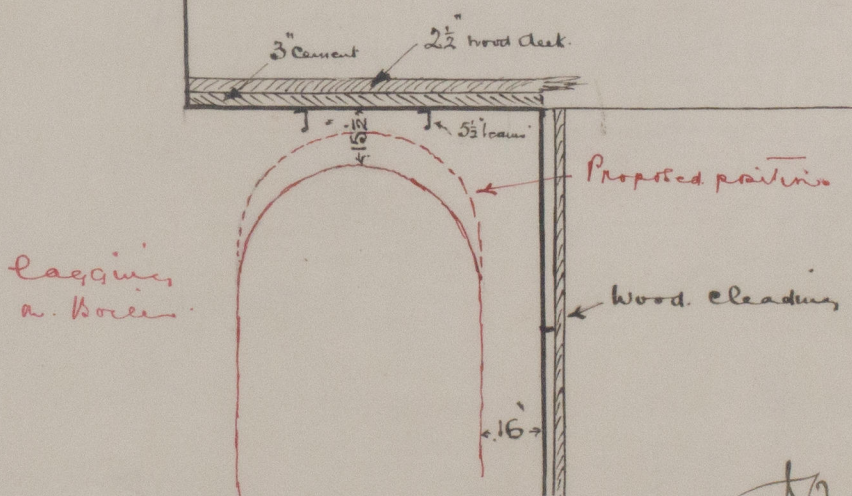

© 2020

Lloyd's Register
Foundation

W 946-0060