


[illegible]

MIDSHIP SECTION.

SCALE  $\frac{1}{2}" = 1 \text{ FOOT}$ .

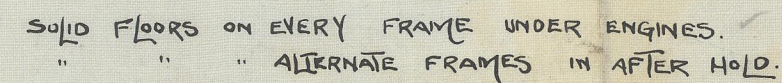

SECTION OF AFTER BODY.



29.9.13.



Earle S. & E. C. Ltd.  
No. 606.

Amended  
Midship Section.

Dimension  
210-0" x 33-0" x 15-0"

for Destroyer  
Hull Rpt No. 27655

© 2020

Lloyd's Register  
Foundation

1102-0946