

29.9.13

Handwritten notes in red ink at the top left, including "29.9.13" and "200-11".

S.S. N° 606. PROFILE & DECK PLANS



DIMENSIONS 210'-0" x 33'-0" x 15'-0" M.L.P.

SCALE 1/8" = 1 FOOT.



PILLARING THROUGHOUT TO SURVEYORS SATISFACTION.

NOTE. DECK LINE GIVEN IS AT
Lp OF SHIP.

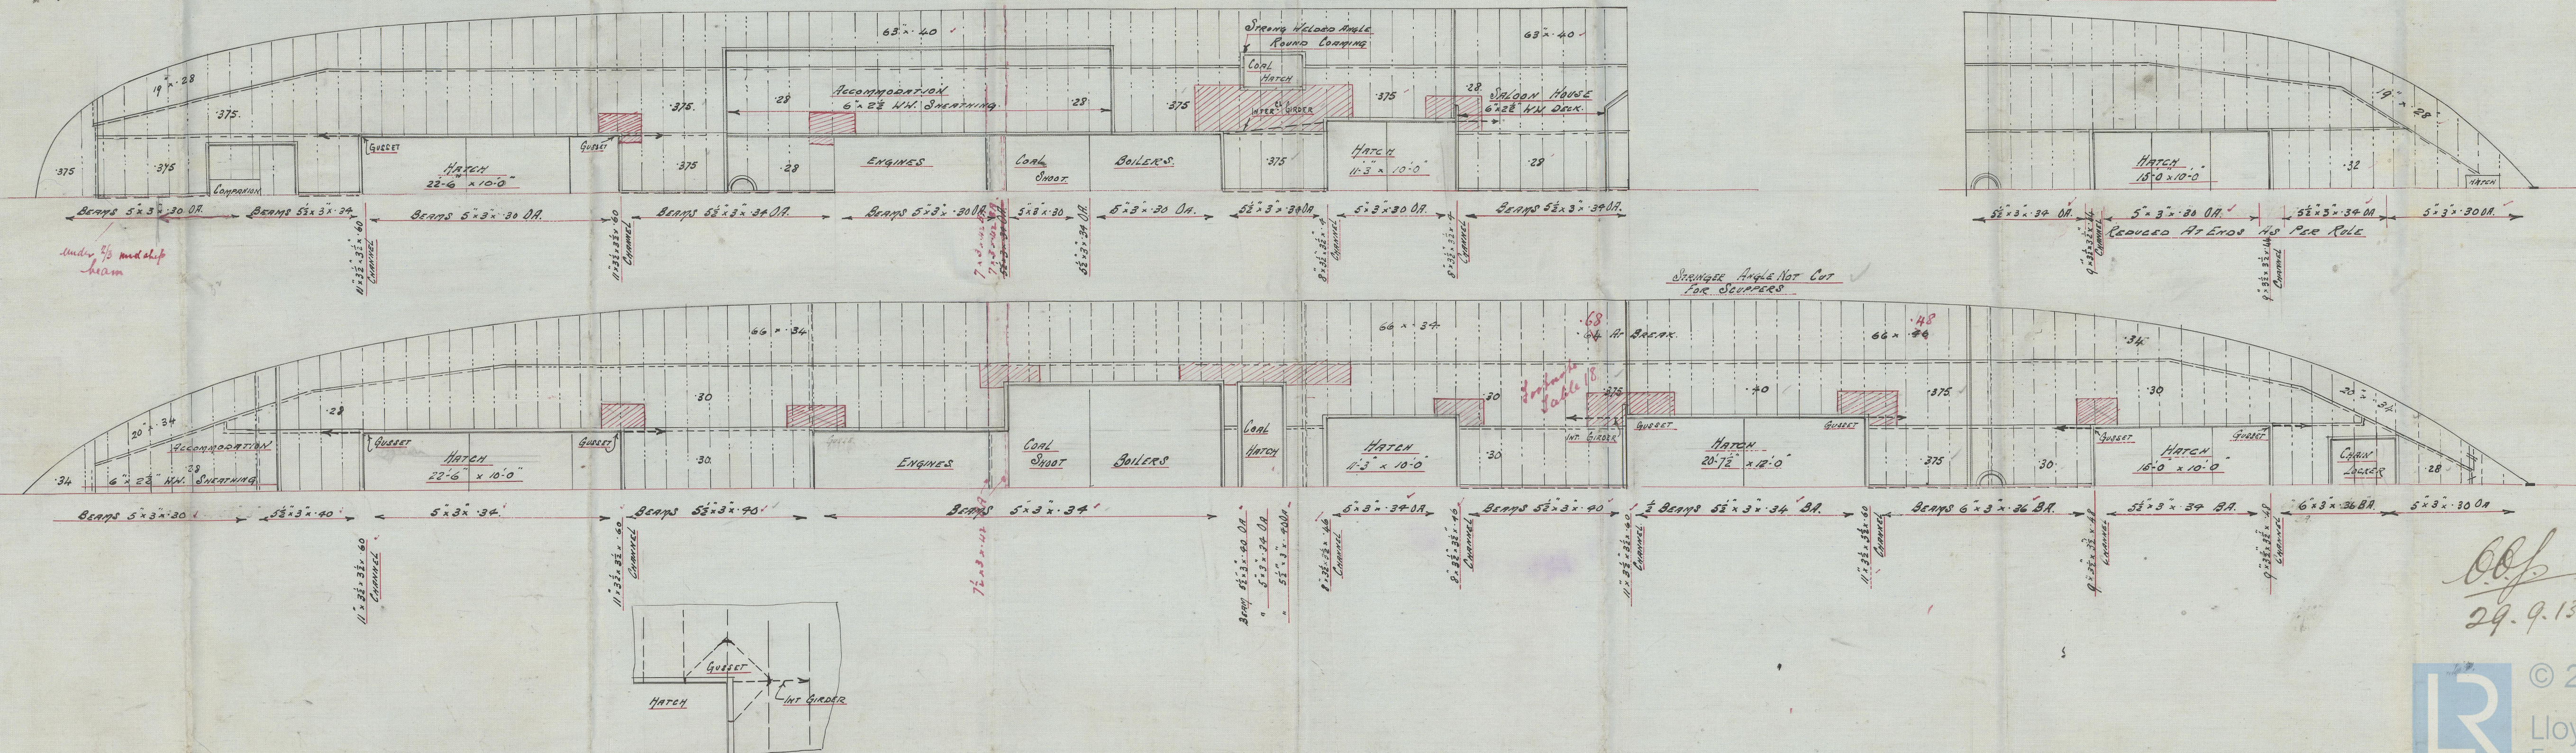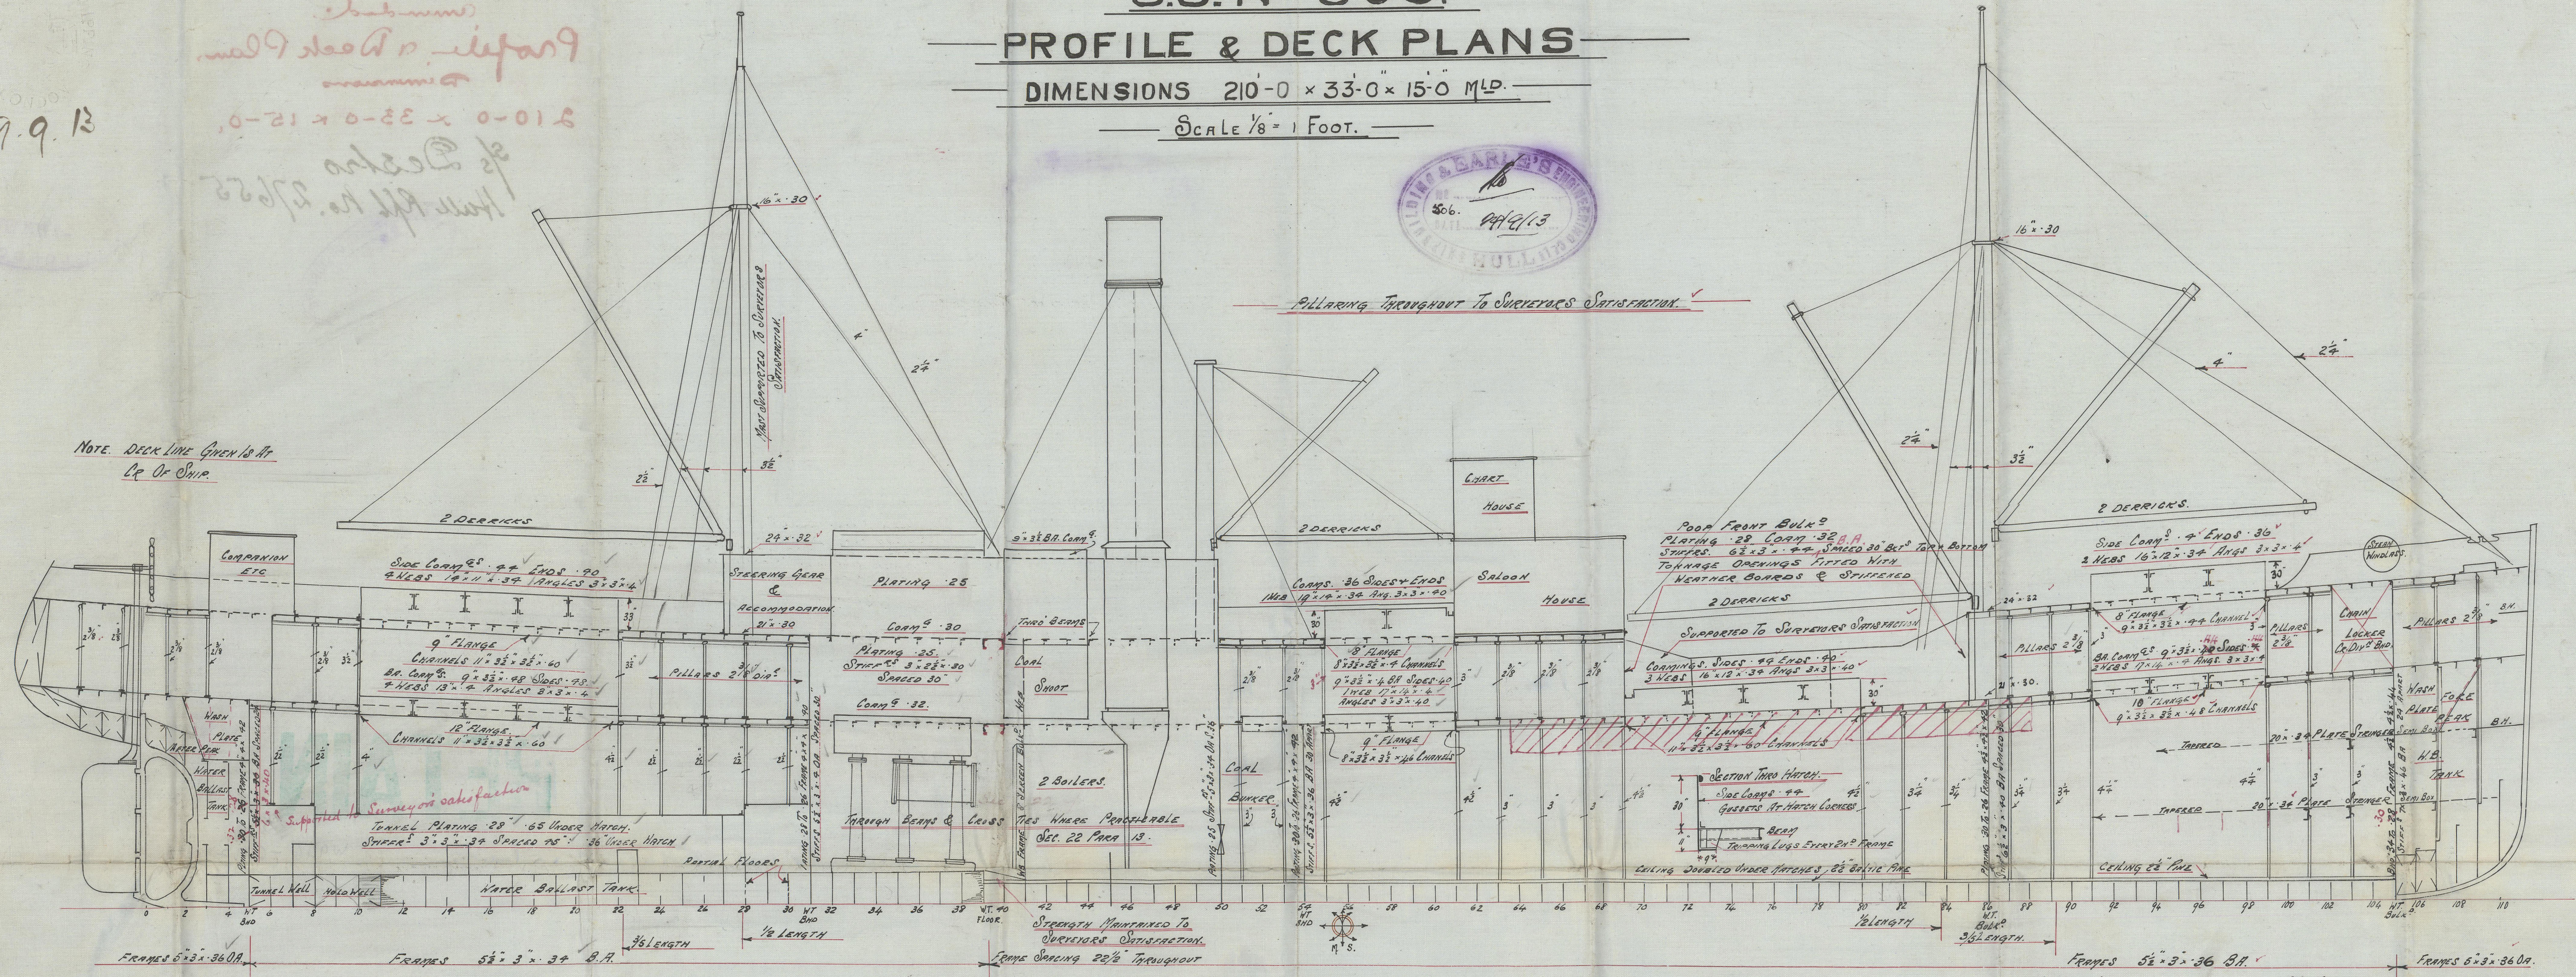

Handwritten signature and date: 29.9.13.

Charles S. & E. C. & L. L.
No. 606.

amended.

Profile & Deck Plan.
Dimensions

210-0 x 33-0 x 15-0.

S/S Destro
Hall Rpt No. 27655



© 2020

Lloyd's Register
Foundation

W 946-0117