
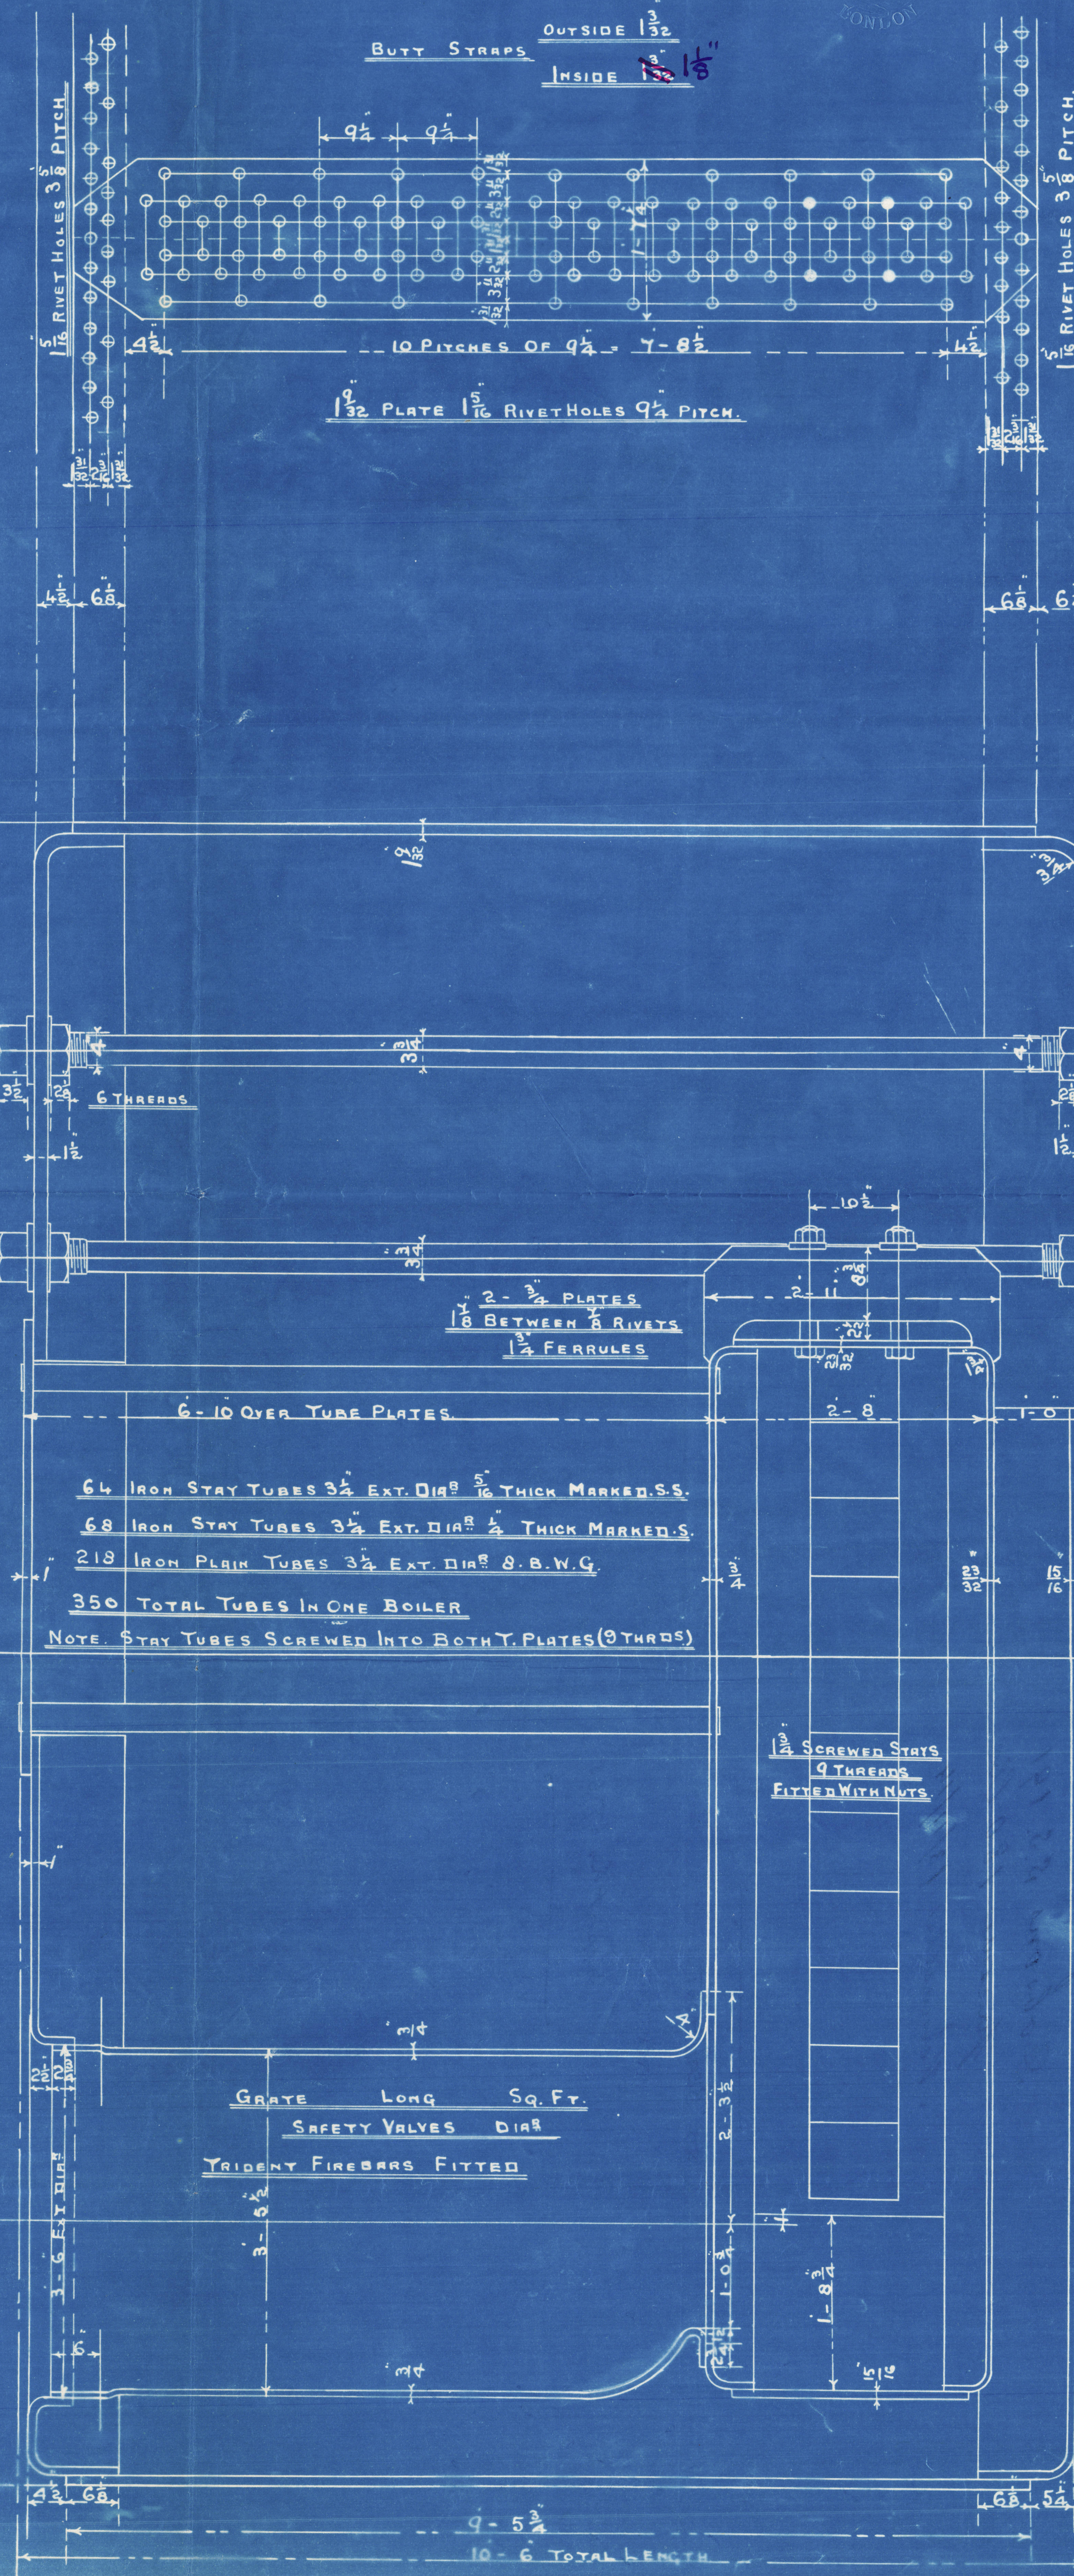


Y.M.A.
11/11/14

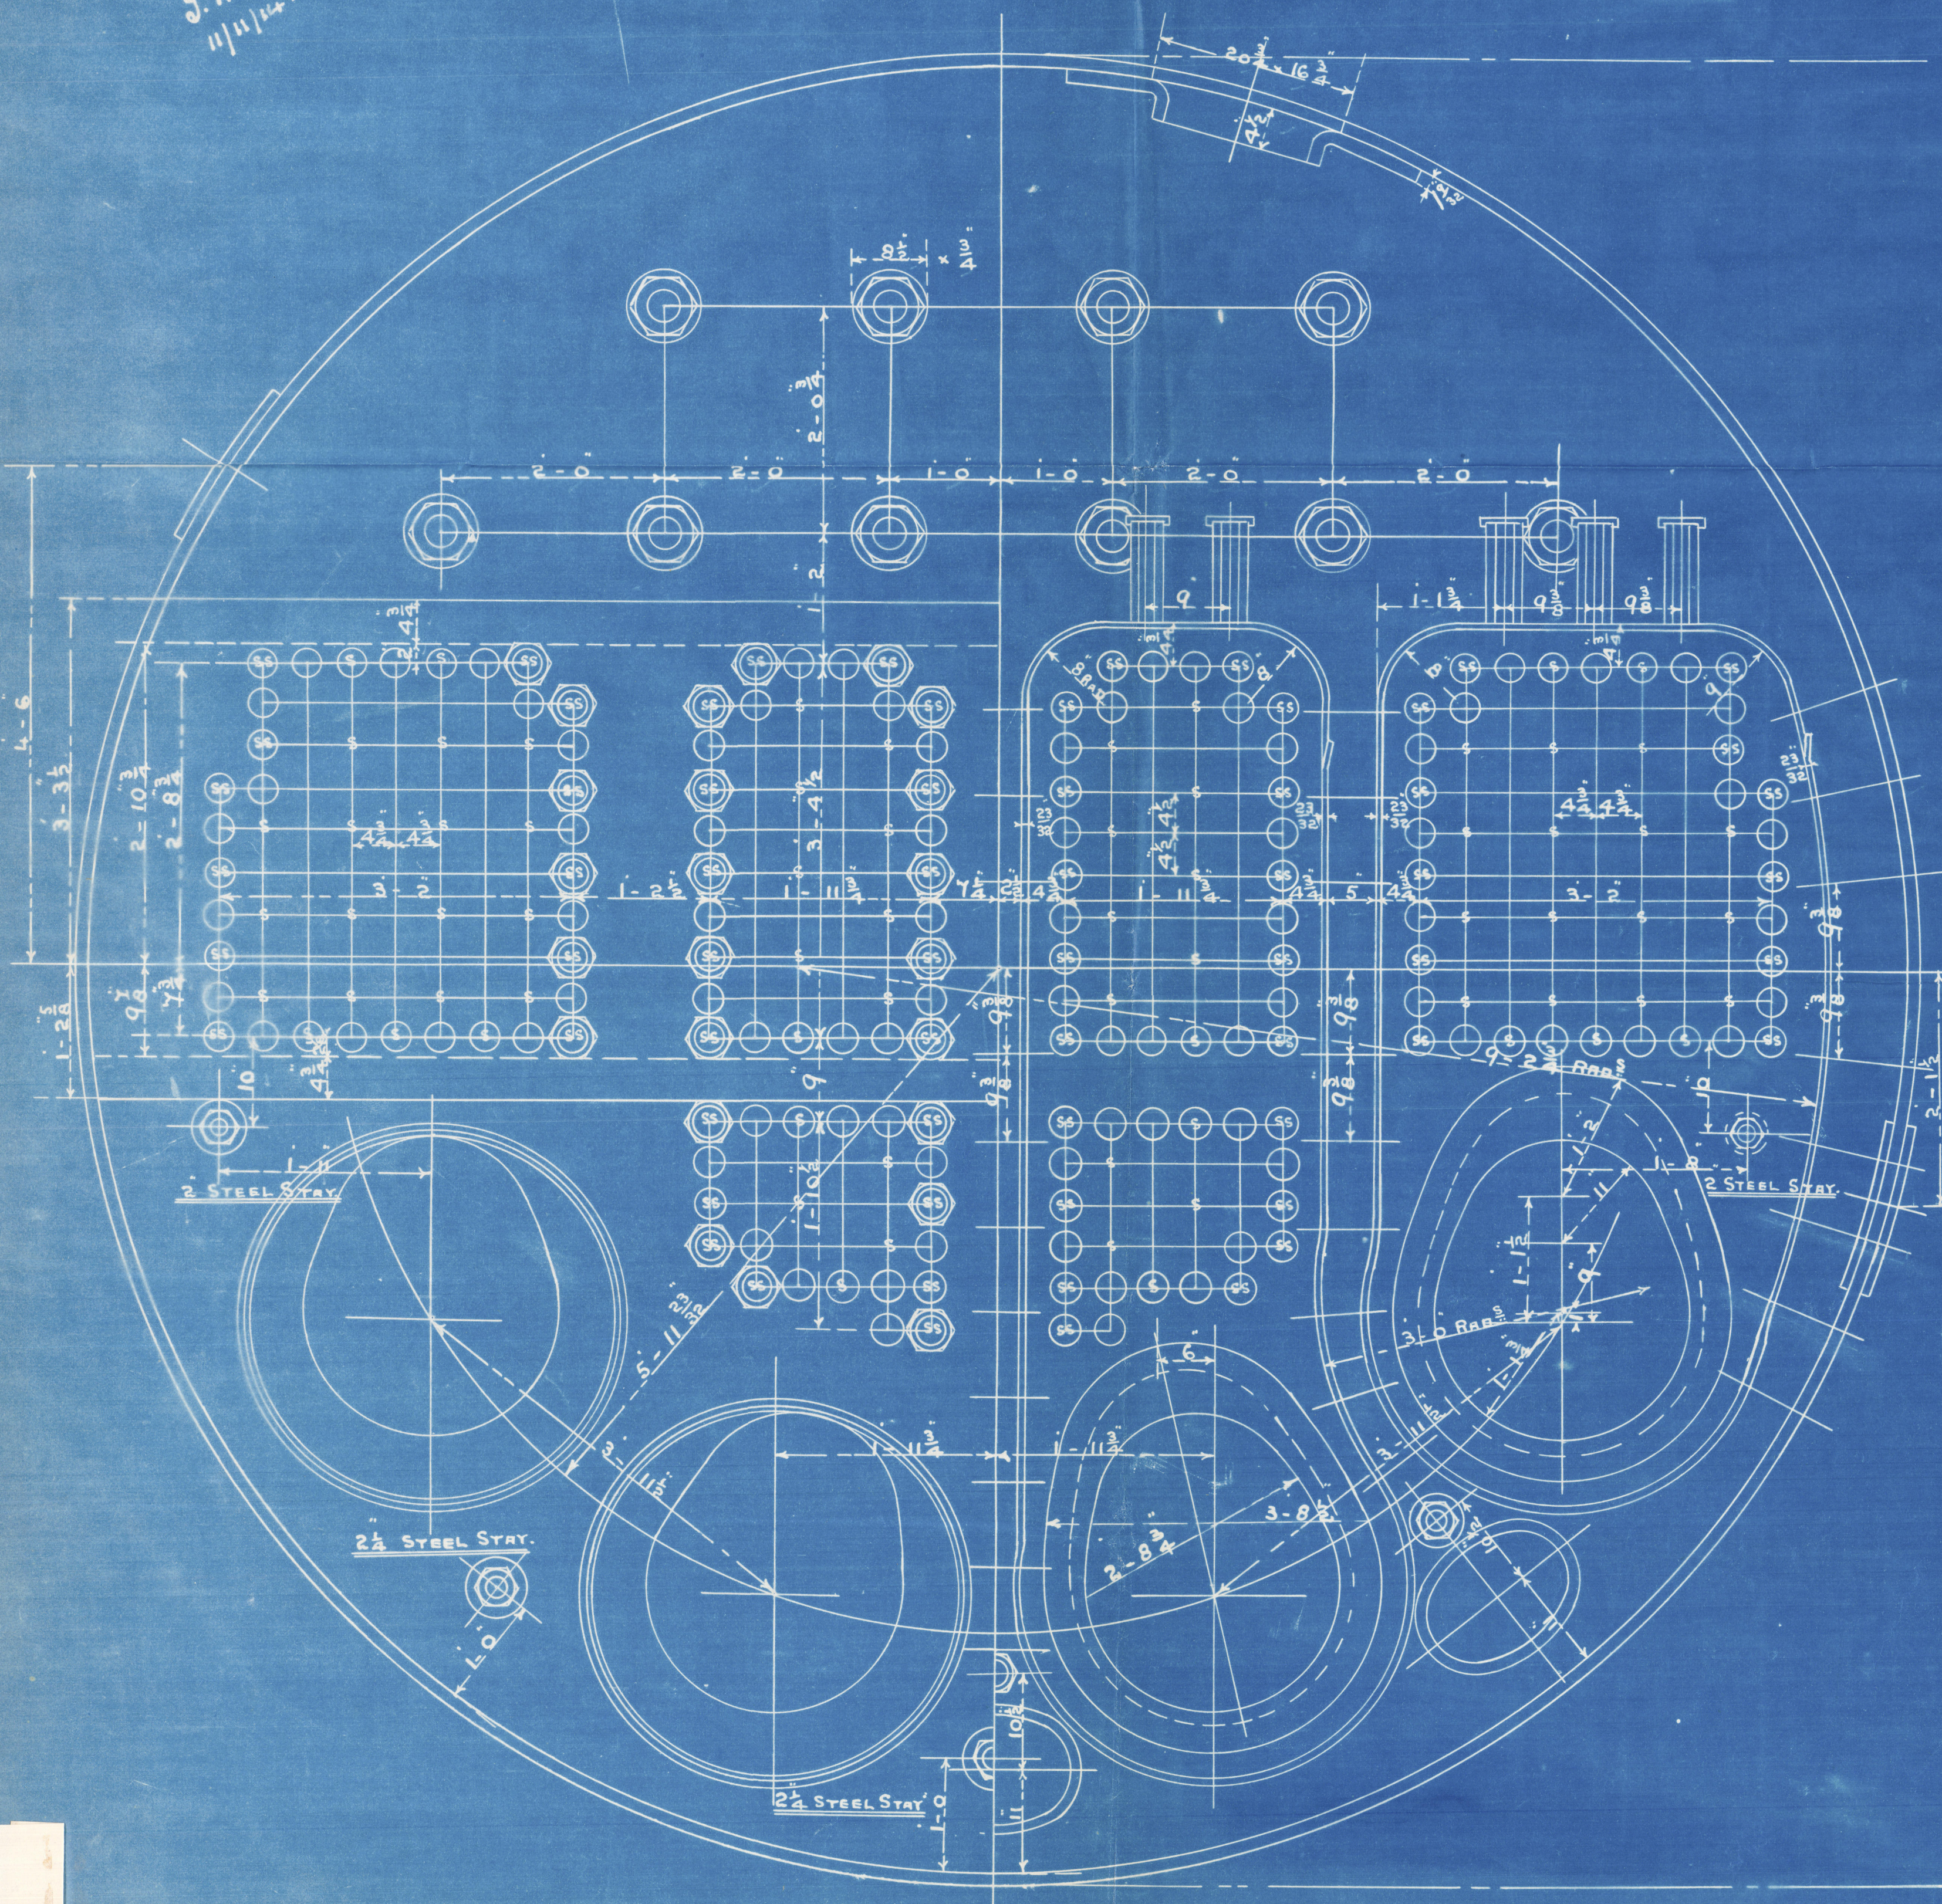

SURVEY TO LLOYD'S REQUIREMENTS.

HEATING SURFACE ON TUBES = 2034 Sq. Ft.

ELSEWHERE = 516 Sq. Ft.

TOTAL = 2550 Sq. Ft. PER BOILER

STEAM SPACE = CUB. FT.


WORKING PRESSURE 180 LBS.

TEST PRESSURE = 360---

NOTE ALL PLATES STAYS $\frac{1}{8}$ \"/>

TENSILE STRENGTH OF SHELL PLATING TO BE NOT LESS THAN 28 TONS PER SQ. INCH

ALL HOLES DRILLED IN PLACE AFTER PLATES ARE BENT.

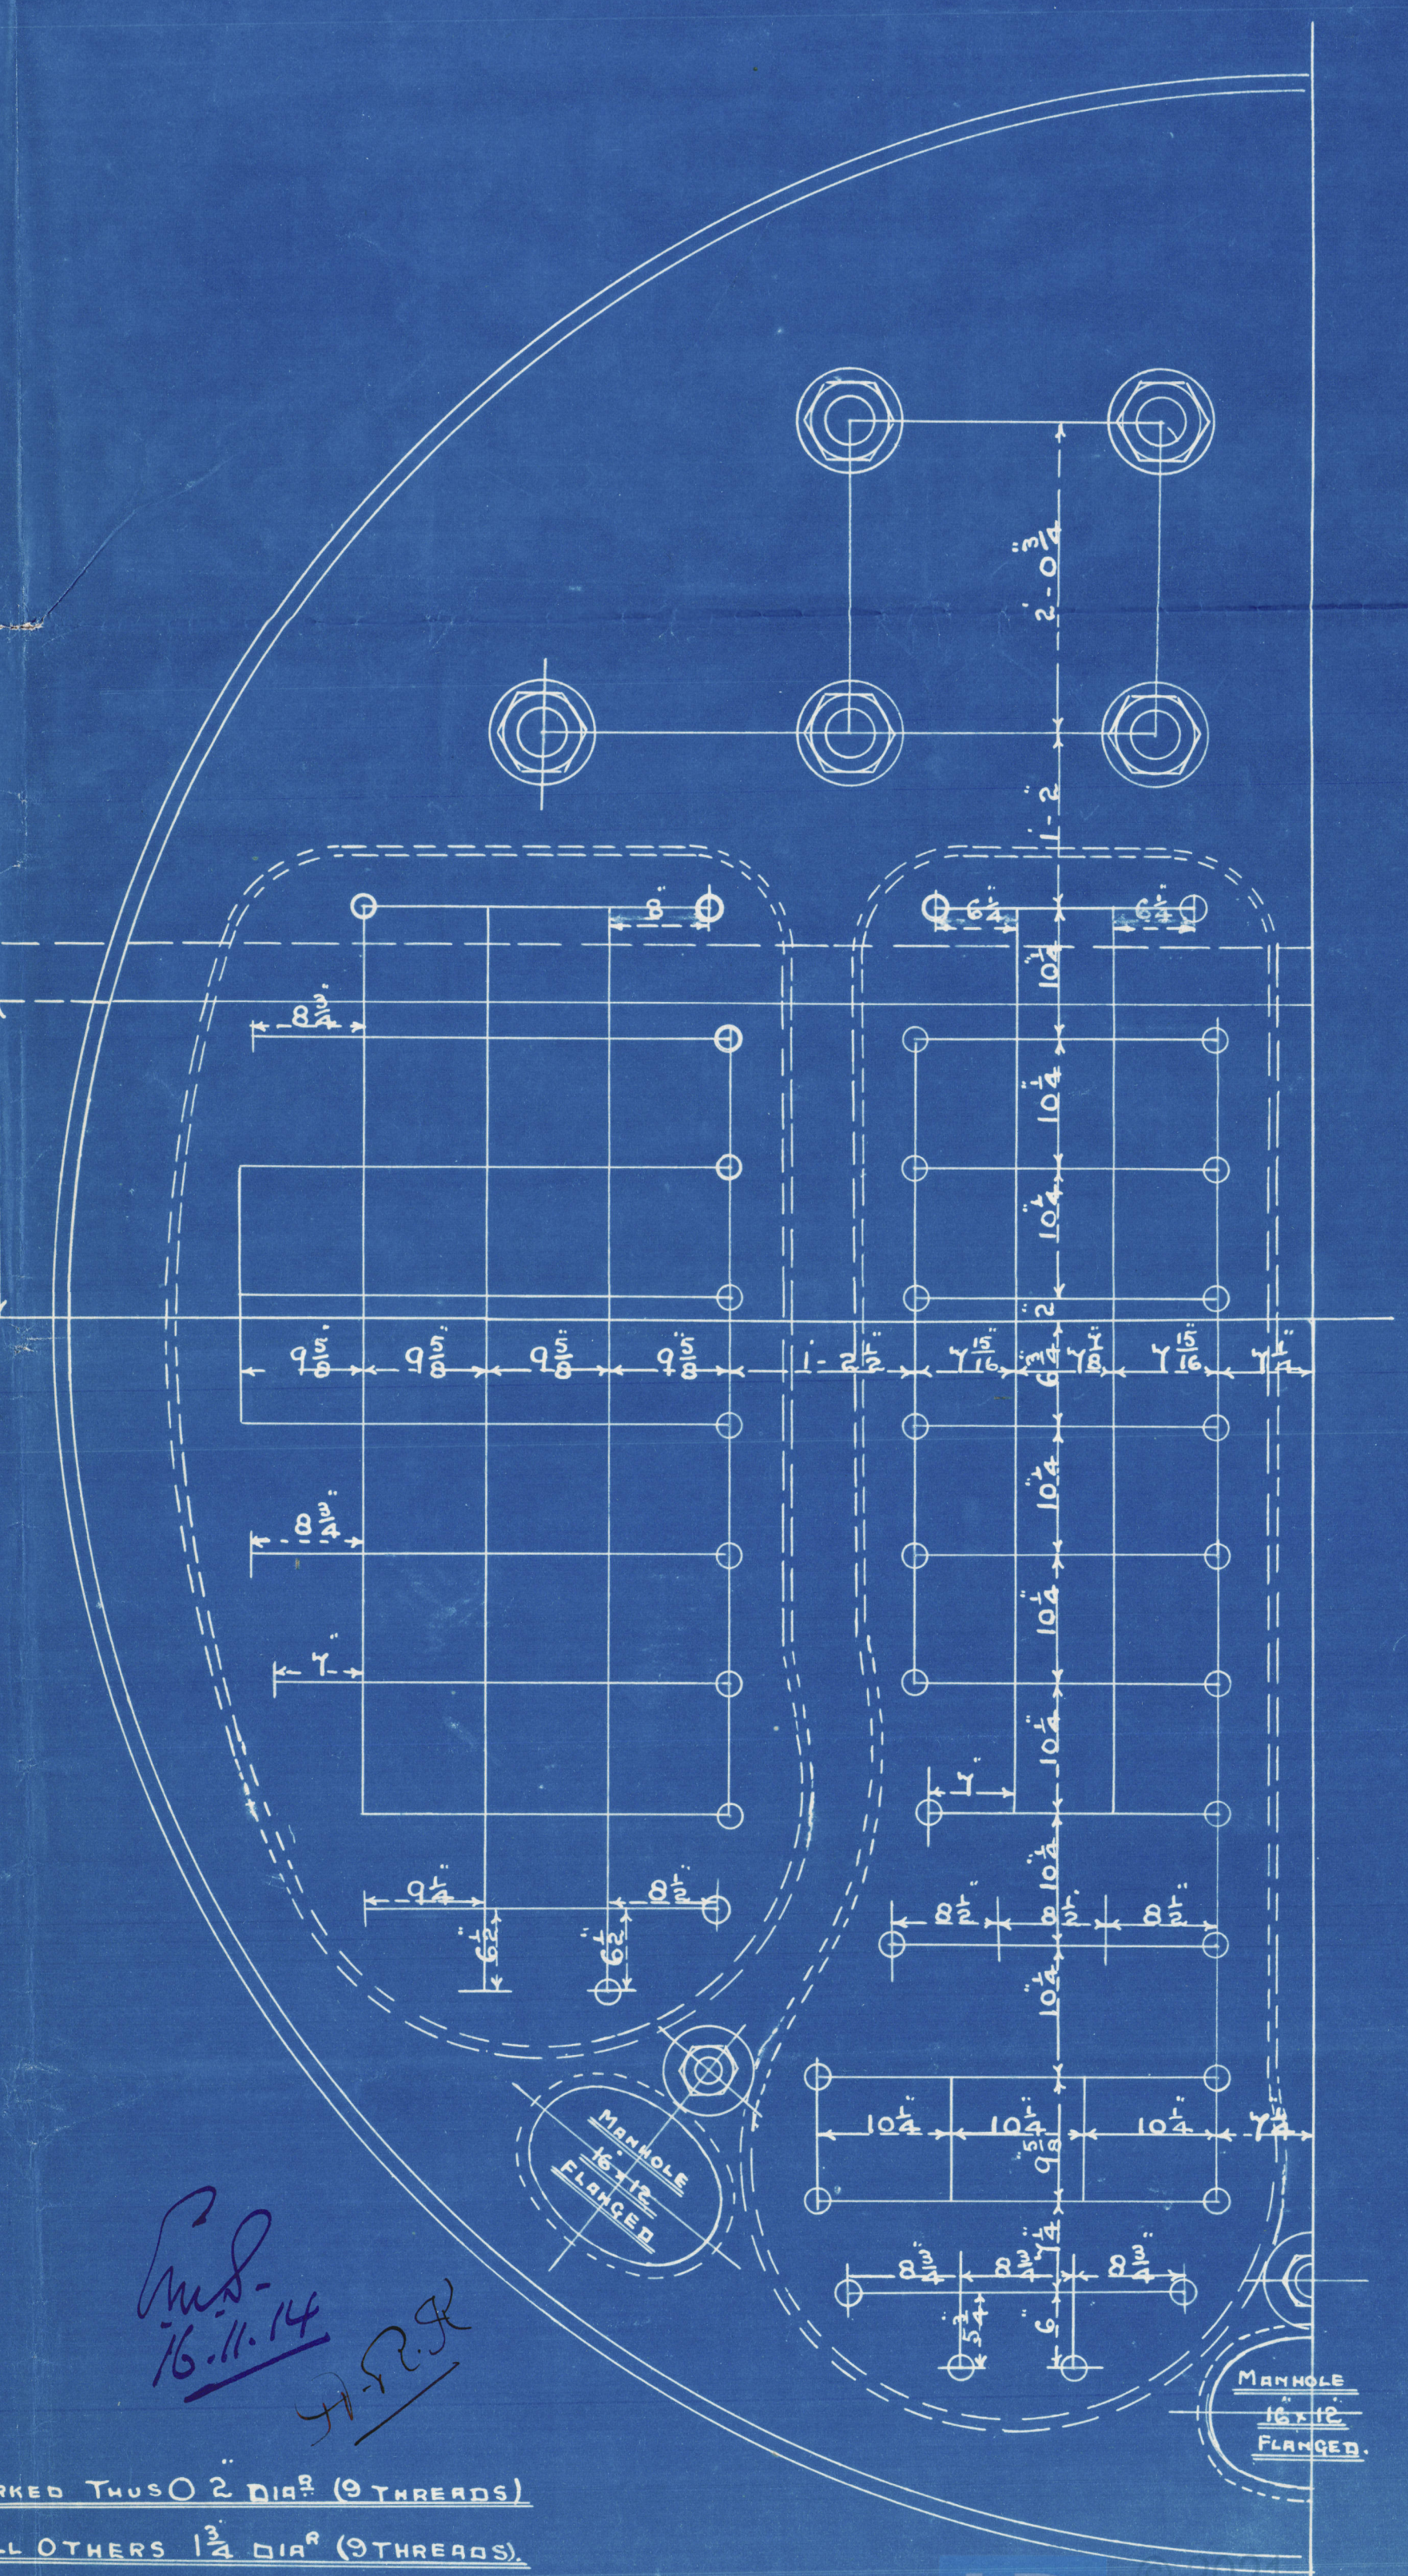

STAYS MARKED THUS \bigcirc 2\"/>

ALL OTHERS \bigcirc 1 1/2\"/>

NOTE ALL STAYS SCREWED INTO PLATE AND FITTED WITH NUTS.

1 THUS
1. OPPOSITE HAND.

CONTRACT 2207

N. E. M. E. Co., LIMITED, WALLSEND.

ENCLOSURE


FOR

Messrs.

W951-0040²/2

RETAIN

*W. E. Marine
Boiler 2207
for
Jobsons S.S. 191
pressure 180 lbs
Newcastle 13/11/14*

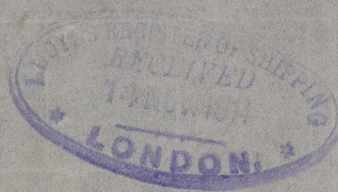

S. S. "BEAUFONT"

NEWCASTLE-ON-TYNE.

Report No 67765



© 2021

Lloyd's Register
Foundation

W951-0040 1/2