


28.8.13.
20.9.13
7.10.13
30.6.14

N^o 59



PROPRIETORS: SWAN, HUNTER & WIGHAM RICHARDSON AND MAXWELL BALLARD

DIMENSIONS 279'-0" x 40'-1 1/2" x 18'-9" MLD. WITH 6'-0" ARCH

SCALE $\frac{1}{8}'' = 1 \text{ FT.}$

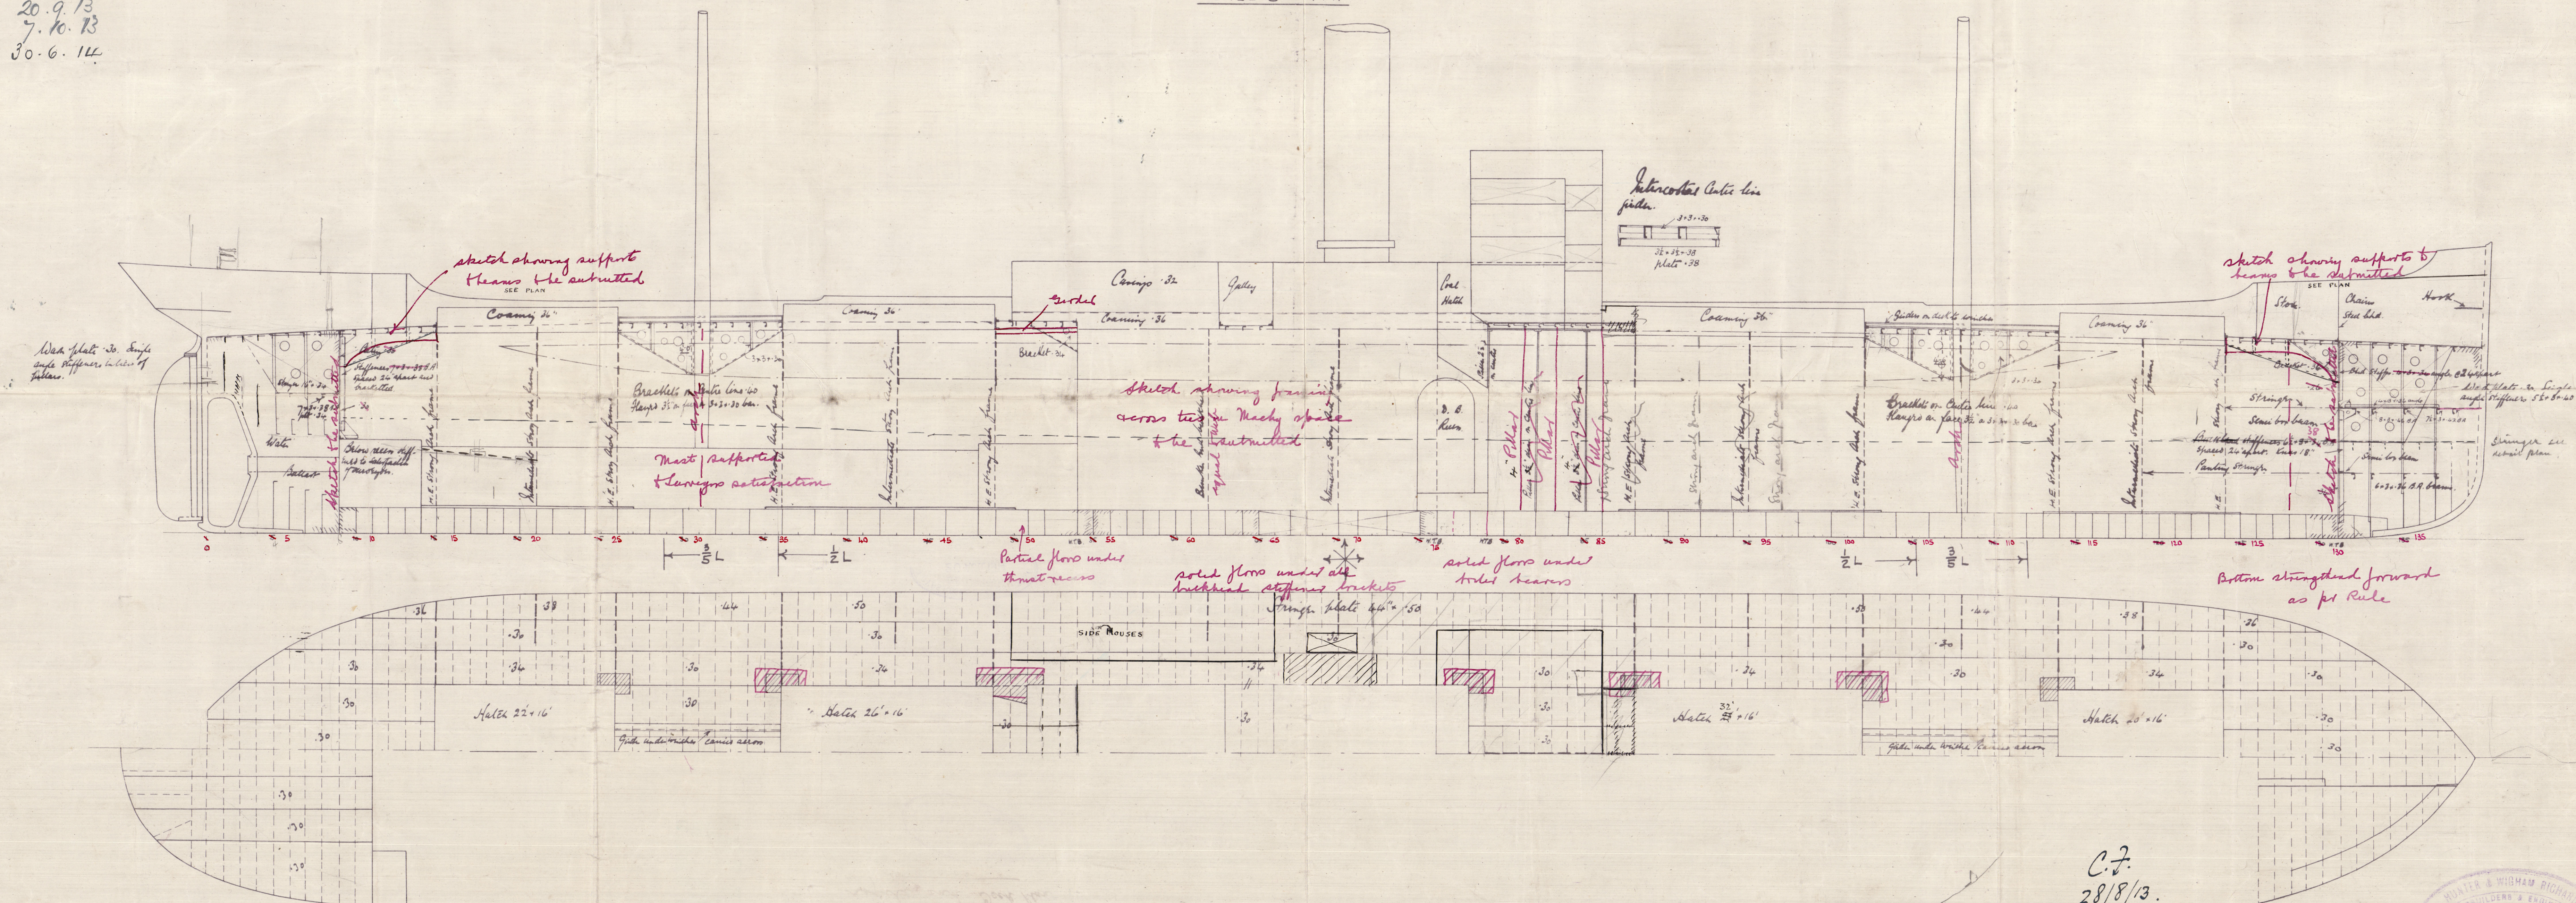

C.7.
28/8/13

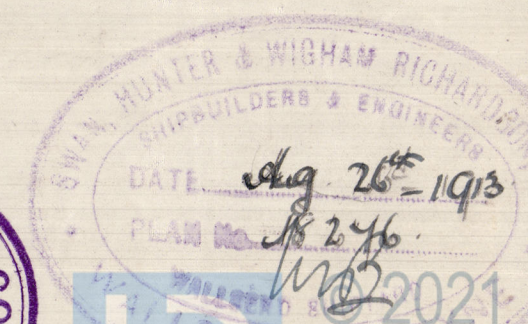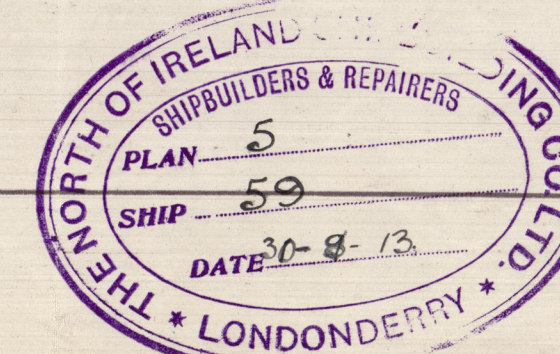

RETAIN

s/s. Redale
Bul. 7428
Rath of Ireland S.S. Co.

Nº 59

Profile and Deck Plan

LLOYDS REGISTER OF SHIPPING
RECEIVED
19 SEP. 1914
LONDON.

LLOYDS REGISTER OF SHIPPING
RECEIVED
18 DEC. 1914
LONDON.

LLOYDS REGISTER OF SHIPPING
RECEIVED
27 JUN. 1914
LONDON.

LLOYDS REGISTER OF SHIPPING
RECEIVED
20 AUG. 1914
LONDON.

1951-0060

N. I. S. Co. Ltd
RECEIVED
30 AUG. 1914

