

1779. Dup. of our N^o 1722

281

BOILERS 2.0FF
SCALE 1 INCH TO A FOOT
180 LBS WORKING PRESSURE.

19/2/13

SCALE $\frac{3}{4}$ " = 1 FOOT.

5-9 INSIDE

7 4 $\frac{1}{2}$ OVER DOOR

FOR DETAIL OF FURNACE FRONTS
SEE PRINT. TRACING NO 50292

J.R.R.
19.2.13

B.2453

TOTAL HEATING SURFACE IN TWO BOILERS . 5330 SQ FEET.

From BLAIR & CO., Ltd.,
STOCKTON-on-TEES.

For Enclosure to

*Messrs Lloyds
Engineer Surveyors
Middlesbros*

W951-0129 2/2

2 Main Boilers



Messrs Blair & Co Ltd

No 1779

for

Messrs Robt Thompson & Son Ltd
S.S. No 281

Working Press 180 lbs

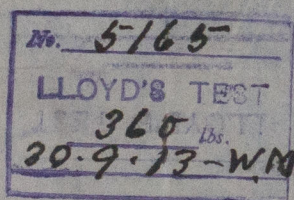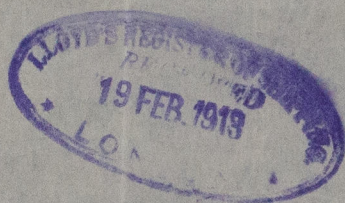

S.S. Bertrand

Indb Rpt. 8213

Std. Rpt. 25941

Duplicate of No 1722

S.S. Horngarth

Indb Report No 7149



© 2021

Lloyd's Register
Foundation