




— SCALE $\frac{1}{2}$ = 1 FOOT. —
STEEL SCREW STEAMER
CLASS 100A.1. SINGLE DECK.

ROBERT THOMPSON & SONS LTD
IRON & STEEL SHIPBUILDERS
& REPAIRERS
SOUTHWICK YARD
SUNDERLAND.

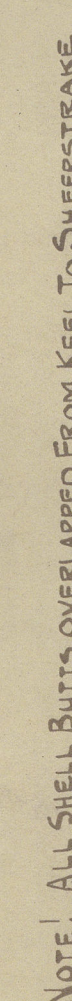


MIDSHIP SECTION
S.S. BERTRAND
R. THOMPSON + SONS

Nº 281
SLD RPT Nº 25941

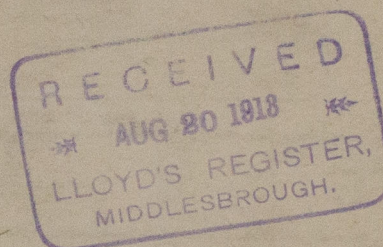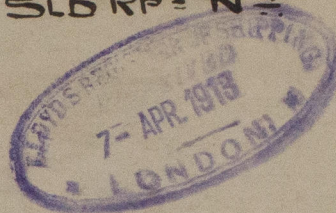

RETAIN

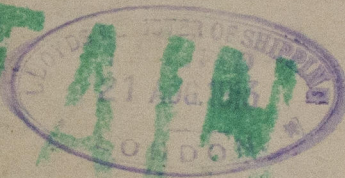

RETAIN



© 2021

Lloyd's Register
Foundation

W951-0131



© 2021

Lloyd's Register
Foundation