

CLASS LLOYDS #100 AL

BMD .26"
STIFFERS 3"x2 1/2"x.28"
SPACED 30" APART

← BOTTOM FRAMES ON FLOORS 3" x 3" x 3" SINGLE →
← REVFR 3x3x4 (DOUBLE UMER *Double* →
ENGINES *30* SIDE GIRDER) DOUBLE AT BOILER STOODS →
← FLOORS 36" → ← FLOORS 48" *48"* →
← CENTRE KEELSON 48" *48"* →

FRAMES SPACED 22" ALL FORE & AFT

← REV. FR^S ON FLOORS 3'x3'x.3" SING^{LE} →
← FLOORS .3" →
← CEN K^{ISM}. 32" INT^{CL} →

221
Geo.
6.11.15



Profile & deck plans
(as built)

S.S. "Ordgantock"

Messrs Ferguson Bros & Co

No 223.

Grk. Rpt. No 14225.

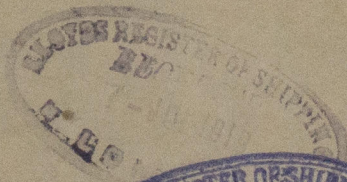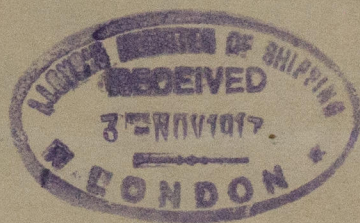

RETAIN



Lloyd's Register
Foundation

W968-0084