

MIDSHIP SECTION


S.S. ASHLEAF.

IMENSIONS = 380'-0" x 53'-0" x 26'-9" MLD

O CLASS 100AI AT LLOYDS SHELTER DECK WITH FREEBOARD

EIGHT INCH = ONE FOOT

OR CARRYING OIL IN BULK.

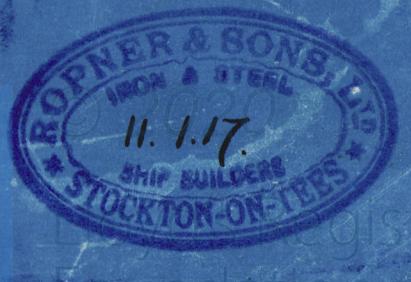

Messrs. Ropner & Sons Ltd
No 505

Mid. Sec. as built

8/5 Aohleaf

Mid. report no. 9589

W970 - 0119



RETAILED



© 2020

Lloyd's Register
Foundation