


BLA
For
11.18

SCALE 1 INCH TO A FOOT.

ISO. LB^S. W. P.

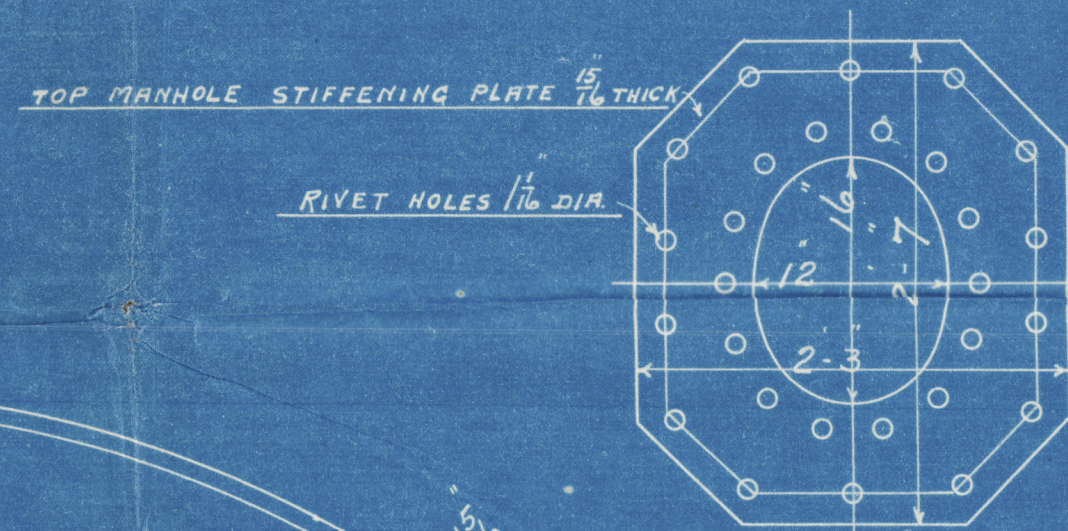

TENSILE OF MATERIAL

GIRDERS 28 " 32


OTHER PLATES 26 " 30

22M *ms*
6.4. 15-

[illegible]

TOTAL HEATING SURFACE = 1208 SQ. FT.

" GRATE " = 32.7 " "

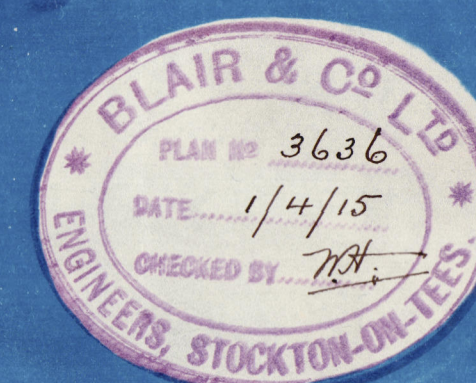

Aux Boiler

Messrs Blair & Co Ltd

Boiler No E.12

Aux Boiler for Eng No 1834

Messrs Roper & Sons

S.S. No 505

Working Press 180 lb

W970-012.0

No. 5623
LLOYD'S TEST
360 lbs.
10.3.16 J.K.

(2)

Sr. Ashleaf.

Indb sh No 9589



RETAIN

RETAIN



© 2020

Lloyd's Register
Foundation

From **BLAIR & CO., Ltd.,**
STOCKTON-on-TEES.

For Enclosure to

Messrs Lloyd
Engineer Surveyor
Middlesbrough

W970-0120 1/2