

SCALE $\frac{1}{2}$ - 1 FOOT. CLASS. 100. A. I. LLOYD.


PRINCIPAL DIMENSIONS.

RULE LENGTH	359.75
" BREADTH	49.66
" DEPTH	26.66

EQUIPMENT.

- ✓ FRAMES BETWEEN PEAK BULKHEADS - 10' 2" 3/4 - 58 B.A. SPACED 2" APART.
- ✓ FRAMES IN PEAK - 6' 2" 3/4 - 48 B.A. SPACED 2" APART.
- ✓ FRAMES IN ENGINE & BOILER ROOM INCREASED .04 IN LIEU OF WEB FRAME.
- ✓ ORDINARY FLOOR AT END - .38
- ✓ ANGLE FRAMES IN BRIDGE TWEEN DECK - 5' 2" 3/4 - 36
- ✓ STEM - 10' 2" 3/4 ✓ PROPELLER POST - 10' 7" ✓ RUDDER POST - 9' 7" ✓
- PROPELLER BOSS PLATES - 70.

TANK MARGIN - .44" IN BOILER SPACE .52"
TANK TOP CENTRE STRAKE - ^{.54"}.56" .46" FOR 2' L. TO .40" AT ENDS. .54" BOILER SPACE ✓
TANK TOP IN HOLD - .38" FOR 2' L. TO .34" AT ENDS. .46" ENGINE SPACE .54" BOILER SPACE ✓
DOUBLE REX, FRAMED IN ENGINE SPACE AND ON BOILER BEARER FLOOR
CEILING 3" x 2" WHITE WOOD UNDER HATCHES.
FRAMES IN TANK DOUBLED AT FORE END FROM 1/2" L. TO COLLISION BULKHEAD.

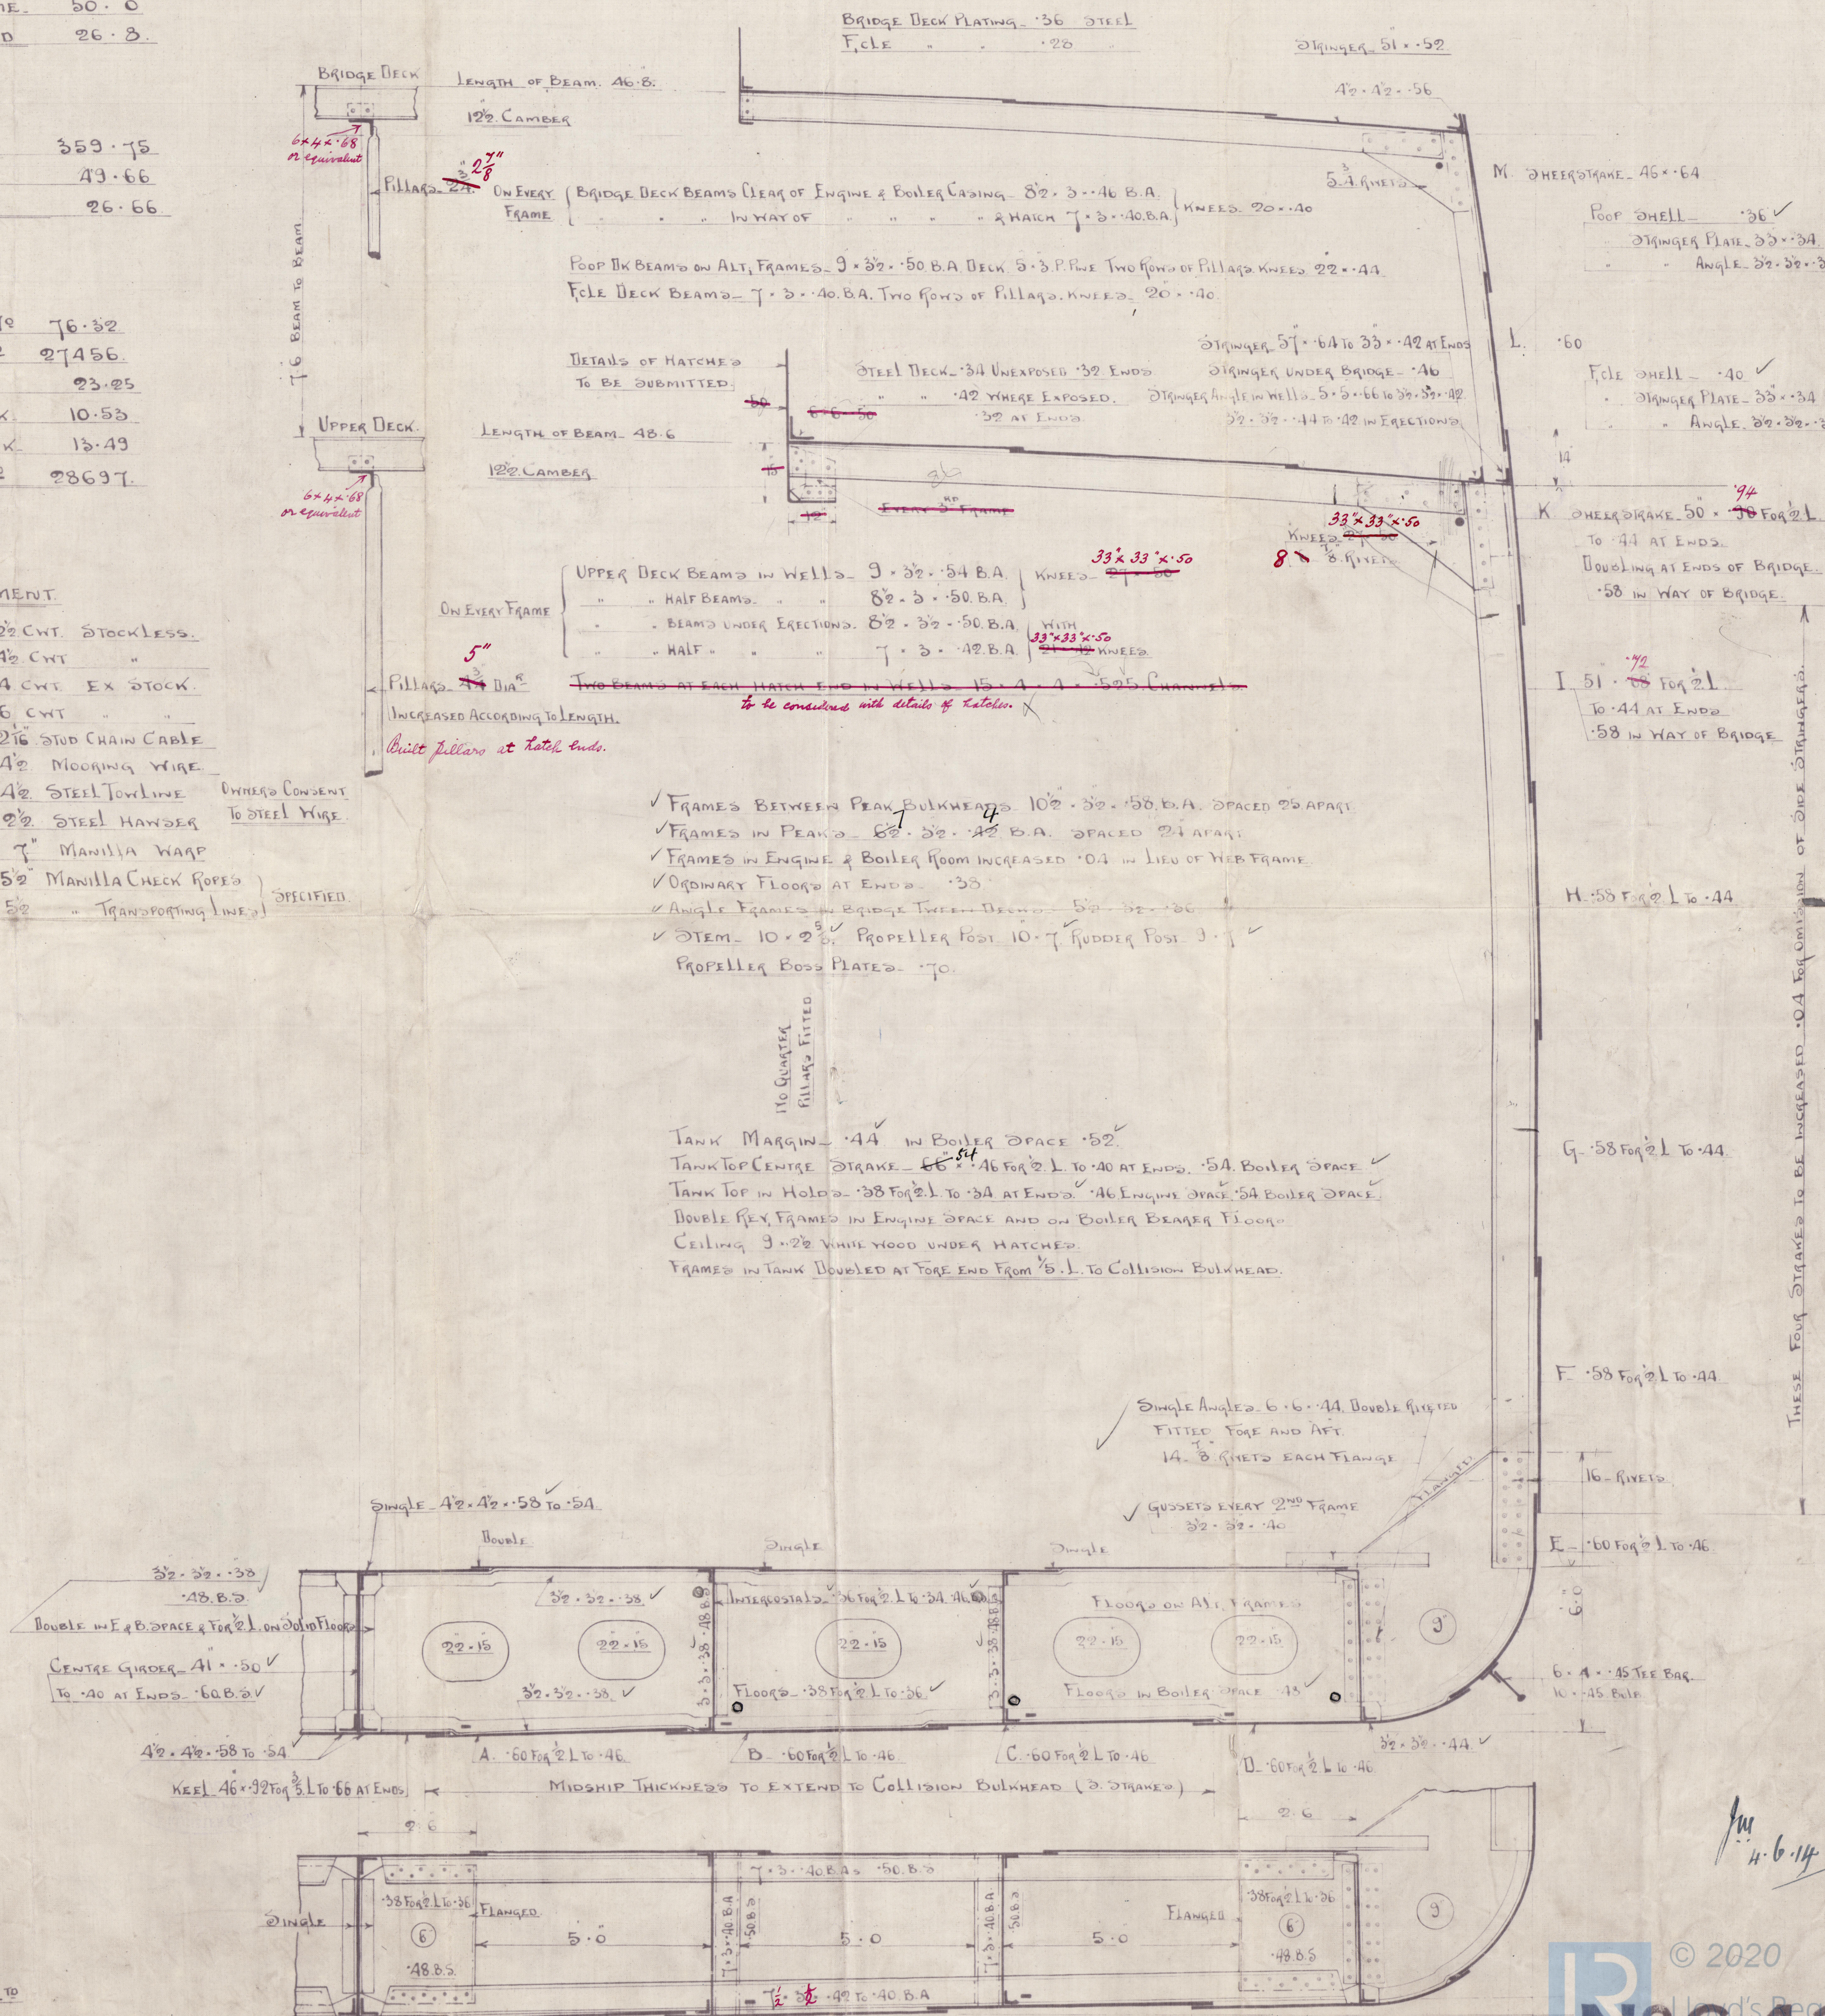

TRACING No 3822
MAY 30TH 1914.

W981-0095



W 981 - 0095



© 2020

Lloyd's Register
Foundation

Messrs R. & L. Duck & Co. Ltd

Inv 43

Mist. Lu:

Sp. Ampleforth



Indb report No. 8444

W981-0095



© 2020

Lloyd's Register
Foundation