


22. 10. 13
20. 11. 13.
5. 12. 13
9. 1. 14
21. 1. 15 (653)
26. 6. 15.
2. 7. 15.
11. 7. 15.

PROFILE & DECK PLANS.

Scale 1/8" = 1 Foot. CLASS 100.A.I. LLOYDS
HULL DIMENSIONS: 299.75 x 51.75 x 27.0.

 

UNDERDECK TONNAGE ABOUT 4360.
THICKNESS OF HATCH COVERS 3.

RICHARDSON, DUCK & CO LTD
SHIPBUILDERS
STOCKTON-ON-TEES
TRACING No 3468
Oct. 13. 11.

No 640. 2020

Messrs R. Buck & Co
No 640 & 653





Proprietors

Sp. Anglica No 640


Sp. Cardigan No 653

MIDDLESBRO' 8551 No 640

Qty to
9925

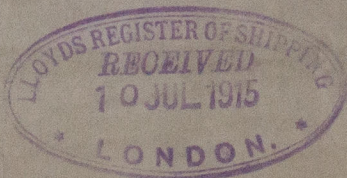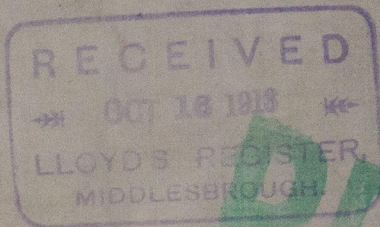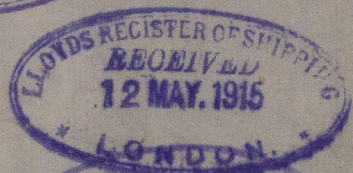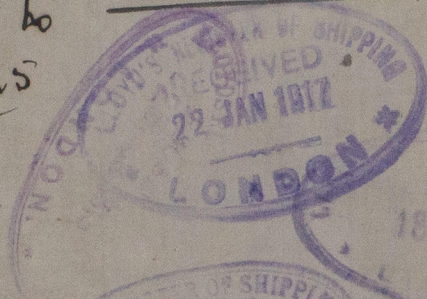

RETAIN

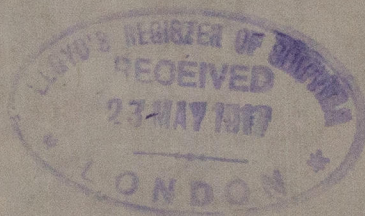

RETAIN



© 2020

Lloyd's Register
Foundation

W982-0228