

SCALE $\frac{1}{2}'' = 1$ FOOT. CLASS 100 A1. LLOYDS.

9. 1. 14.



12.2.15 DEPTH MOULDED 27.0

RULE LENGTH	399.75
" BREADTH	51.75 ✓
" DEPTH.	27.0.

TRANSVERSE № 78.75'
LONGITUDINAL № 31480.
DEPTH (d) 23.5.66
DEPTHS IN LENGTH TO SHELTER DECK 11.42
EQUIPMENT № 3422A.

EQUIPMENT.

2. BOWERS	60 CWT STOCKLESS	✓
1. "	50 1/2 CWT. "	✓
1. STREAM	16 1/4 CWT EX STOCK	✓
1. KEDGE	7 CWT. "	✓
270. FATHOMS	2 3/8 DIND CHAIN CABLE	✓
90 "	4 1/2 MOORING WIRE	✓
120 "	4 3/4 STEEL TOWLINE	✓
2 OF 90 "	2 3/4 STEEL HANDBAR	✓
2 OF 90 "	7" Manila WARP	✓

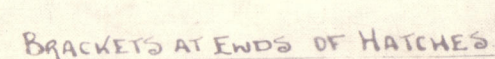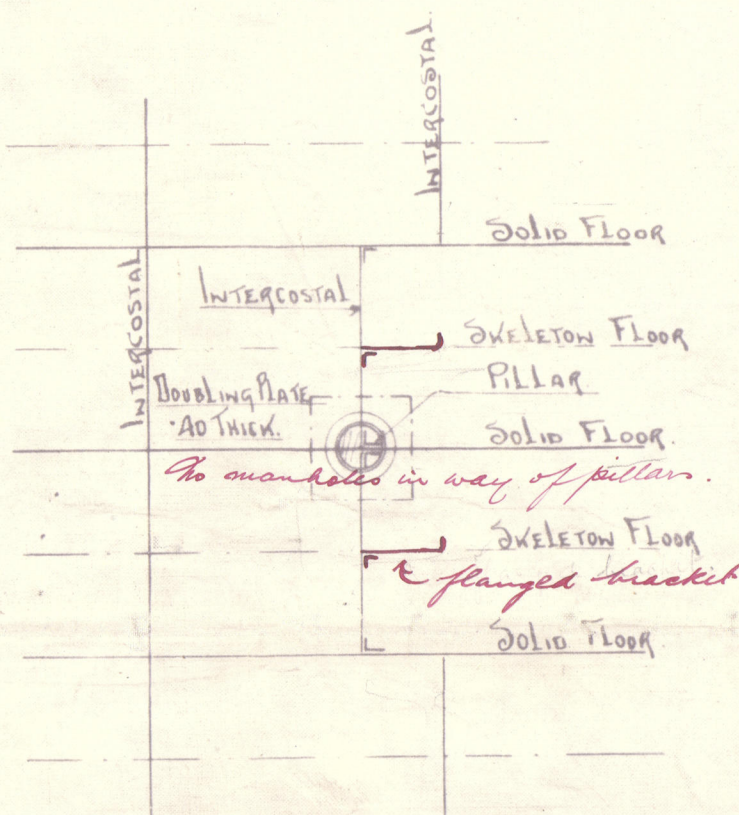

SINGLE LUG DOUBLE RIVETED
 $3\frac{1}{2} = 3\frac{1}{2} \times .40 \checkmark$

$3'0" \times 3'0" \times 4'0"$ ✓
 50. BOILER SPACE ✓
 DOUBLE IN E & B SPACE FOR 2 LOW DRAIN FLOORS ✓
 CENTRE GIRDER - $45" \times 48"$ ✓
 TO 40 AT ENDS ✓ 60. B.S. ✓

$A_2^v \cdot A_2^v \cdot .60$ To $.56$ ✓

WHEEL - $47 \times .98$ For $\frac{3}{5} L$ To

FRAMED BETWEEN PEAK BULKHEADS - $11 \times 3\frac{1}{2} \times 58$ B.A. } SPACED $25\frac{1}{2}$ APART
ALTERNATE FRAMES TO SHELTER DECK X
FRAMES IN PEAKS - $7 \times 3\frac{1}{2} \times 42$ B.A. } SPACED 24 APART ✓
FRAMES IN E & BOILER SPACE INCREASED .04 IN LIEU OF WEB FRAME X
ORDINARY FLOOR AT END .38 X
STEM - $10 \times 2\frac{1}{2}$ PROPELLOR POST - $10 \times \frac{1}{2}$ RUDDER POST - $9 \times \frac{1}{2}$ PROPELL

TANK TOP IN HOLDS .40 FOR 21 TO .34 AT ENDS .48 ENGINE SPACE .56 BOILER SPACE
DOUBLE REVERSE FRAMES IN ENGINE SPACE AND ON BOILER BEARING FLOOR
FRAMES IN TANK DOUBLED AT FORE END FROM .51 TO COLLISION BULKHEAD

SPECIFICATION { FLOORS IN WAY OF BOILERS OF IRON & ANGLES OF IRON THICKNESS
FLOORS AT TANK ENDS DO THICKER THAN RULE.

TANK TOP CENTRE STRAKE. 60×48 FOR $\frac{1}{2}$ LT. 40 AT ENDS.
54 BOILER SPACE. *Make in B-i. Space to*

as per Rule

DOUBLE ✓ SINGLE Sec 4.3 par 3

Single 4 1/2" x 4 1/2" 60 To 56 ✓

double d'Ante dips in Eng space } in 153!
not Hw.

3 1/2, 3 1/2, 40. ✓



A. 72×62 For 2 L To 46. B. 72×62 For 2 L To 10
 $6\frac{1}{4}$ Lamin in MIDSHIP THICKNESS TO EXTEND TO COLL

154

7 x 3 x 40 B.A.	50 B.S.
0 For 2 L To 36	DOES


2.52.44.B


18

SINGLE ANGLE 6-6-46.

TANK MARGIN .46 BOILER SPACE .56

Single Single

310-310-10-1

22.15

FLOORS IN BOILER SPACE - 50. ✓


D (THREE STRAKES) →

FLANGED 40 For 1/2 L To 36

5.0

16.12


Nº 640.

© 2020
653

Roy L. Lloyd's Reg
Foundation

W480201

Master R. Buckley
No 640. 653

Mid. Sec.





Sp. Ang. Sec. No 640

Sp. Cardigan. No 653

MIDDLESBRO'

Rp. No

9925

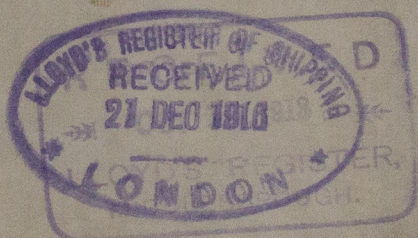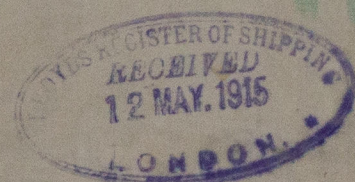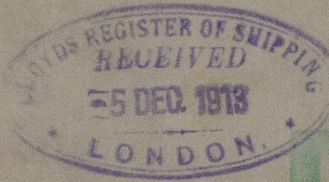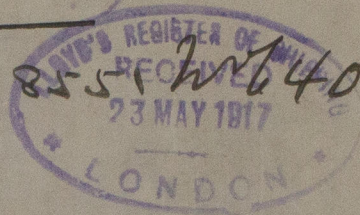

RETAIN

RETAIN



© 2020

Lloyd's Register
Foundation

W982-0231