

SCALE $\frac{1}{8}'' = 1 \text{ FOOT.}$

17. 2. 16.
21. 3. 16.
5. 10. 16

4.1.516.

Amended Profile



W983-0230

Amended
Profile

no. 516

J. L. Thompson + sons

Wm "GRO"

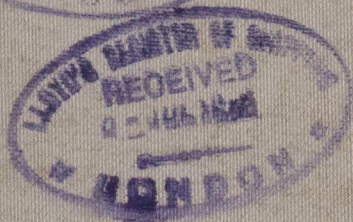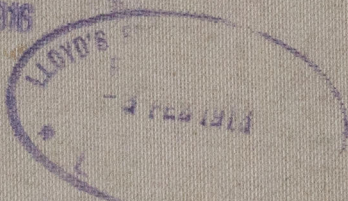

"Sunderland"

SUNDERLAND RPT. No. 270870