

No. 870.

MIDSHIP SECTION.

DIMS. 320' x 45' 19' M.D. UPPER D.K.

SCALE: 1" = 1' 0".


TO CLASS 100 A.I. * WITH FREEBOARD, 14' 9" M.D. DRAFT.

NUMERALS C.C.S.

1ST LONGITUDINAL No 7245.
2ND " " No 21805.
D - 2264.
d - 8.22.
L - 11.85.

EQUIPMENT LETTER - U.
1 1/16" CABLES.

MIDSHIP SCANTLINGS FOR
40% LENGTH.

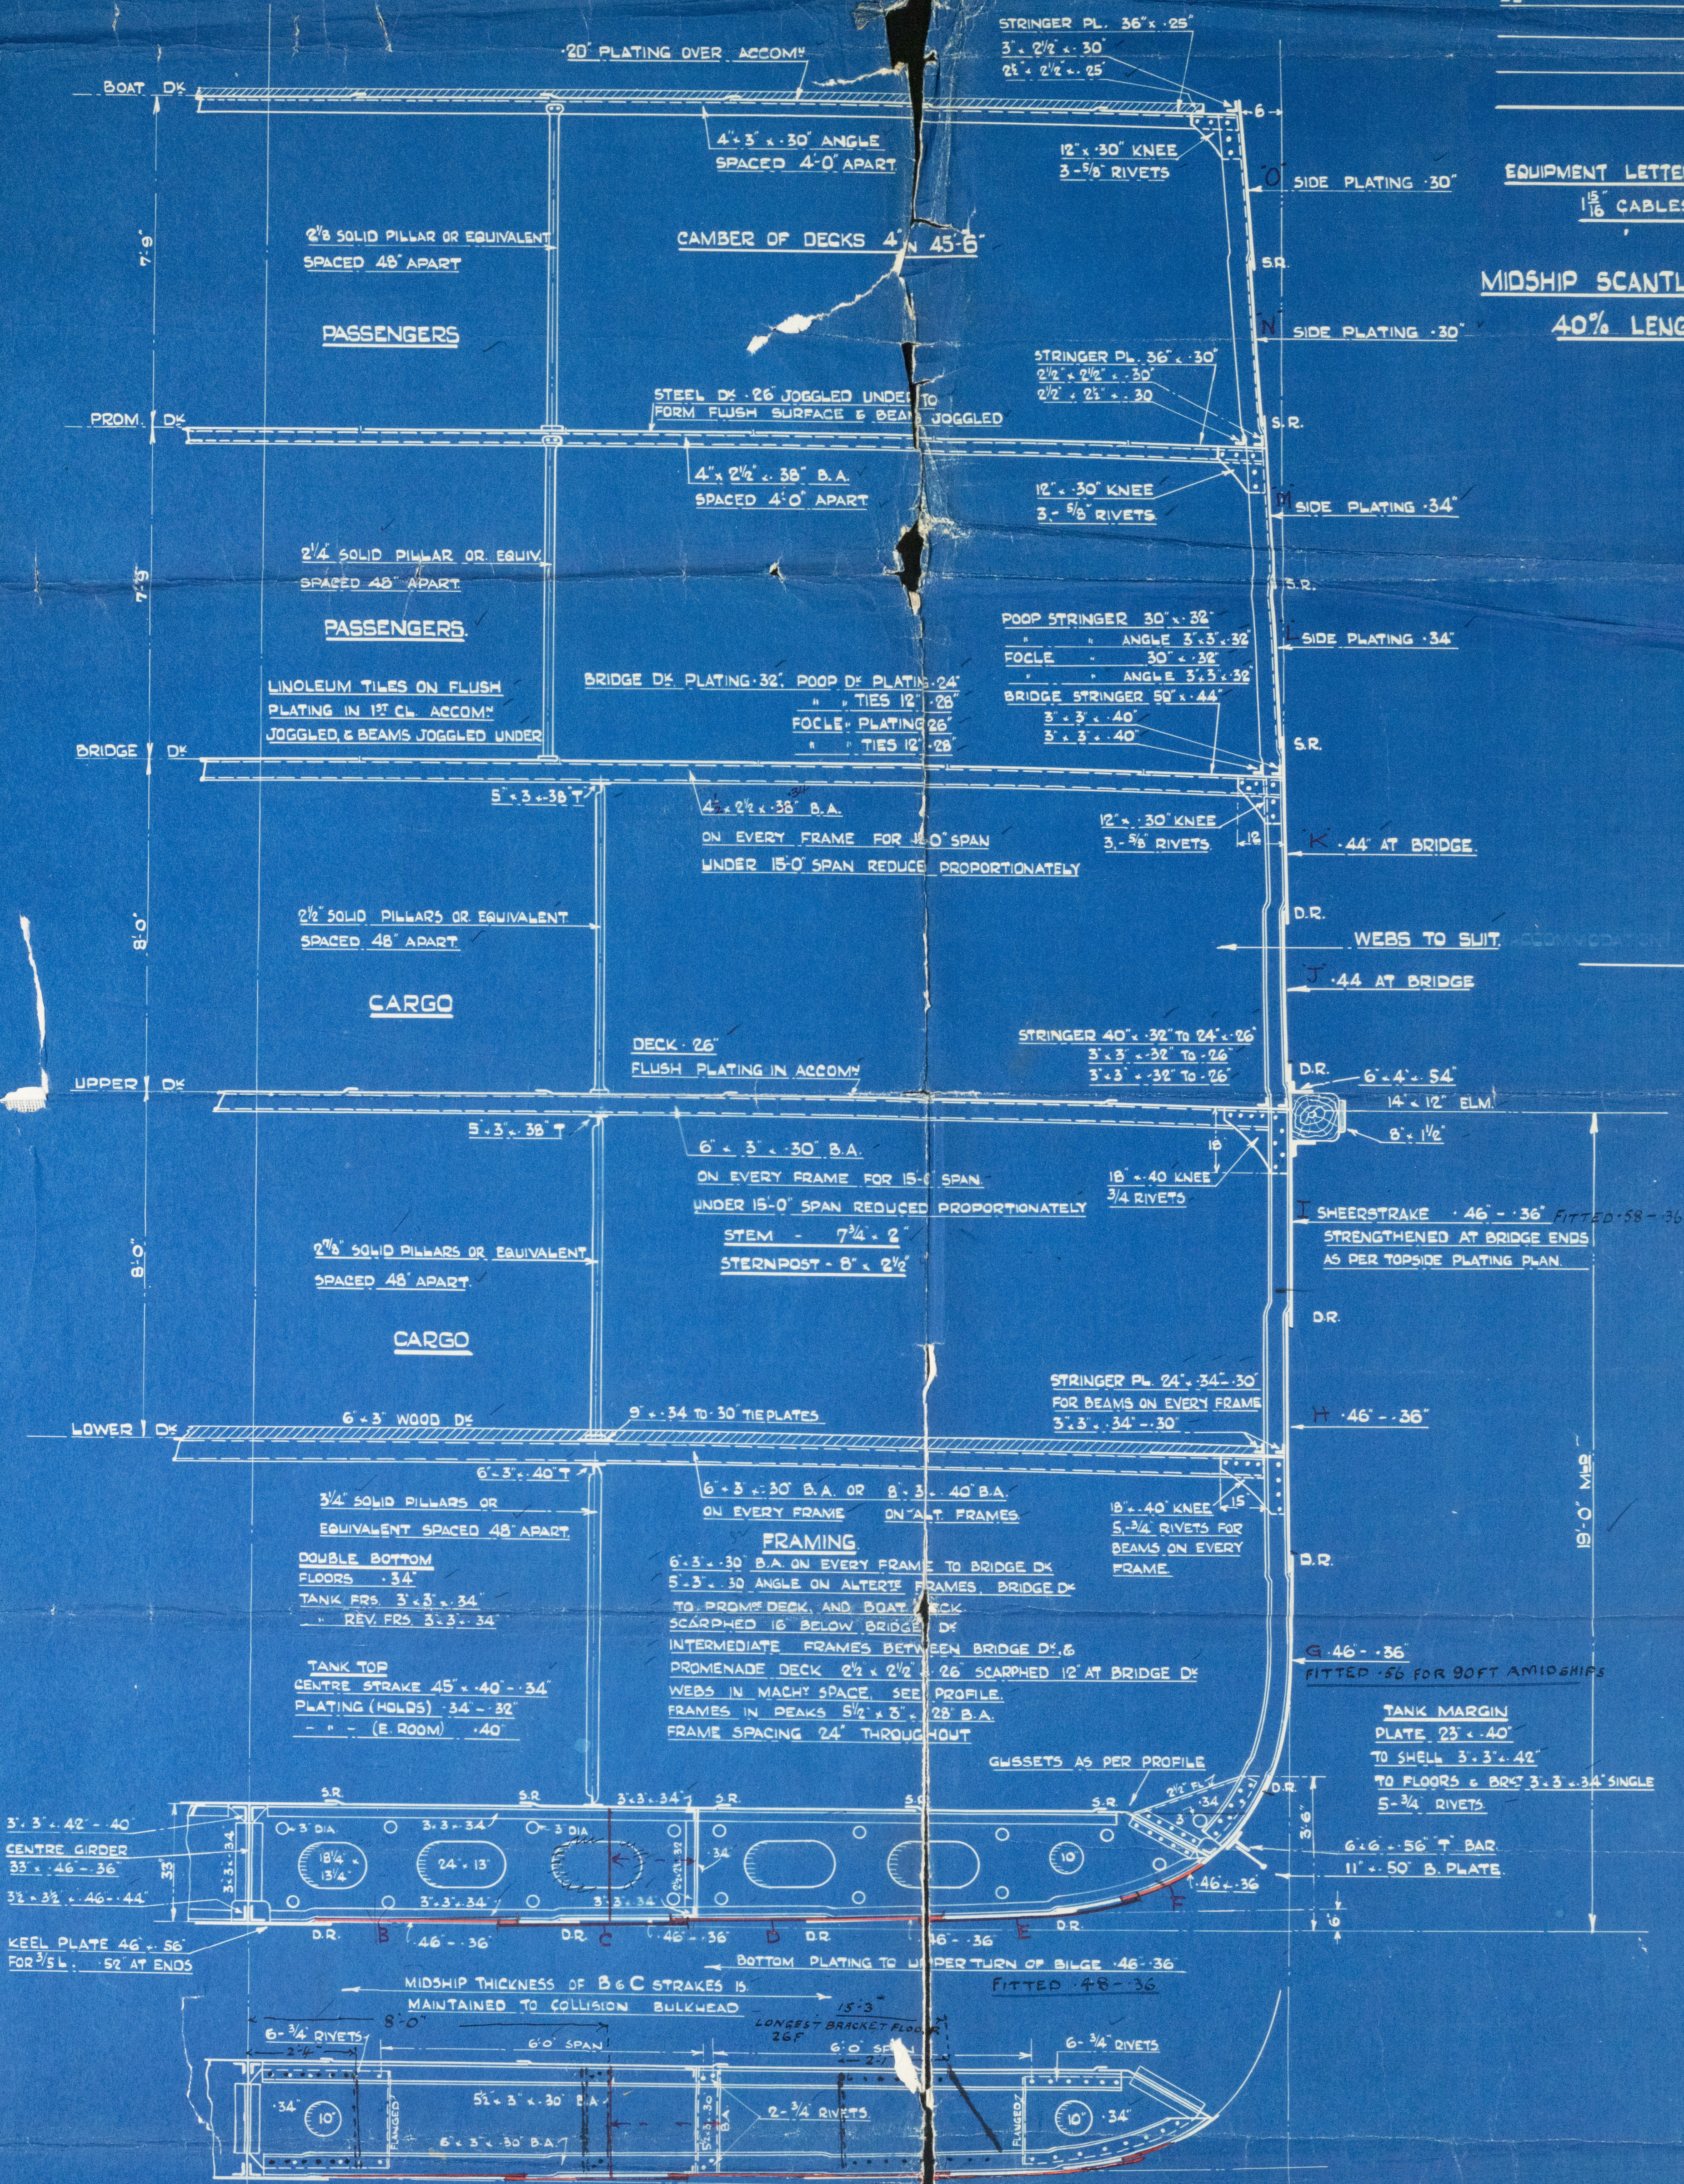

DETAIL OF BRACKET FLOOR

SOLID FLOORS ON EVERY 3RD FRAME - CLEAR OF ENGINE RM.

14.2.29.

60/109
R

& Wolff Ltd.

Nº 870

Midship Section

S.S. Innisfallen

REMAIN



© 2020

Lloyd's Register
Foundation