

2/5 Glassford

Rpt. 6.

For the information of Surveyors and the Committee only.

Received at \_\_\_\_\_ Office \_\_\_\_\_ 19

# Lloyd's Register of Shipping.

(Report on Vessel No. 39499 Port Glasgow)

## No. SHIP FORGINGS OR CASTINGS.

I have to report that the undermentioned Iron or Steel Forgings or Castings, manufactured by Messrs J. S. Forster & Sons Ltd of Sunderland, for the Vessel No. 305, being built by Ardrossan Drydock Co. of Ardrossan, have been inspected by me as set forth below and found to be, so far as can be seen, Sound.

The words FORGINGS or CASTINGS, IRON or STEEL, should be struck out as may be required.

Mark on Forgings or Castings.

Lloyd's  
No. 1659


D. D. Williamson

Sunderland, 5-6-19



	STERN FRAME.	RUDDER FRAME.	STEM.
Material*	<u>Scrap Iron</u>	<u>Scrap Iron</u>	/
How made	<u>Forged</u>	<u>Forged</u>	
Dimensions	<u>9" x 6" &amp; 8" x 6"</u>	<u>9 1/2" dia to 7 1/2" dia</u>	
Progress on Inspection	<u>Finished</u>	<u>Forged &amp; Finished</u>	
Date when Inspected	<u>6-1-19</u>	<u>13-1-19 to 5-6-19</u>	
CASTINGS.			
Tests on Standard Test Pieces.			
Tensile Test—			
Tons per square inch			
Extension per cent.			
Cold Bending Test—			
Angle before fracture			
Drop Test—			
Height from ground			
Hammering Test—			
If made according to Rules and found satisfactory			


SKETCHES OF FRAMES SHOWING POSITION AND DESCRIPTION OF WELDS OF FORGINGS.

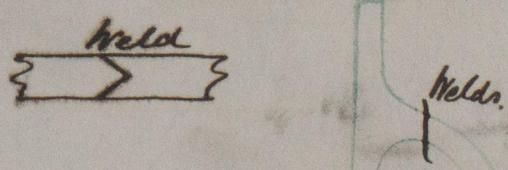

*Mr. Mack*

Fee (if any chargeable) £

To be paid at

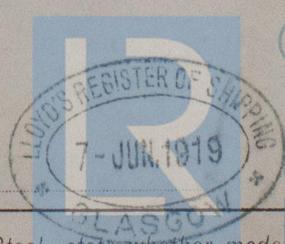


© 2020

Lloyd's Register Foundation

\* If of Iron, state whether scrap or puddled Iron. If of Steel, state whether made on the Open Hearth process.

Glasgow Report no. 39+99.  
S/S Glassford.  
N/N "Jeanne M"

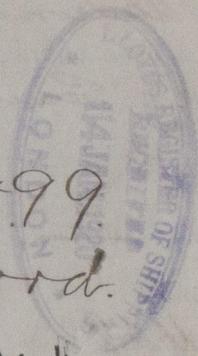

© 2020

Lloyd's Register  
Foundation