

Rpt. 11b.
Ref. No. 32288

VERIFICATION REPORT

EXT N° 7732

Lloyd's Register of Shipping.

SURVEYS FOR FREEBOARD.—STEAM SHIPS.

PARTICULARS RELATING TO ALL STEAM SHIPS EITHER FLUSH DECKED, OR WITH TOP GALLANT FORECASTLES, SHORT POOPS AND BRIDGE HOUSES DISCONNECTED, OR WITH TOP GALLANT FORECASTLES HAVING LONG POOPS, OR RAISED QUARTER DECKS CONNECTED WITH BRIDGE HOUSES, OR OTHERWISE.

W.H.P. ref. 16629
8 MAY 1928
Index No. 32741
(For London Office only)

Port of Survey	West Hartlepool
Date of Survey	Whilst building
Name of Surveyor	A. Pickwock

Ship's Name	Port of Registry and Nationality	Official Number	Appx Gross Tonnage	Date of Build.	Particulars of Classification
"HINDPOOL"	W. Hartlepool British	139256	4850	1928	100 A.I. Contemplated

Registered dimensions from Ship's Register.	Length.	Breadth.	Depth.	Under Deck Tonnage.	Moulded Depth as measured.....	29.52	NOTE — If the depth is measured when vessel is afloat, the details of measurement should be reported.
Length on Loadline.	405.0	53.50	26.50	4621.25	Addition for Keel below base line for draught record.....	inches.	
CORRECTED DIMENSIONS.	405'	52.50	27.44	4641.25			

Co-efficient of fineness.....
Any modification necessary
[Para. 4 (a) to (e)]*
Co-efficient as corrected

.79 -
- .02 Cellular double bottom
.77 -

Sheer { Stem 105 } 153 / 2 = 76.5 Mean .55 = 76.58
at Sternpost 48 50.50
Sheer at $\frac{1}{2}$ of the length from Stem 57.75 / 2 = 42.12 Mean .72
Sternpost 26.50 26.50
Gradual mean Sheer allowed. 76.54
Standard mean Sheer [Table, Para. 18] 60.50 Correction
Difference 26.04 / 4 = 6.51 -
§ If limited as Para. 18 (f) say - 6.5 -

Rise in Sheer { At front of bridge house
from amidships } At after end of forecastle

¶ Fall in Sheer { Para. 18 (d) } $\div 2 =$ ✓
Length uncovered Correction

ALLOWANCE FOR DECK ERECTIONS :—

Freeboard, Table C
Correction for Length, if required (Para. 12, 13, and 14)

4.28

-

Freeboard by Table A. corrected for sheer, and for length, if required (Para. 12, 13, and 14)
Difference
Percentage as below 53.84%

6 - 9 1/2

2 - 7 1/2

16.96

Correction for R. Q. Dk. if engine and boiler openings not covered by bridge house (Para. 11)
Allowance for Deck Erections 53.84% of 31.5 = 16.96 - 1.5

	Length.	Length allowed.	Height.
Forecastle	40.9	40.75	7.6
Bridge House	228.7	228.58	7.6
† Raised Qr. Dk.			
Poop	29.9	29.75	7.6
Total		299.08	7.384
Length of Ship		405.	
Corresponding percentage (Para. 12, 13, or 14)		53.84%	

FREEBOARD recommended amidships from centre of Disc to top of Statutory Deck Line, Wood (Iron) Deck :—

Fresh Water Line	above centre of Disc
Indian Summer Line	" " "
Winter Line	below "
Winter North Atlantic Line	" "

9 - MAY 1928

the frames, skin planking, or ceiling are of unusual thickness the breadth of vessel to indicate the height of the R.Q.D. is to be taken from the level of the top of the amidships beam.

In vessels obtaining an allowance for deck erections under Para. 11 where the sheer drops aft ships the height of the R.Q.D. is to be taken from the level of the top of the amidships beam.

In flush-decked vessels the total standard mean sheer means the sheer measured at the stem and stern-post. In vessels having poops and forecastles, it means the sheer measured at points distant one-eighth of the vessel's length from stem and stern-post.

Port of Survey	West Hartlepool
Date of Survey	Whilst building
Name of Surveyor	A. Pickwock

NOTE — If the depth is measured when vessel is afloat, the details of measurement should be reported.

NOTE — The round of beam should be reported on the full breadth of vessel at the gunwale.

CORRECTION FOR LENGTH.

Length of Ship on Loadline.....	405
Length in Table	354.35
Difference	49.51.6
Correction for 10ft., Table A.	1.5
× Difference divided by 10	7.35
If $\frac{1}{10}$ ths length covered divide by 2	3.64
+ 4" say + 32	

CORRECTION FOR IRON DECK.

Proportion covered, if less than $\frac{1}{10}$ ths length covered	3/10
Thickness of usual wood deck, less stringer	- 3 1/2

CORRECTION FOR ROUND OF BEAM.

Breadth at Gunwale amidships.....	52.83
Round of Beam	13 1/2
Normal round.....	13 1/4
Difference	1/4 ÷ 2 = .12
Proportion of Deck uncovered (Para. 19)26

Freeboard, Table A	7.42
Correction for Sheer	- 6 1/2
Correction for Length	6 - 9 1/2
Allowance for Deck Erections	+ 3 1/4
Correction for Round of Beam	7 - 1 1/2
Correction for fall in Sheer (if any)	- 1 - 5
Correction for Iron Deck (if required)	5 - 8 1/2

Corrections for non-compliance with provisions of Para. 11 (d) and (e)	
Other Corrections (if any)	

Winter Freeboard	5 - 4 1/2
Summer Freeboard	5 1/2
Indian Summer Freeboard	5 1/2
N. A. Winter Freeboard	4 5/6

Correction necessary because clearside amidships, measured in accordance with the Statute is not taken at the intersection of the wood or iron deck with side.

Winter Freeboard from deck line	5 - 6 3/4
Summer " " "	5 - 1 1/4
Indian Summer " " "	4 - 7 1/4
N. A. Winter " " "	5 - 1
Steel " " "	6 3/4
5 - 1 1/2	
4 - 5 1/2	

State dimensions of freeing port area on back of this form.

The Surveyor should state whether the fall in sheer as reported is measured relatively to the straight line of keel or to the water line. If measured relatively to water line the vessel's draft at time of survey, and also the usual load draft forward and aft should be reported.

RECEIVED 1-1 MAY 1928

MARKING FORM © 2020

11770 6.68

2107 244

W984-6218

Lloyd's Register Foundation

Do all the Frames extend to the top height in the Poop? Yes
 Raised Quarter Deck? Yes
 Bridge House? Yes
 Forecastle? Yes
 Channel and bulk angle framing
 To what height do the Reverse Frames extend?
 Has the Poop or Raised Quarter Deck an efficient Iron Bulkhead at the fore end? Yes
 Give particulars of the means for closing the openings in Bulkhead Shifting boards fitted full height in riveted channels.
 Is the Poop or Raised Quarter Deck connected with the Bridge House? No
 Has the Bridge House an efficient Bulkhead at the fore end? Yes
 Give particulars of the means for closing the openings in Bulkhead Hinged steel watertight door.
 What is the thickness of the Bridge Front plating? 40 and Coaming plate? 44
 Give scantlings and spacing of the Stiffeners 9 x 3 x 44 BAs Spaced 30
 Are bracket plates fitted at each end of the Stiffeners? Lugs as app'd Brackets at sides of door Are hor'ls. brackets fitted connecting Bridge Bulk'd. with Bulwarks?
 Has the Bridge House an efficient Iron Bulkhead at the after end? Yes
 How are the openings closed? Shifting boards fitted full height in riveted channels - Steel
 Is the Forecastle at least as high as the main or top-gallant rail? Yes
 Has the Forecastle an efficient Iron or Wood Bulk'd. at after end? Yes
 Are the Engine and Boiler openings covered by a Bridge, Poop, Raised Quarter Deck, or enclosed by a Strong Iron or Steel Deckhouse? Yes
 If the openings are not so protected are the exposed parts of the Casings efficiently constructed?
 Give thickness of plating; scantlings and spacing of Stiffeners
 What is the height of the exposed Casings? 7.6 Are suitable means provided for closing all openings in them in bad weather?
 Are the Weather Deck Hatchways efficiently constructed and at least equal to the requirements of Section 28 of the Rules for 1904-5? Give particulars below: (Plan of Hatchways app'd 17.5.27)

Position and Size.	No 1 24' x 20'	No 2 28' x 20'	No 3 18.8 x 20	No 4 28 x 20	No 5 28' x 20' Nob 18.8 x 20' 10' C
Item.	Ship.	Rule.	Ship.	Rule.	Ship.
COAMING.					
Height above top of DECK	40		31		31
Sides	48		50		48
Thickness					
Ends	44F	46A	44	44	50F 48A 44
SHIFTING BEAMS OR WEB PLATES.	Number	5	4	2 and 1 stl partition	4 3
	Section and Scanlings	Plate 16.2 x 3.5	Plate 15 x 3.4	1 web 16.2 x 3.4	17 x 3.8 14 x 3.5 9 x 2
	Material	4 Angles 4 x 3 x 44	4 Angles 4 x 3 x 44	1 do 12 x 3.1	4 @ 4 x 3 x 44 4 @ 4 x 3 x 44 4 @ 3 x 20
* FORE AND AFTERS.	Number			4 Angles 4 x 3 x 44	
	Section and Scanlings				
HATCHES Thickness	2½	2½	2½	2½	2½ 2½
Remarks					

* The depth of Fore and Afters should be stated from the underside of the hatches in all cases.

(If the sill of the lowest side scuttle will be less than 6 inches above the Indian Summer Load Line if assigned under the tables, state vertical distance from top of deck at side amidships to lower edge of lowest side scuttle.)

The following information is to be given in all Cases of vessels dealt with under Paras. 11, 12 (under which the required depth) and under Shelter Deck Rules.

What is the thickness of the Bridge Sheersbrace?

Delete the words The Crew are not, berthed in the bridge house. that do not apply The arrangements to enable them to go backwards and forwards from their quarters are, are not satisfactory.

Length of Bulwarks in well Forward well 5.33 x 7 x 3

Area of Freeing Ports required by Para. 11 (e) each side of vessel



Ft. Tenths. Ft. Tenths. No.

Fwd	5.33	x	7	x	3
aft	5.415	x	6.6	x	4

Freeing Ports = (each side of vessel)

Aft well 67.8 x 4' = 10.3 ft² 14 ft off Sq. ft. 11.1

Total deficiency or excess = ✓ Sq. ft.

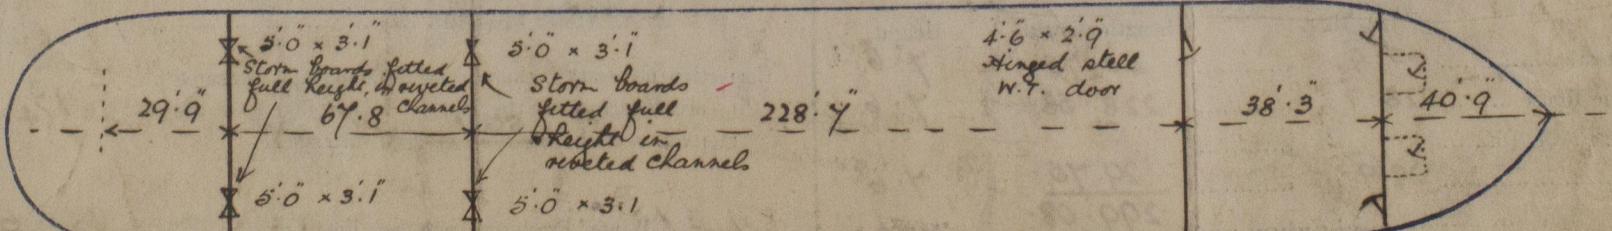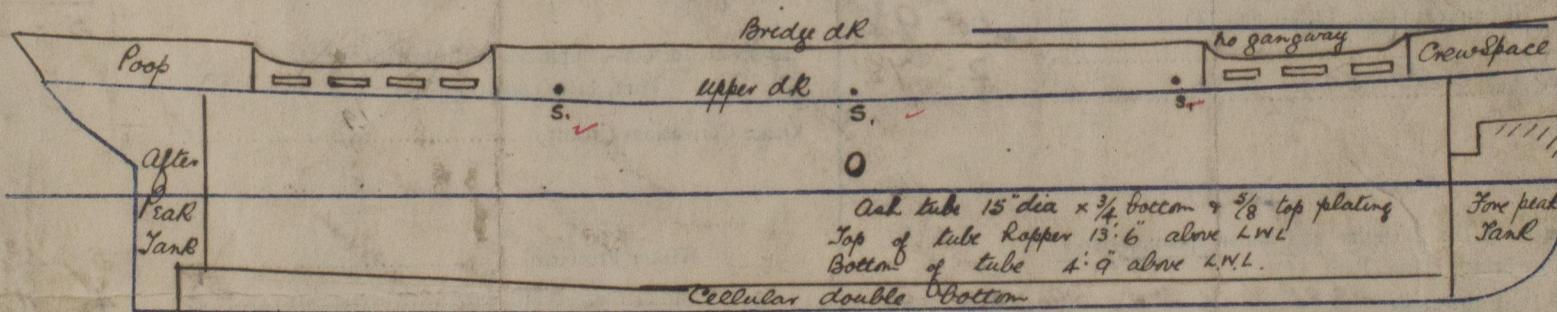

Show hereon line of Floors or Tank Top with position of any Breaks in same; also height of Peak Tank tops, &c., &c.

State any special features in the construction of the Vessel There are no special features.

Builders name and yard no Wm Gray & Co Ltd No 1006

Names of sister vessels: 1/2 Rockpool Fbd Rpt No 16564 1/2 ULLAPOL Fbd Rpt No 16577 & 1/2 MANSEPOOL Fbd Rpt No 16591

Owners The Pool Shipping Co Ltd.

Estimated Address West Hartlepool

Fee £ 9.3.14 Received by me See L.G. Report.

To be charged with F.E.

Copies of all the approved plans in the London Office
The Builders state the displacement at the load draught is 1170 tons and the tons per inch immersion is 44.2
A request for is forwarded to the Lloyd's Register Foundation