

— OF A —  
FULL SCANTLING SCREW STEAMER.

— OF A —

FULL SCANTLING SCREW STEAMER.

## DIMENSIONS

LENGTH - - - - - 363-5

BREATH MLD - - - - - 51-2

DEPTH M/LP - - - - - 25-0%

CLASS 100.A

SCALE  $\frac{1}{2}$  = ONE FOOT

79.5% of reactions

9.2.23.

Lloyds Numerals.

10-6-76 25 ml

Dep'n --- 25.04  
L 78 313 11

1<sup>st</sup> Longitudinal No. 9099-78

B. 74 51 16

40674 = 25.04


$$\frac{20.04}{76.20}$$

Length 363.41

2<sup>nd</sup> Longitudinal  $\eta$ : 24691.84

Depths to Length 14.51 Upper Deck

---  $d_0$  --- 10.99 Bridge Deck

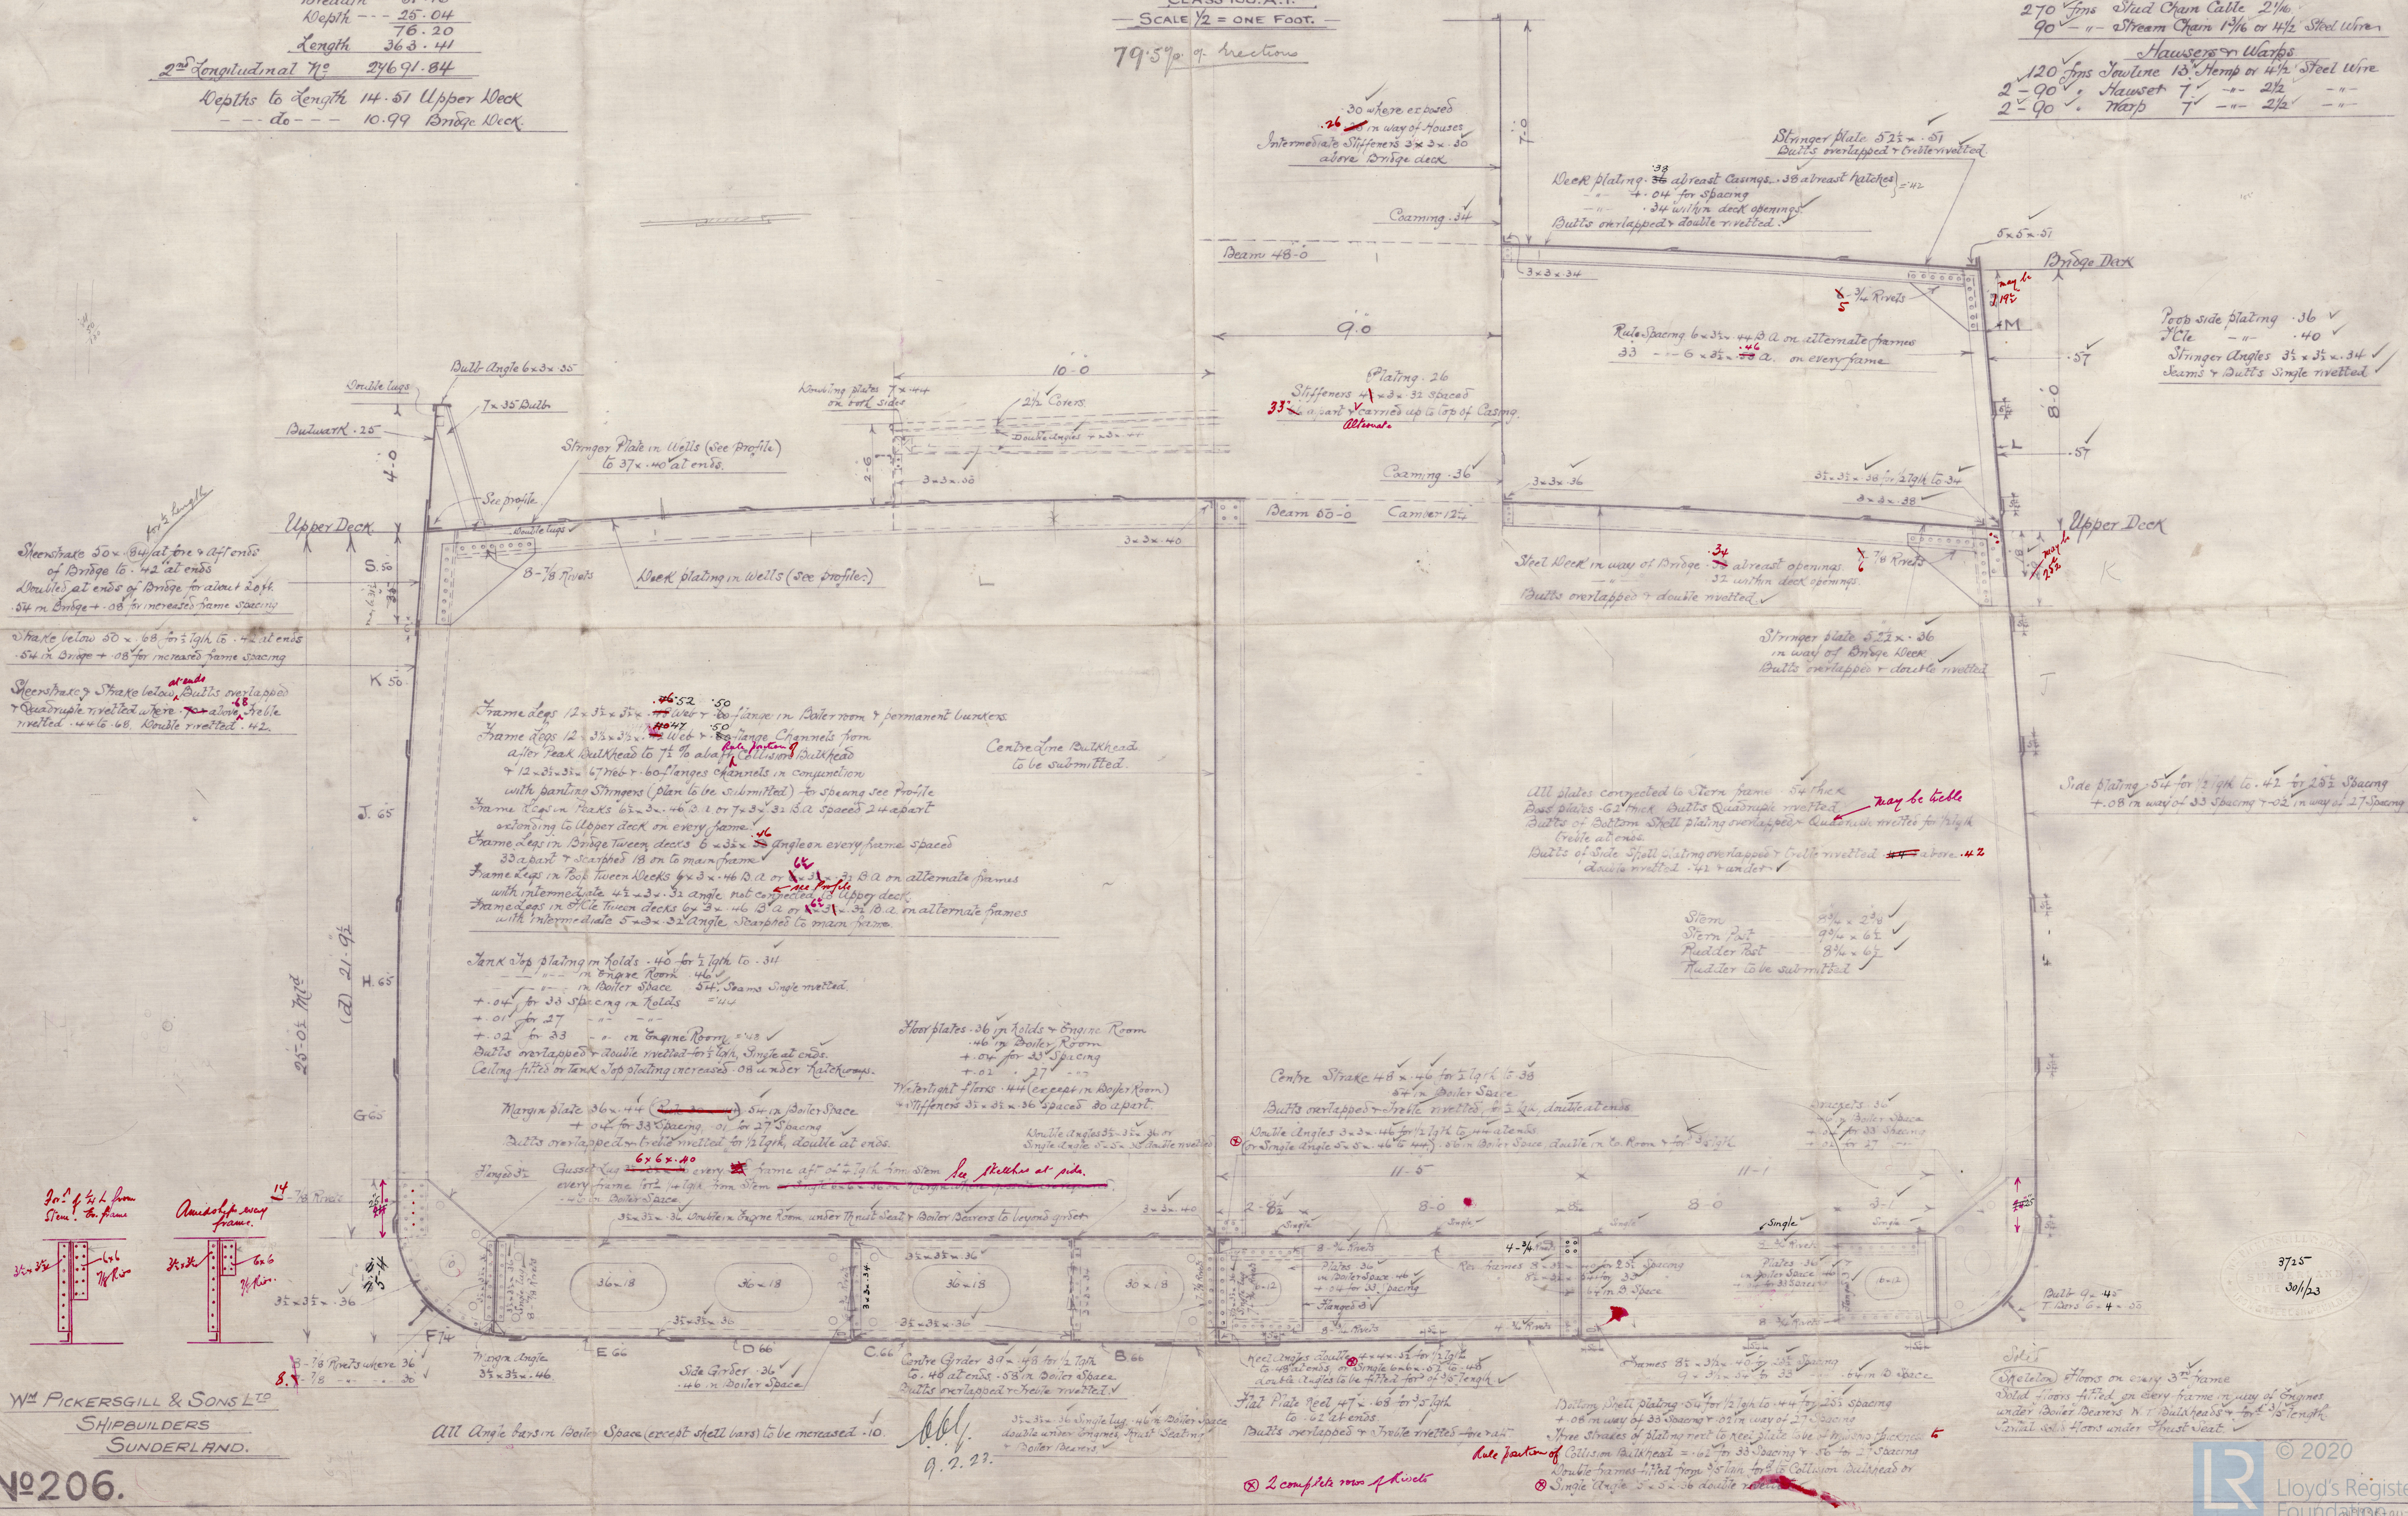

WM PICKERSGILL & SONS LTD  
SHIPBUILDERS  
SUNDERLAND.

№ 206.

3725-  
30/1/23

© 2020  
Lloyd's Register  
Foundation



SUNDERLAND

Wm PICKERSGILL & SONS LTD

AYD 206

MIDSHIP SECTION

363'-5" x 51'-2" hld x 25'-0" mld

"S.S. KILDALE"

SUNDERLAND RPT. NO. 28488



© 2020

Lloyd's Register  
Foundation



206



© 2020

Lloyd's Register  
Foundation

W9938-0117