

- Nos 463-4 - **- MIDSHIP SECTION -**

SCALE $\frac{3}{4}" = 1 \text{ FOOT}$

CLASS. 100 A. LLOYD'S

- DIMENSIONS -

LENGTH B.P. 142' 0"

BREADTH MLD 25' 0"

DEPTH MLD 12' 7"

LLOYD'S NUMERALS

TRANSVERSE NO = 37.58


LONGITUDINAL NO = 5336.36

5' 0" TO UPPER DECK = 142' 12.58" 11.8'

5' 0" TO R.Q. DECK = 142' 6.58" 8.6'

d TO UPPER DECK = 11.33'

d TO R.Q. DECK = 15.33'

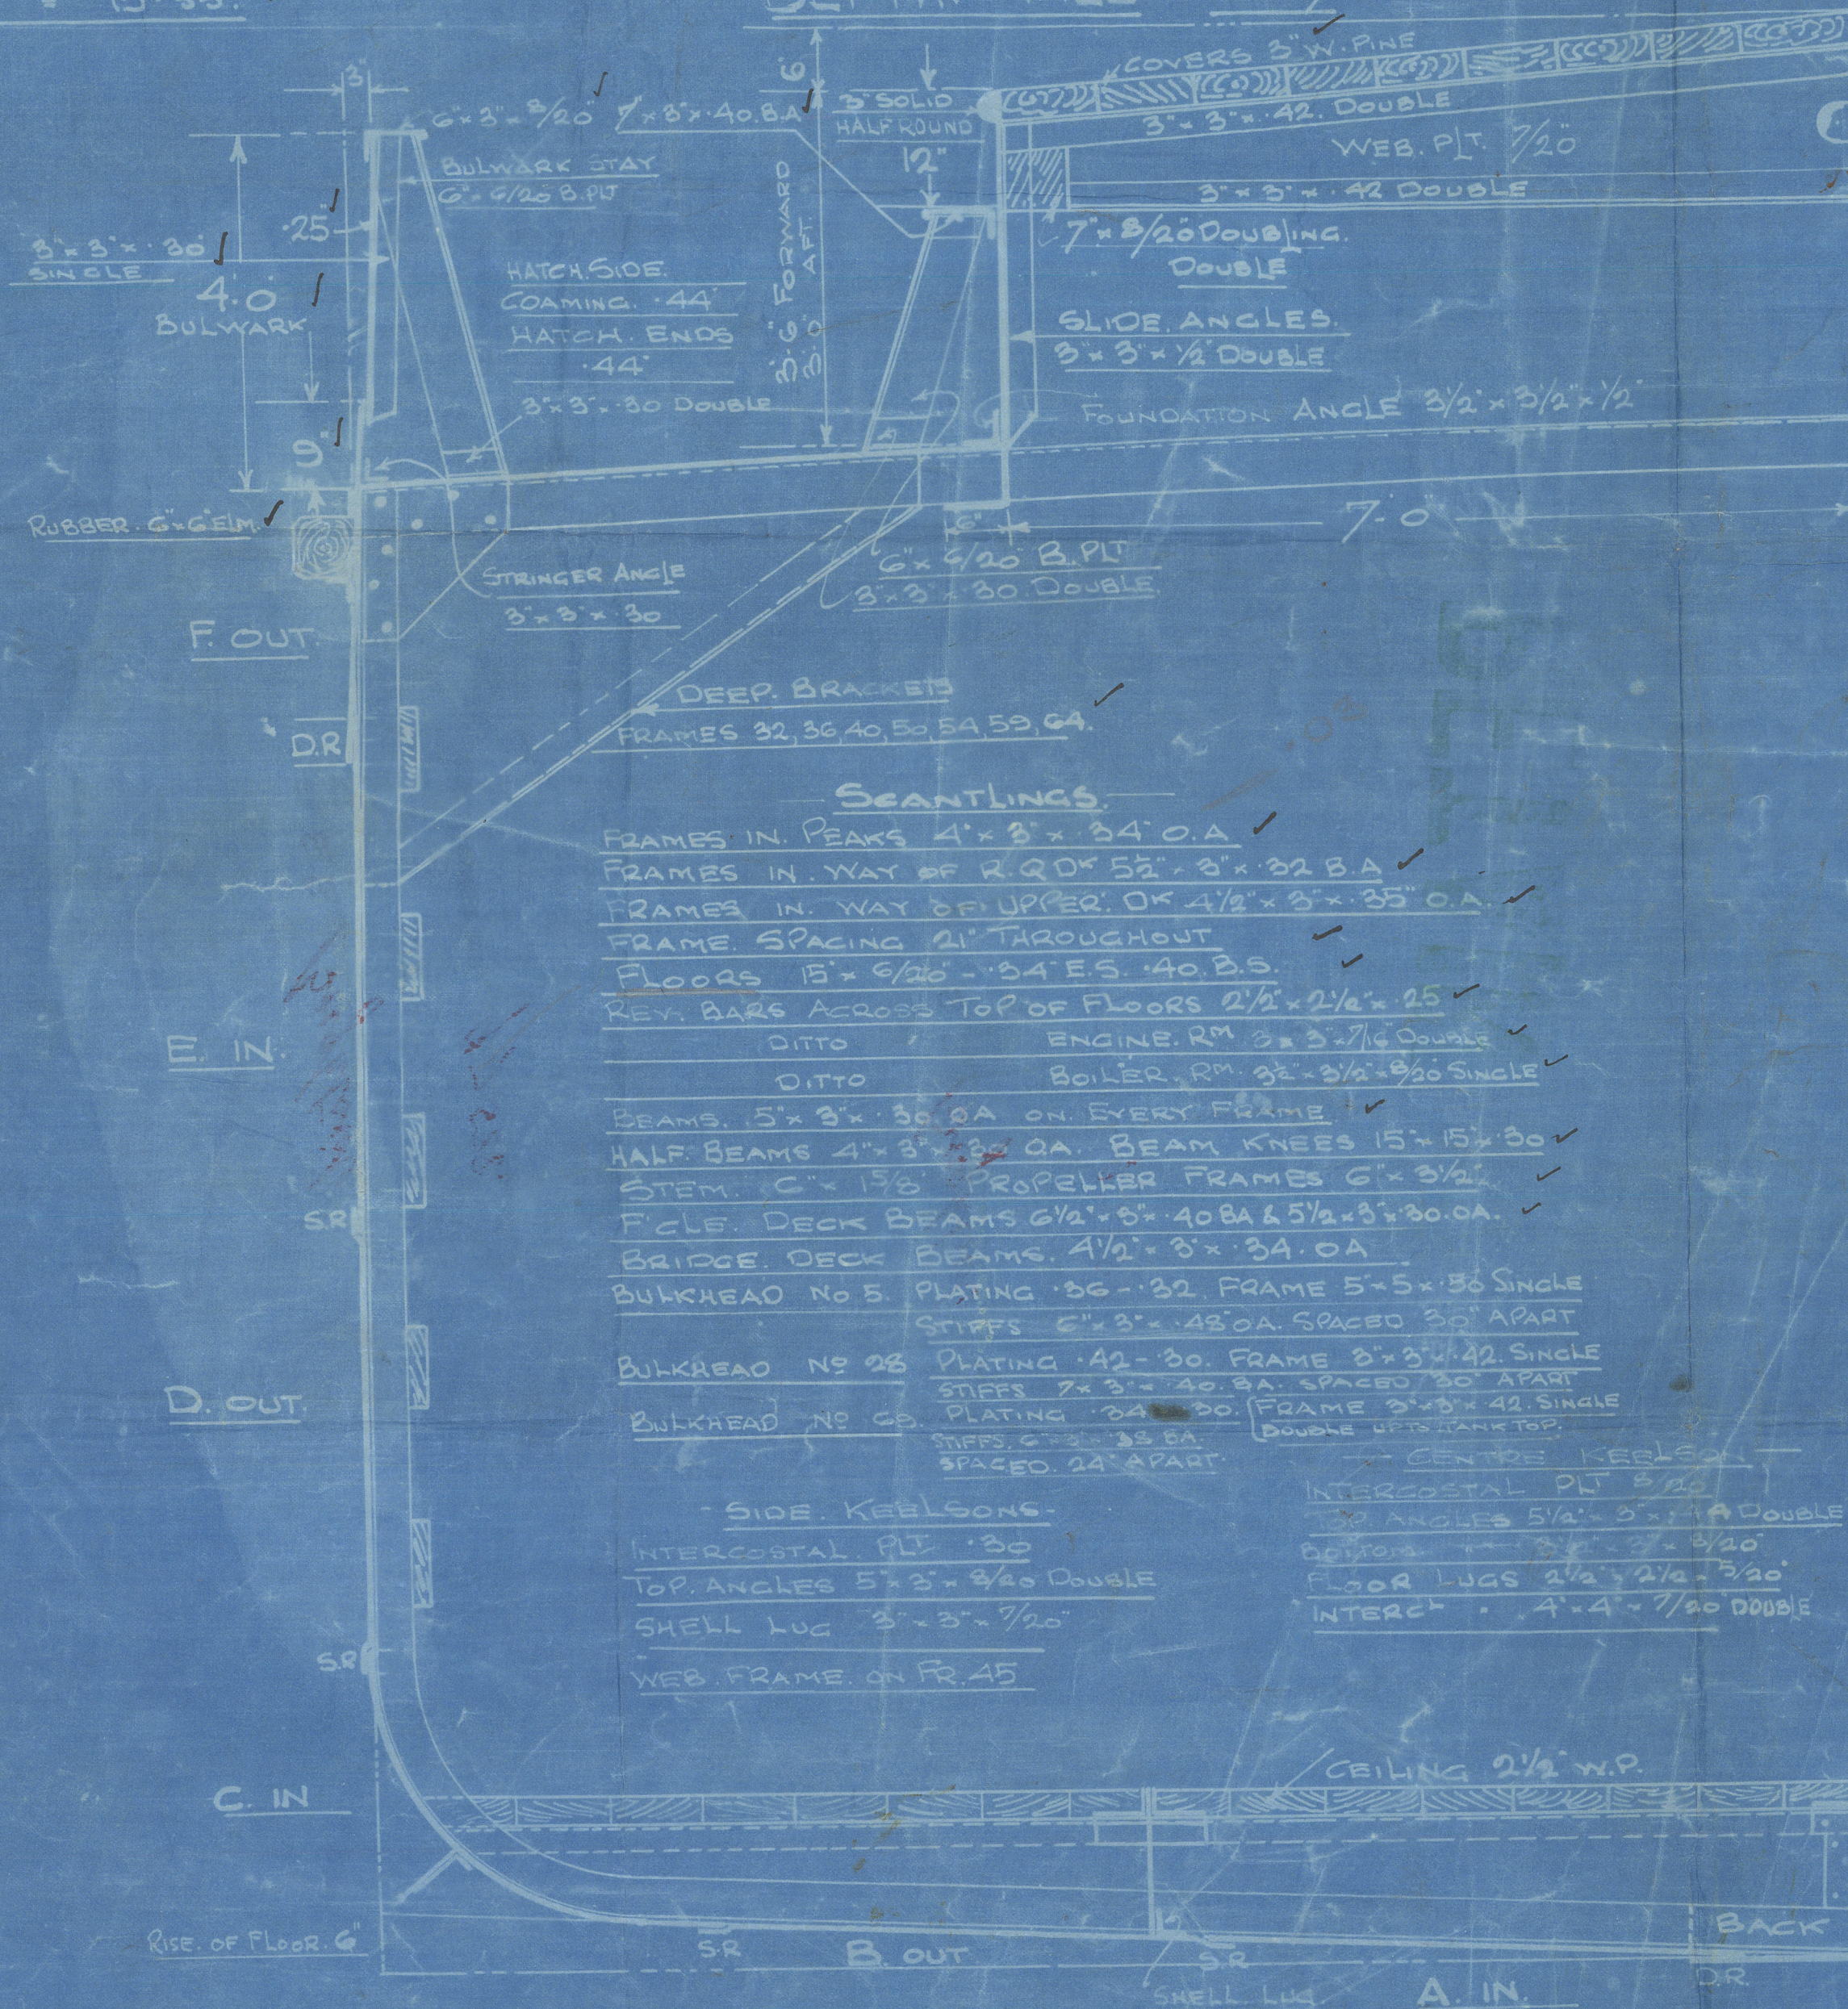

- CASING -

EQUIPMENT. NO 5960.

2. BOWER STOCKLESS ANCHORS EACH 9 CWTs

1. STREAM ANCHOR EX STOCK 3 "

1. KEDGE. " " " 1/4 "

165. FATHOMS 1" STUD LINK CHAIN. CABLE

45 " 2 3/4" STEEL WIRE

20 " 5 1/2" HAWSER

75 " 2 1/2" S.W. TOWLINE

CAMBER .64"

- PLATING -

KEEL .52 - .42 AT ENDS

A. STRAKE .34 FOR FULL LENGTH

B. STRAKE .34 FOR 1/2 L TO 30 AT ENDS

C. STRAKE .34 FOR 1/2 L TO 30 " "

D. STRAKE .38 " " .34 " "

E. STRAKE .40 " " .34 " "

F. SHEER STRAKE IN WAY OF MAIN DECK

.46 FOR 1/2 L TO 34 AT END.

DOUBLE IN WAY OF BREAK.

F. STRAKE IN WAY OF QUARTER DECK

.40 FOR 1/2 LENGTH TO 30 AT END.

G. STRAKE .36 FOR 1/2 L TO 30 AT END. .42 AT BRIDGE

BULKHEAD .25

FORECASTLE SIDE PLATING .32 + .30

DOUBLE FRAMES TO TURN OF BILGE FROM 1/2 L

AMIDSHIPS TO RULE POSITION OF COLLISION B.H.

DECK STRINGER .15/40 - 12/40

PLATING 12/40 STRINGER ANGLE 3" x 3" x 30

INTRA KEELSON FROM 2 L FORWARD


INTERCOSTAL PLATE 6/20

TOP ANGLE 3" x 3" x 6/20. BOT. ANGLE 3" x 3" x 20

BILGE KEEL

7 1/2" x 3 1/8" B.P.L.T.

5" x 3" x 15/40 ANGLE

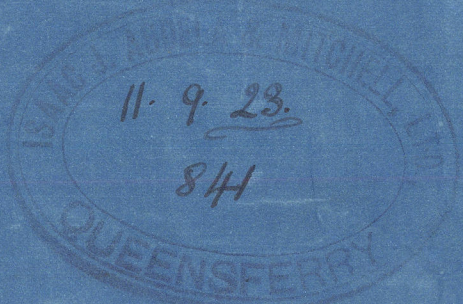

© 2020
 Lloyd's Register
 Foundation

Midship Section
Abdulla Mitchell
85462

MIDSHIP SECTION

YARD N° 464

S.S. Brightside

LIVERPOOL

Report No. 97588

S.S. Brightside

LIVERPOOL

Report No. 97588

RETAIN

© 2020

Lloyd's Register
Foundation

W999-0121