

RECEIVED 6th JUNE 82.
RECEIVED 24th JUNE 82.
RECEIVED 19th OCT. 82.

GENERAL ARRANGEMENT SCREW STEAMER



No 77

SCALE 1/4 INCH TO ONE FOOT



May 30. 1882

S.S. 'Scale Force'

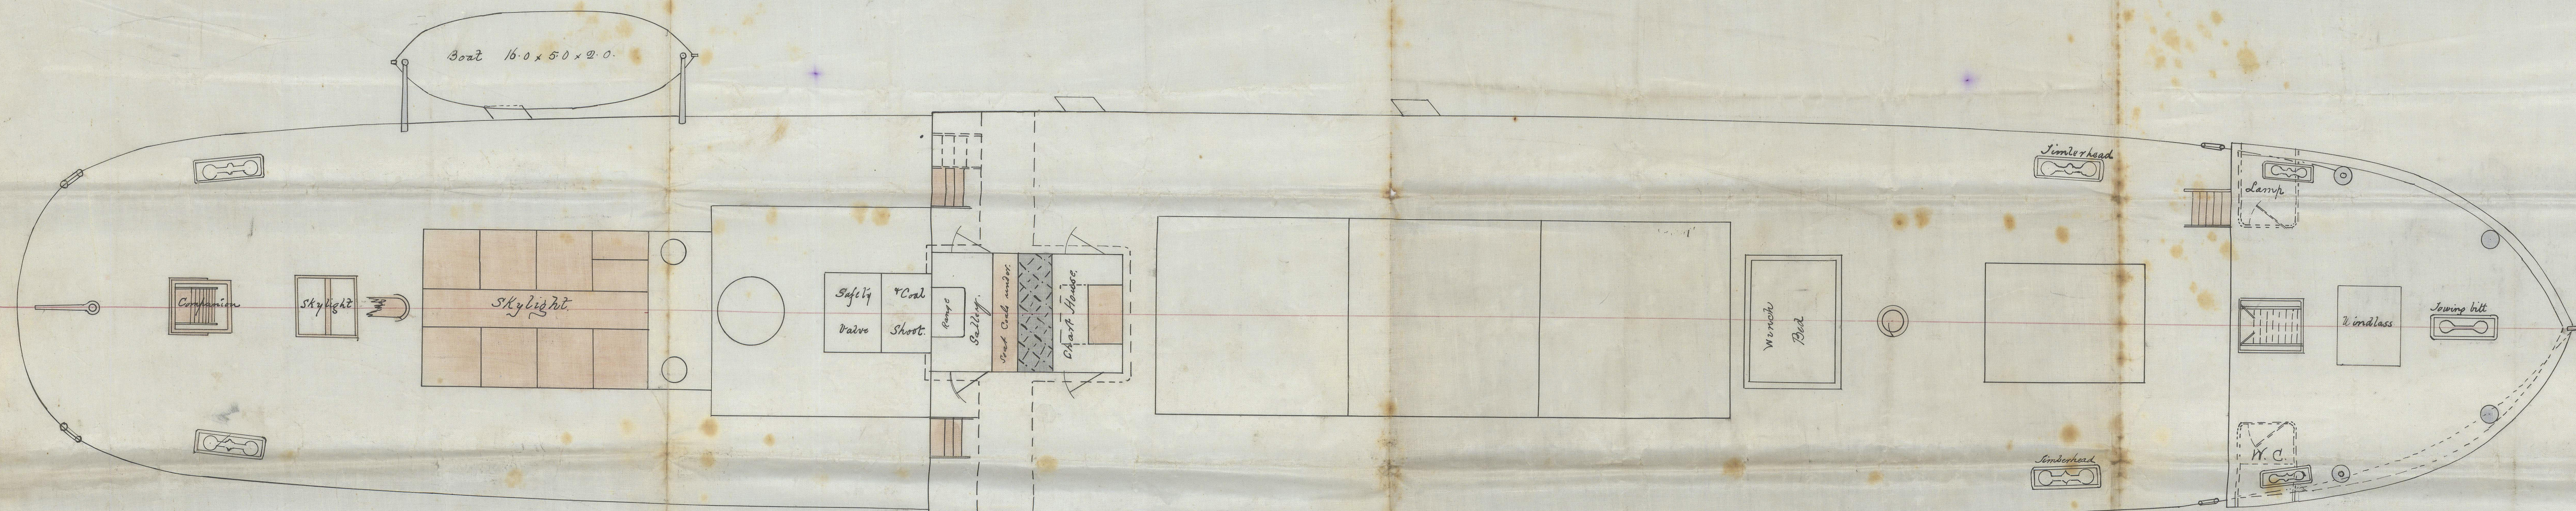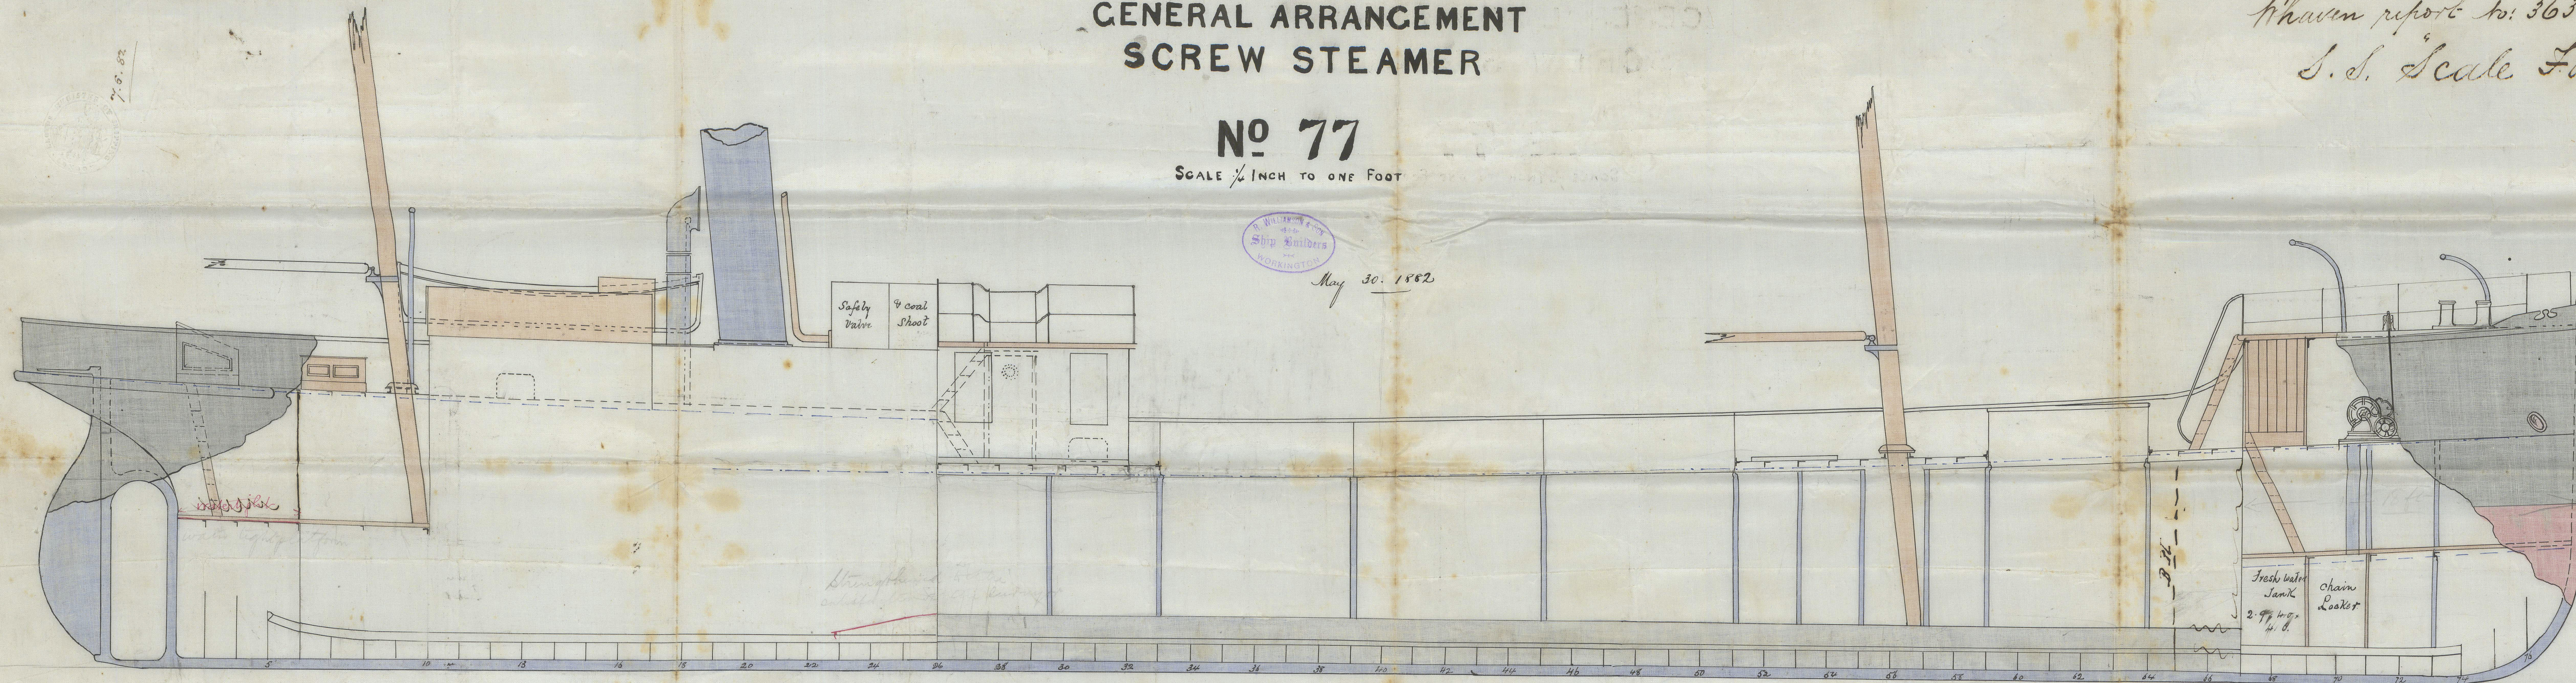

17/6
4/82
26/6/82



© 2021
Lloyd's Register
Foundation