

S. S. Drwent
Whn report to 3708
Lloyd's Register of British and Foreign Shipping.

(Received in the London Office,



F.

No. 314

REPORT ON SHIP FORGINGS.

Sir,

I beg leave to report that the undermentioned Forgings, manufactured by Messrs W. W. Reed & Co of Sunderland for the Vessel No. 80, being built by Messrs R. Williamson & Son of Worthington have been inspected by me in course of being forged and smithed, and found to be, so far as can be seen, sound and efficient.

W. S.
6/9/83

Mark on Forging.

Lloyd's
No. <u>314</u>
<i>5/83</i> <u>W.C.</u> <i>8/83</i>

I am, Sir,

Your Obedient Servant,


J. Cameron,

The Secretary,
London.

Sunderland

	STERN FRAME.	RUDDER FRAME.	STEM.
Material*	<i>Scrap Iron</i>	<i>Scrap Iron</i>	
How made	<i>Forged</i>	<i>Forged</i>	
Dimensions	<i>6 1/4 x 3 1/4</i>	<i>3 1/4 x 2 1/2</i>	
Progress on Inspection	<i>Forging & smithing</i>	<i>Forging & smithing</i>	<i>Not seen</i>
Dates when Inspected	<i>April 18-25-30 May 2-11th</i>	<i>July 10-18-25-28 Aug 1-14 10-23-31st</i>	

SKETCHES OF FRAMES SHEWING POSITION AND DESCRIPTION OF WELDS.

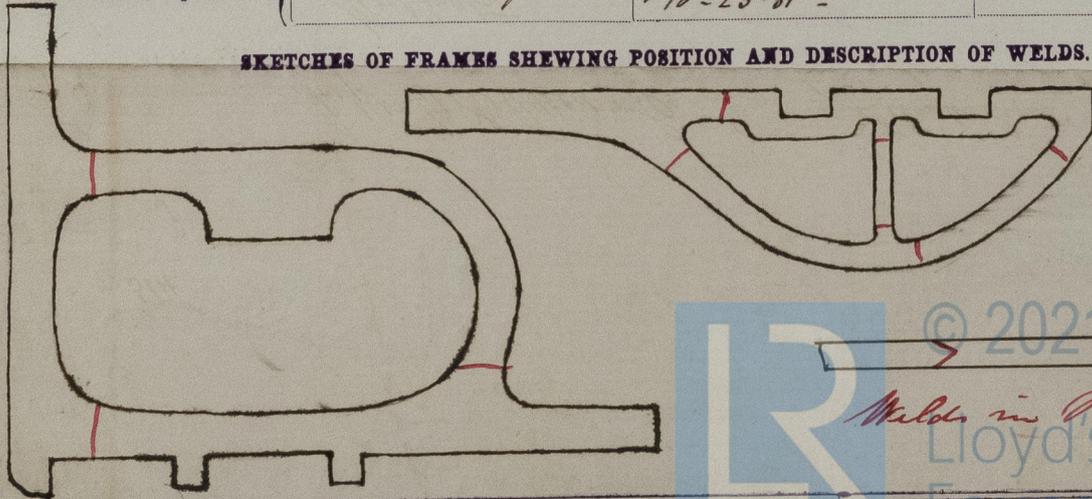

© 2021
Welds in Red
 Lloyd's Register
 Foundation

If of iron, state whether scrap or puddled iron.