

Lizzie & Annie

Ann Reeves

Cart.

Mill Sheet

2 prints

Hull rept. No. 43132

(attached to
Hull rept. 43208)



© 2018

Lloyd's Register
Foundation


MILD STEEL AIR RECEIVER 16" INSIDE DIA X 4'-0" HIGH.

A.K. 124 B

1 OFF

A.E. WOODWARD LTD


HULL

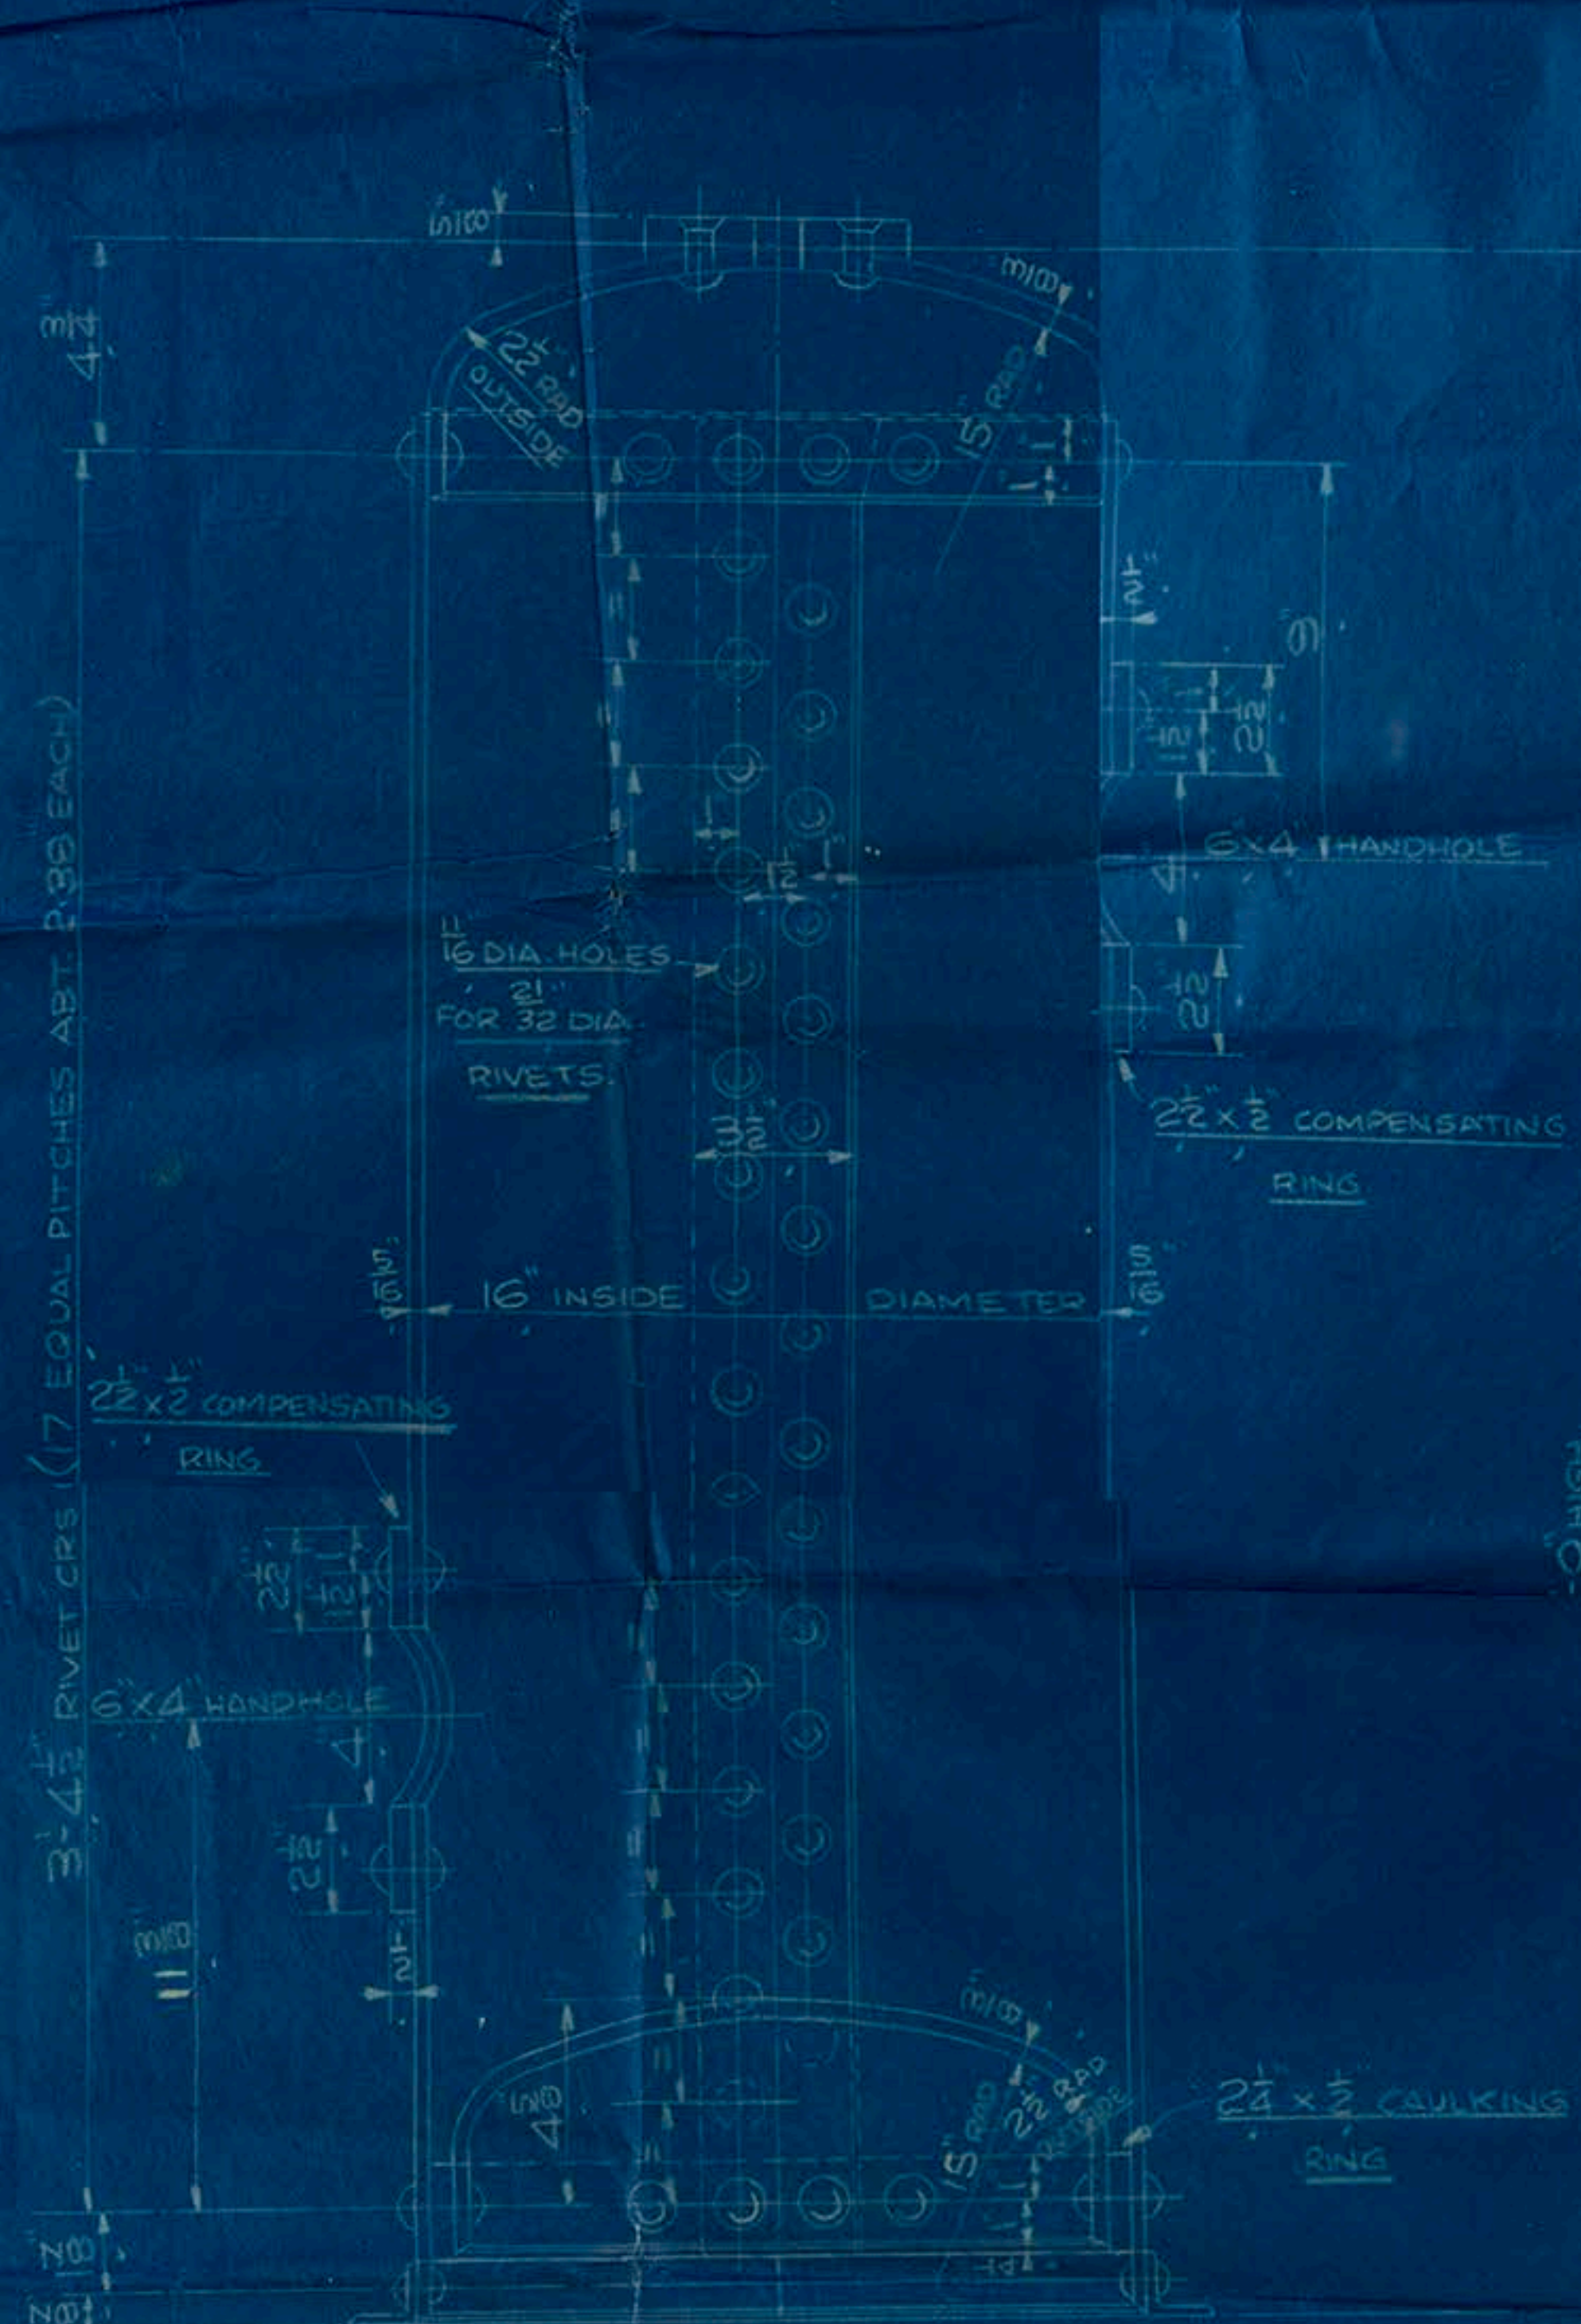

WORKING PRESSURE 260 LBS./SQ. IN.

TEST PRESSURE 440 LBS./SQ. IN.

RECEIVER TO PASS LLOYD'S SURVEY

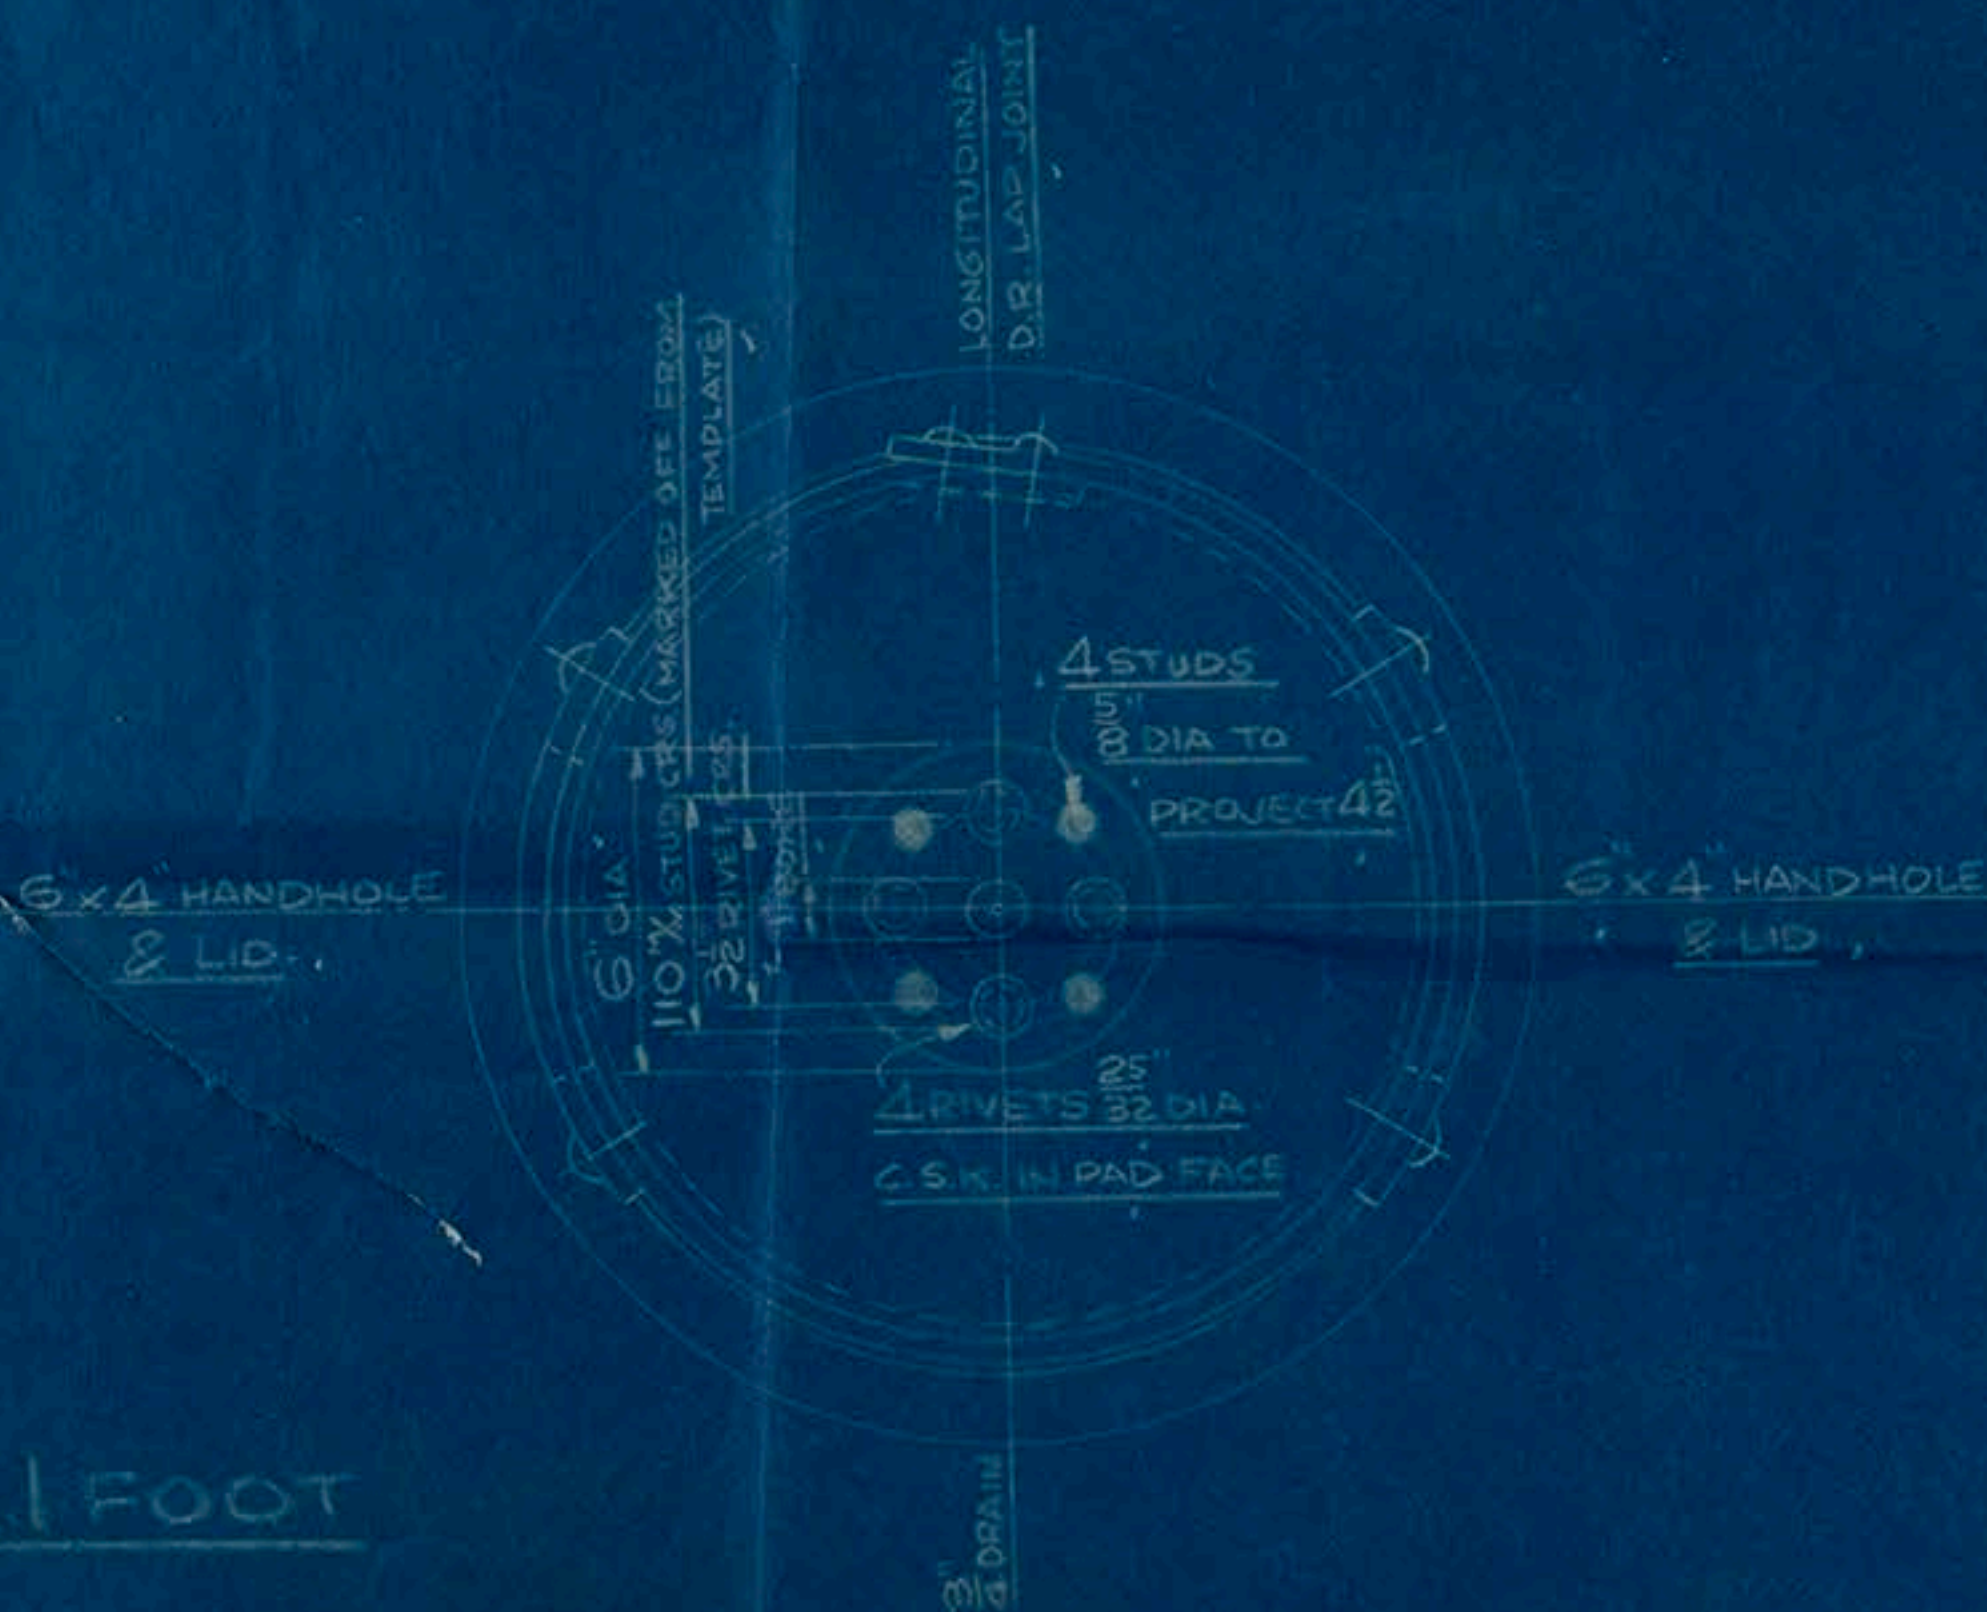

PAD FOR BORE DRAIN

SCALE: 3" = 1 FOOT

REVISION: NOV 2ND 1932
BOTTOM END PLATE DISHED
INWARDS INSTEAD OF OUTWARDS

DAILY BROTHERS LIMITED
No. 8.10305
ENGINEERS
PARK IRON WORKS
OCT. 17TH 1932
SHEFFIELD

ENCLOSURE
No. 579

B. 10305.

R

Lloyd's Register
Foundation