



TYP 3222H2

41808

RITN. N^o 21-683.

12 NOV 1935

MATERIAL SM.S.

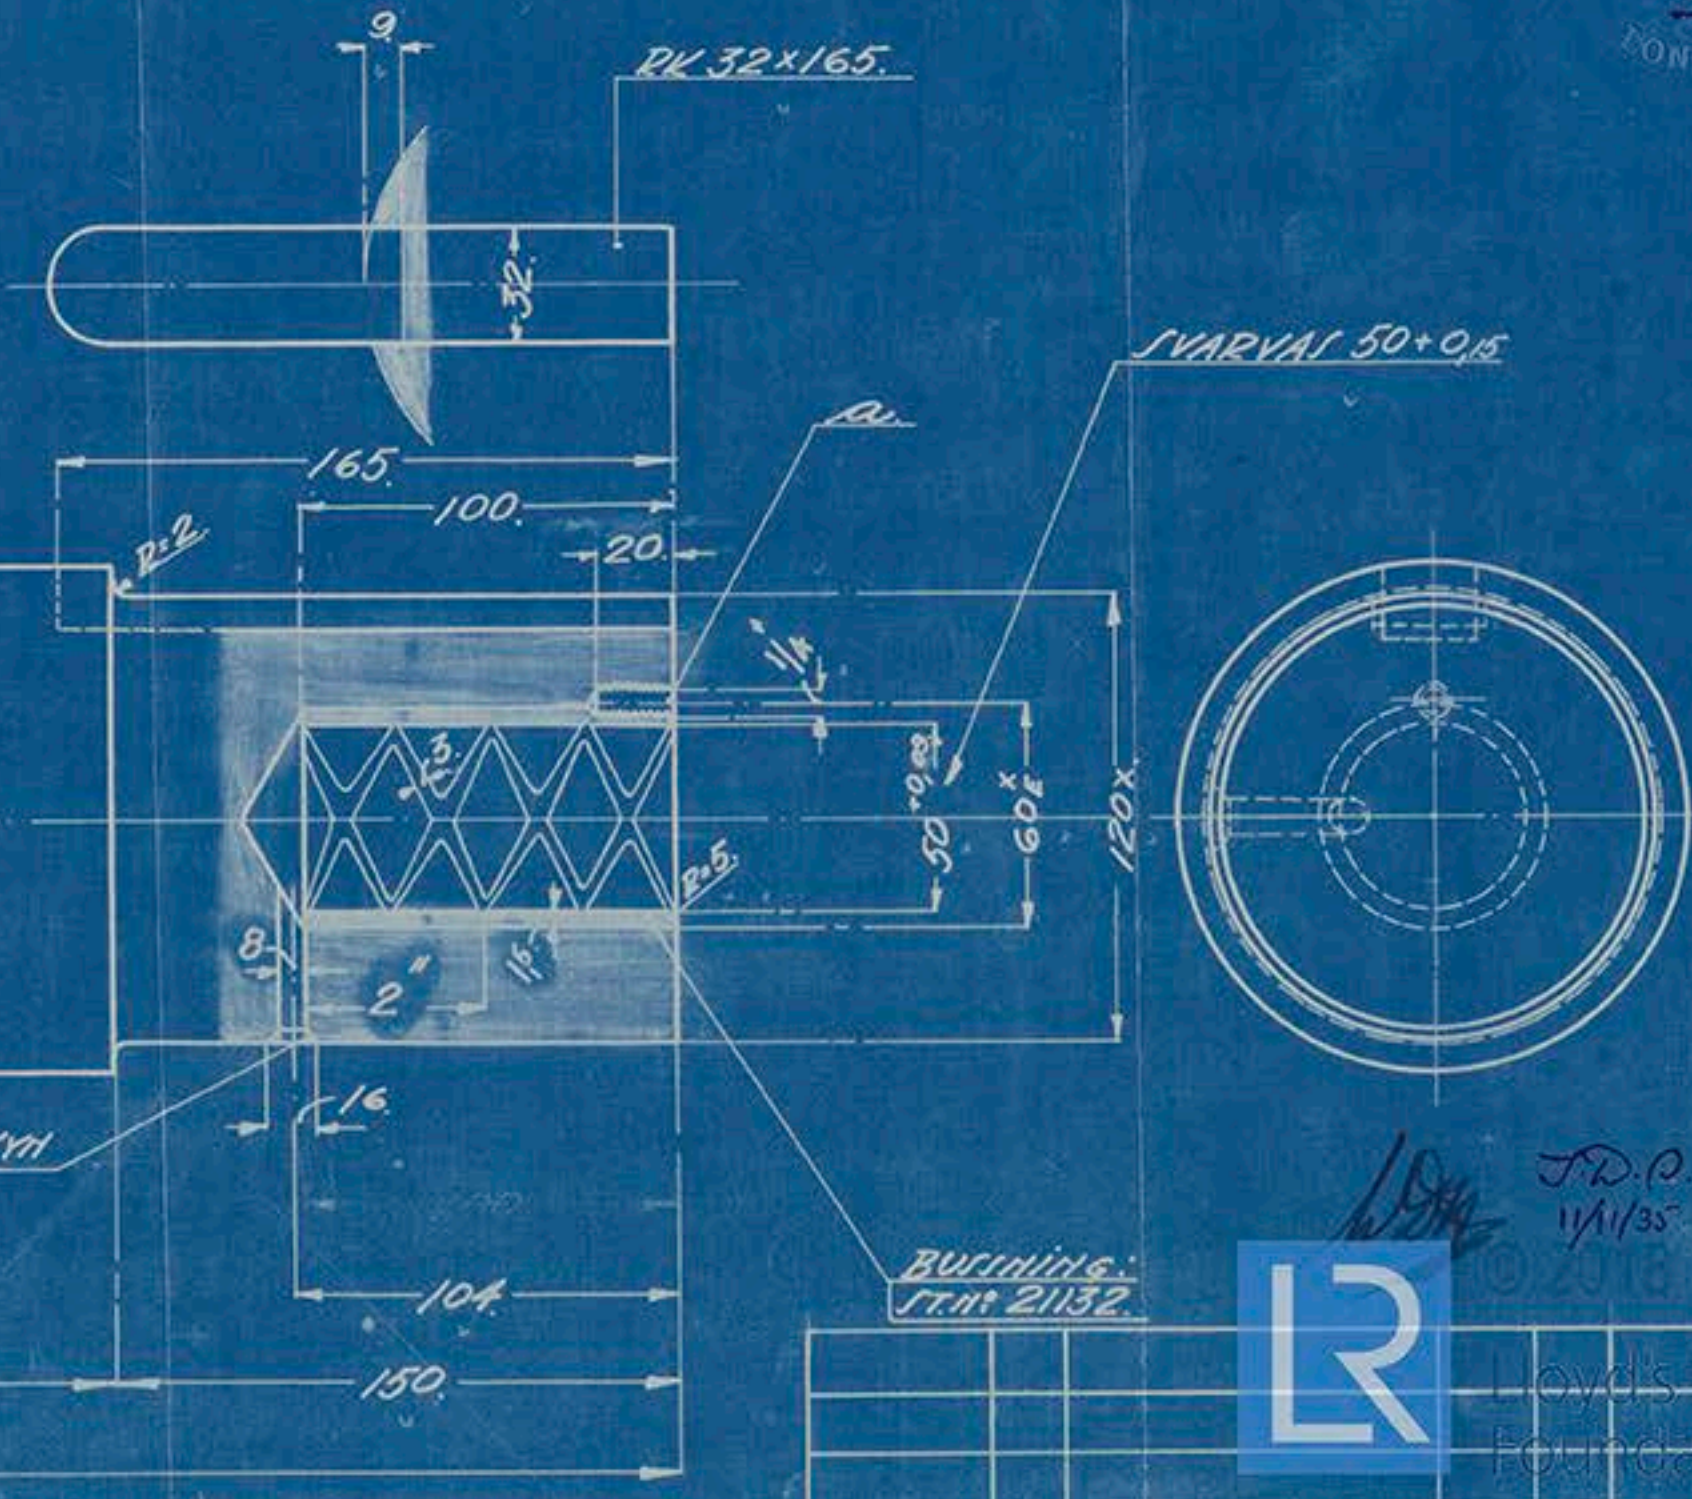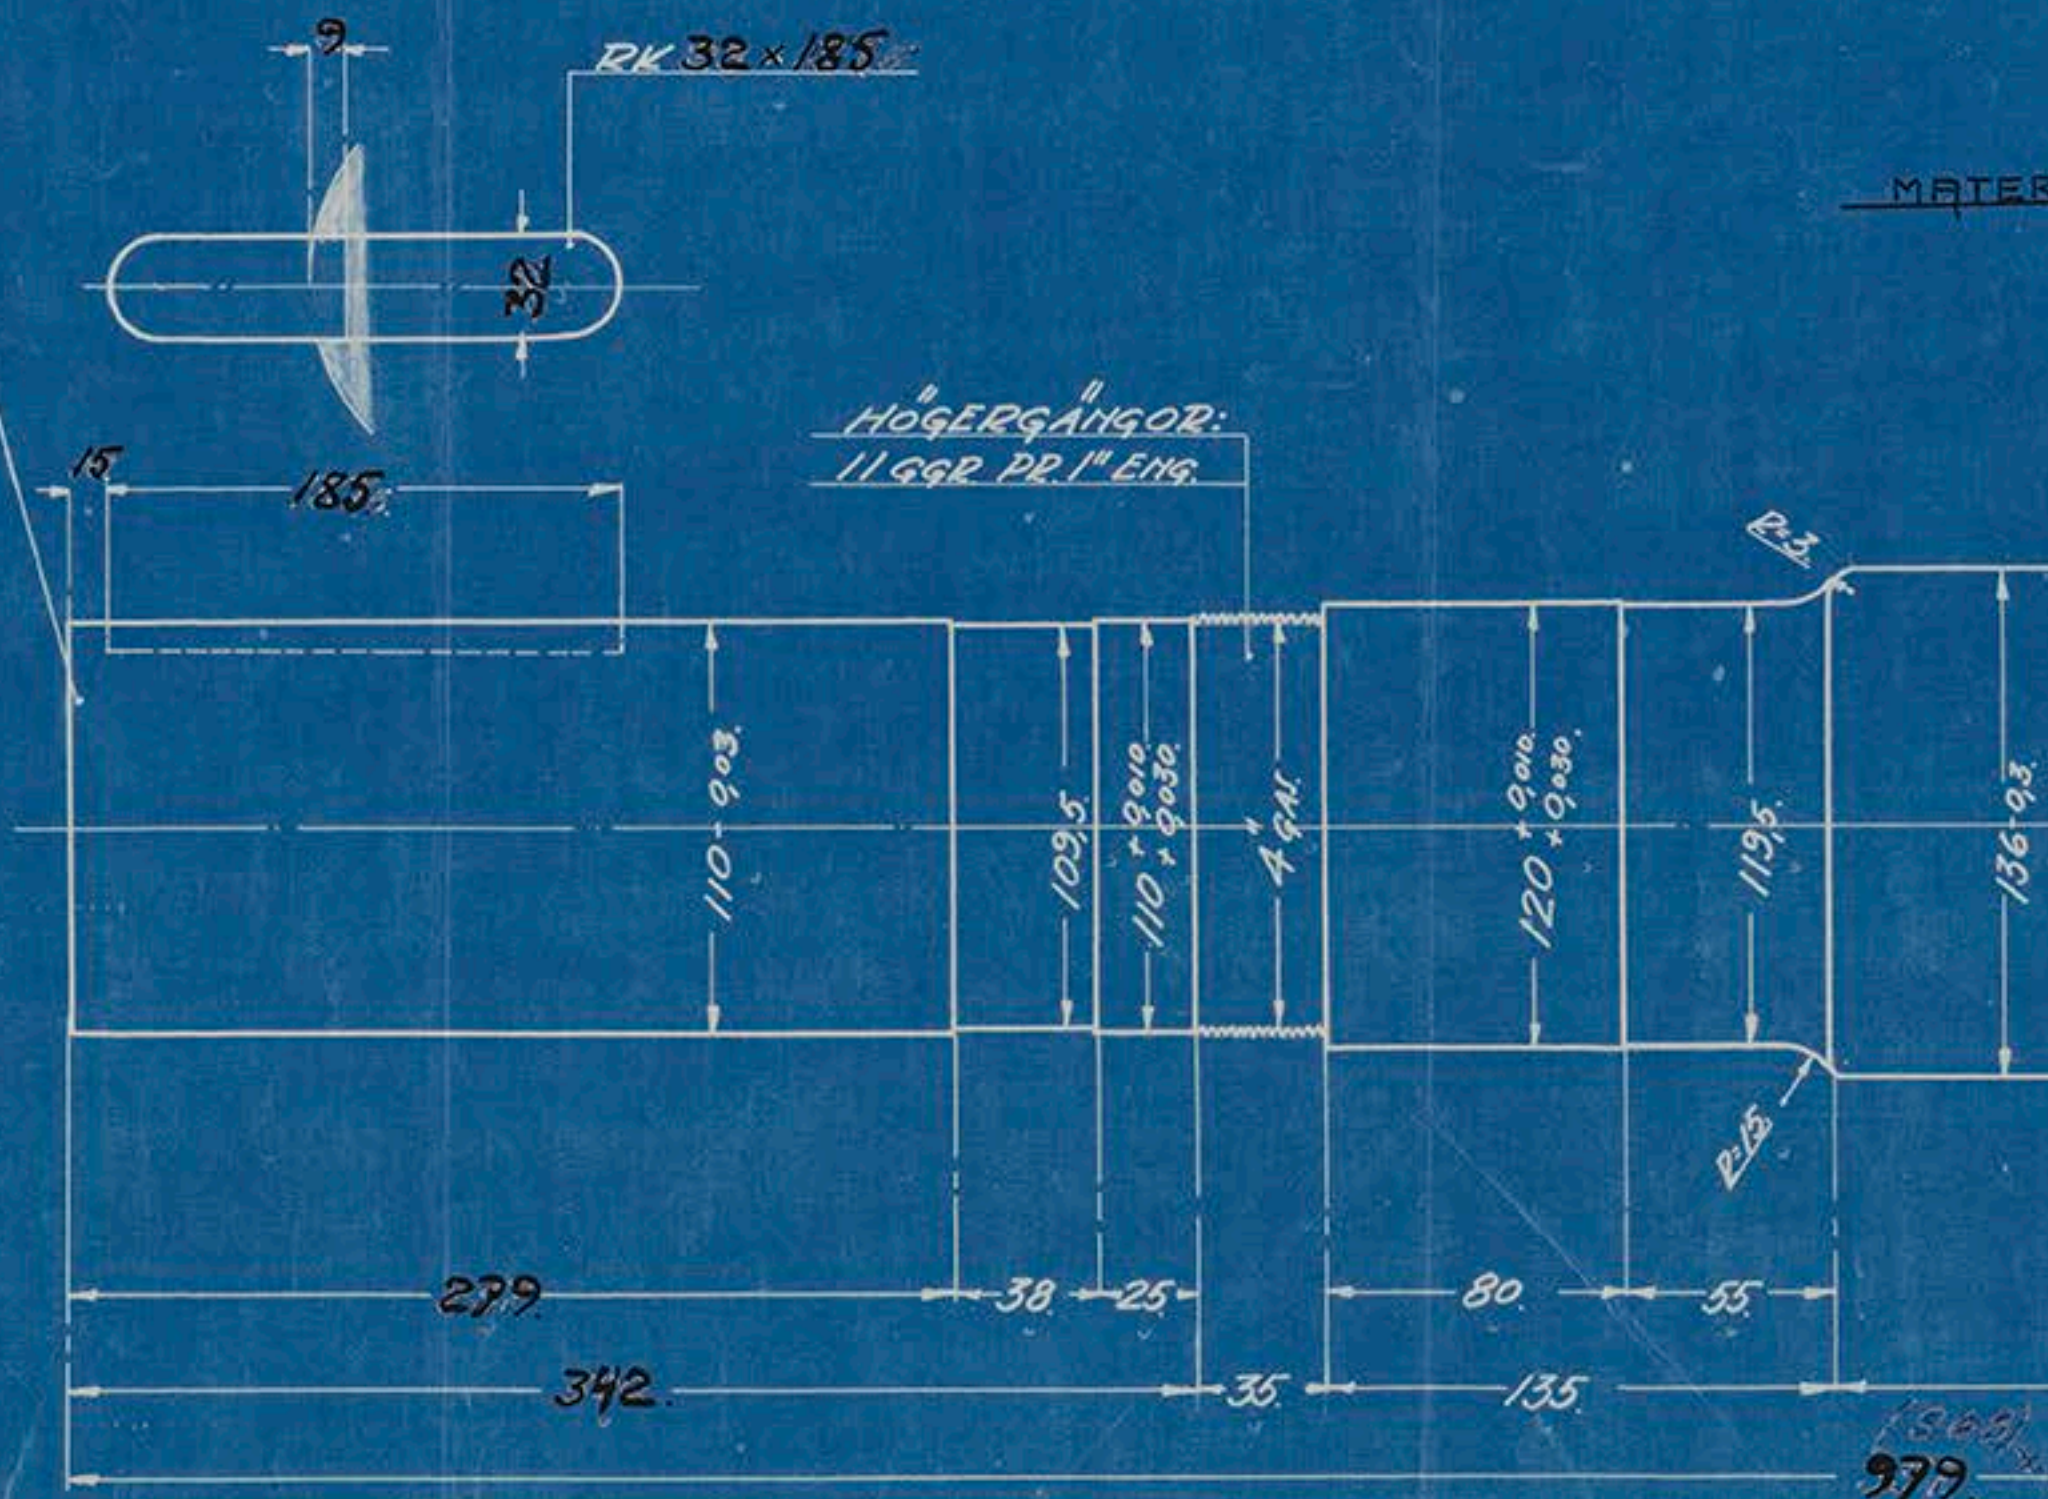

HÅLETS RÄTTA LÅGE ENL. ÄNDVYH



Lloyd's Register Foundation

HULL

M.V. "Lizzie & Annie".
L. —.

Hull 46562



© 2018

Lloyd's Register
Foundation

LR-FAF-SA13-P-15