

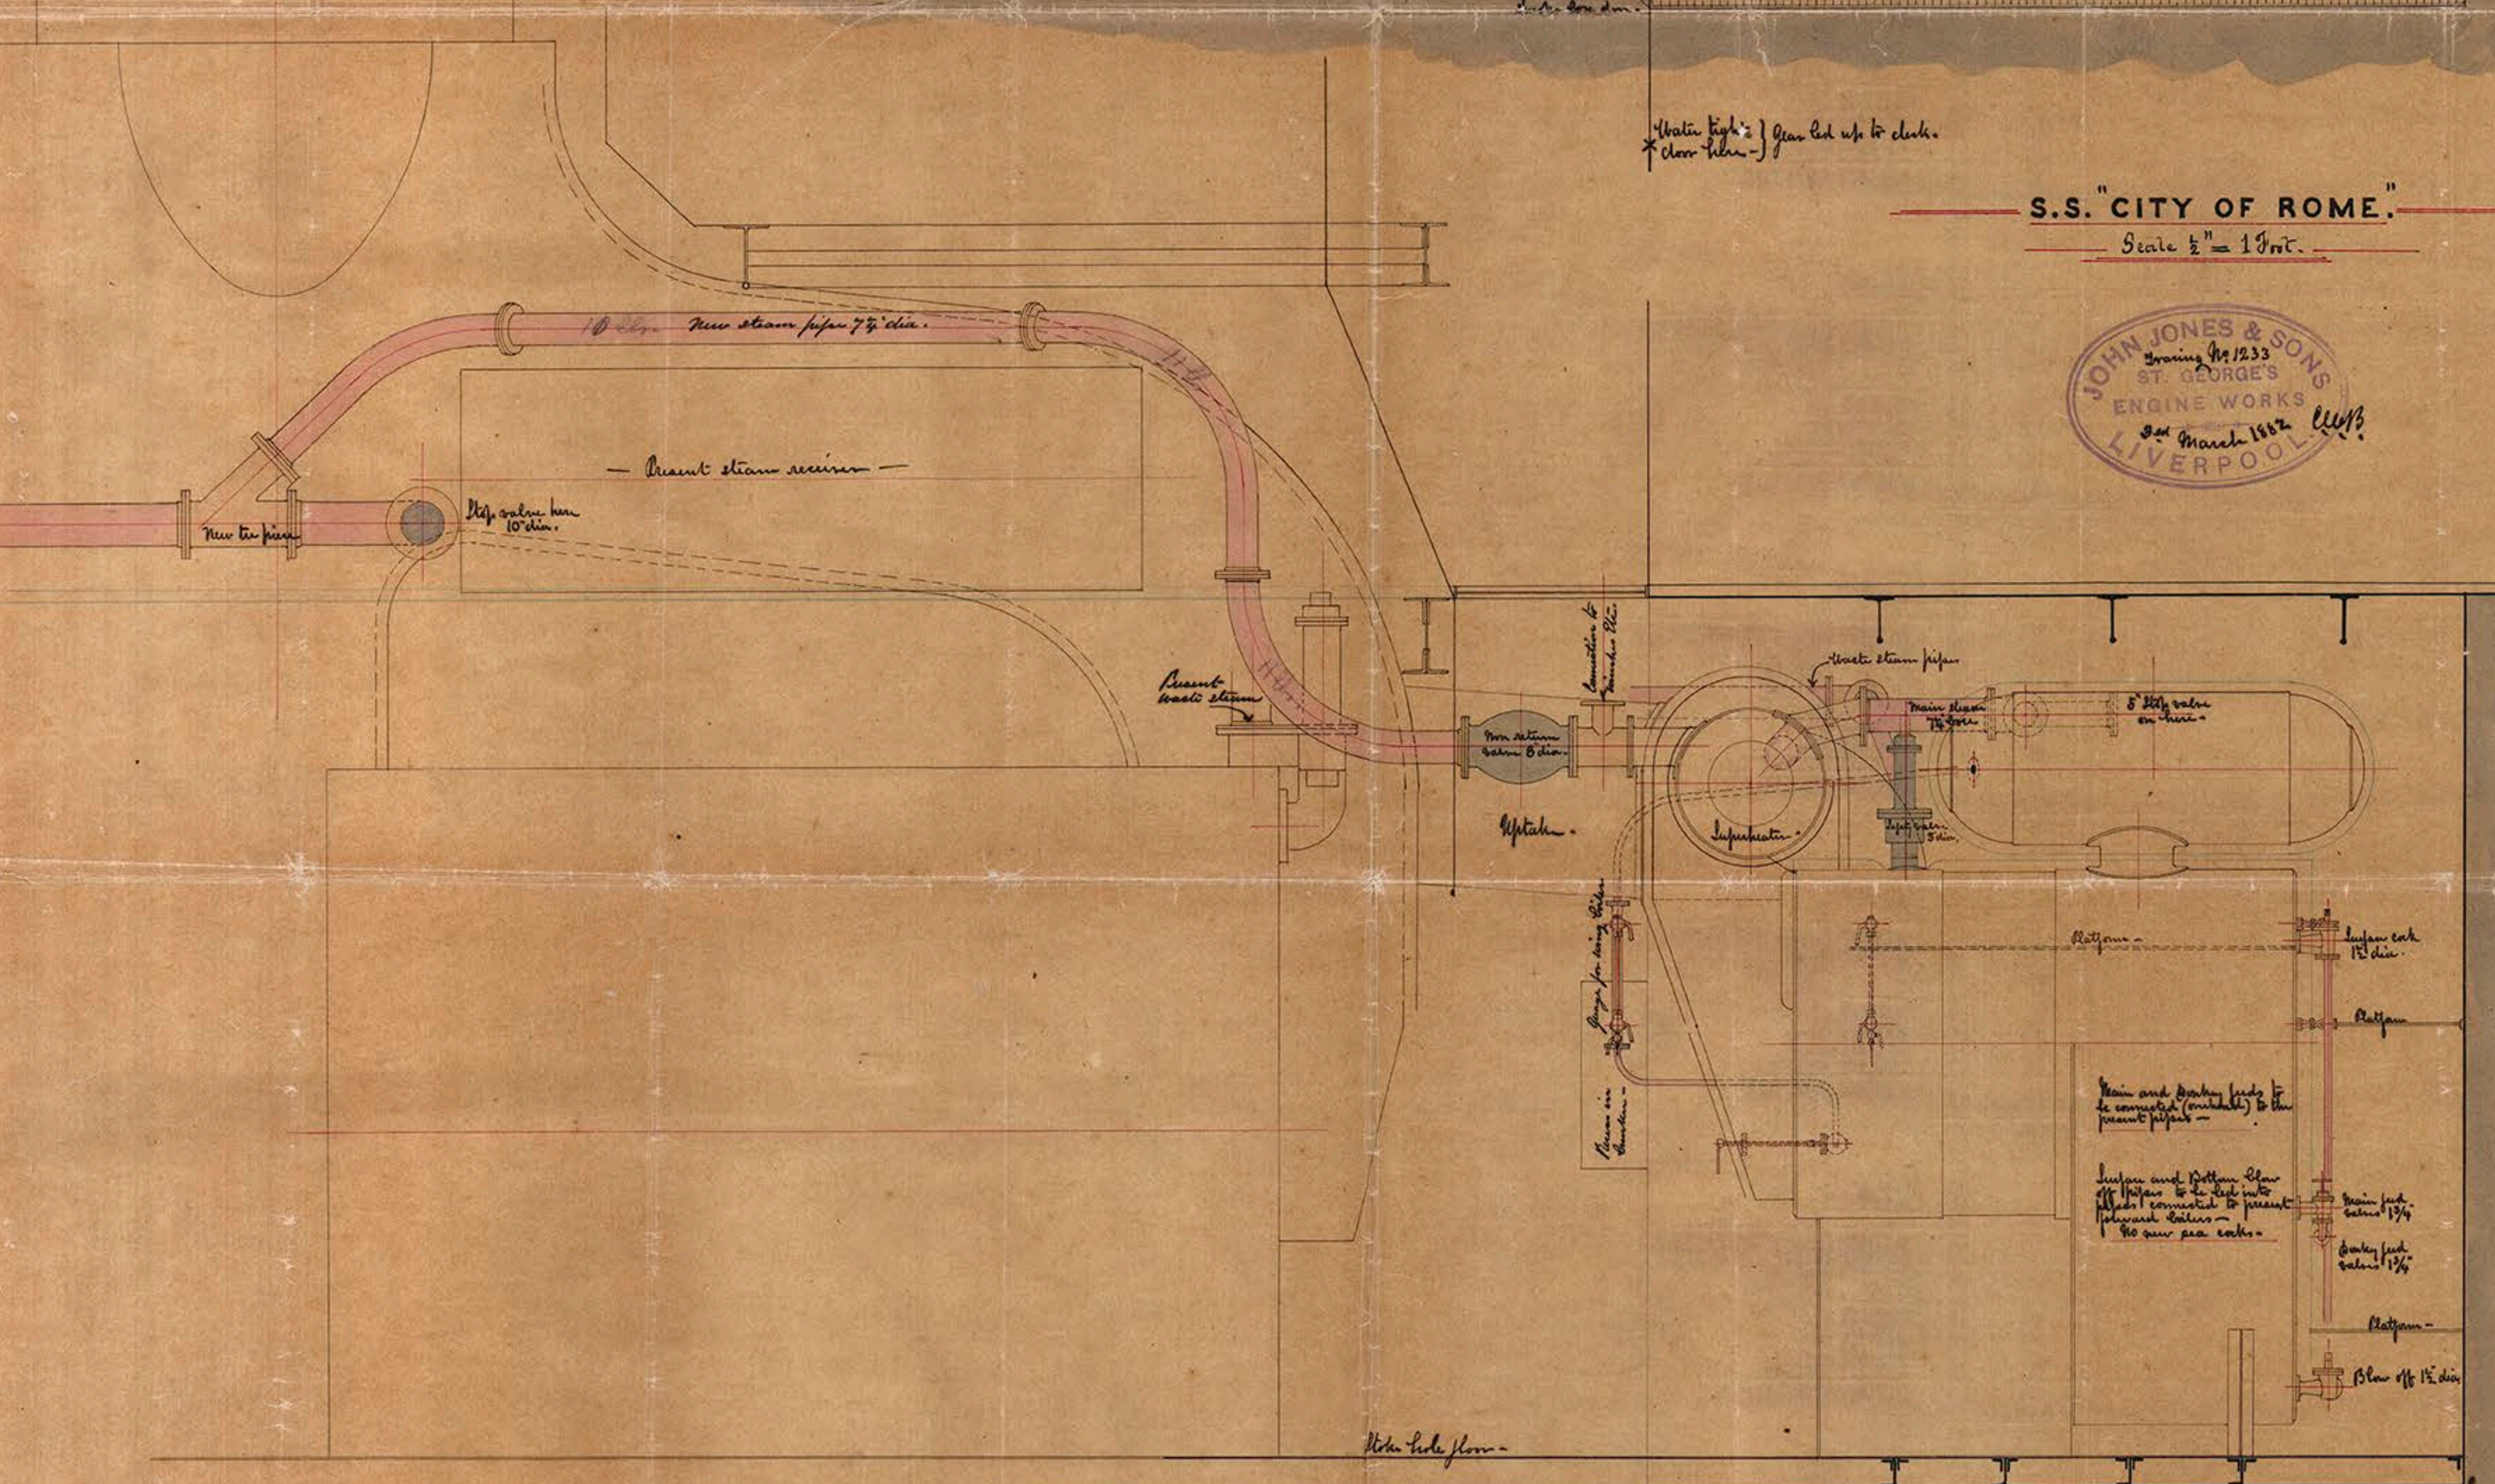



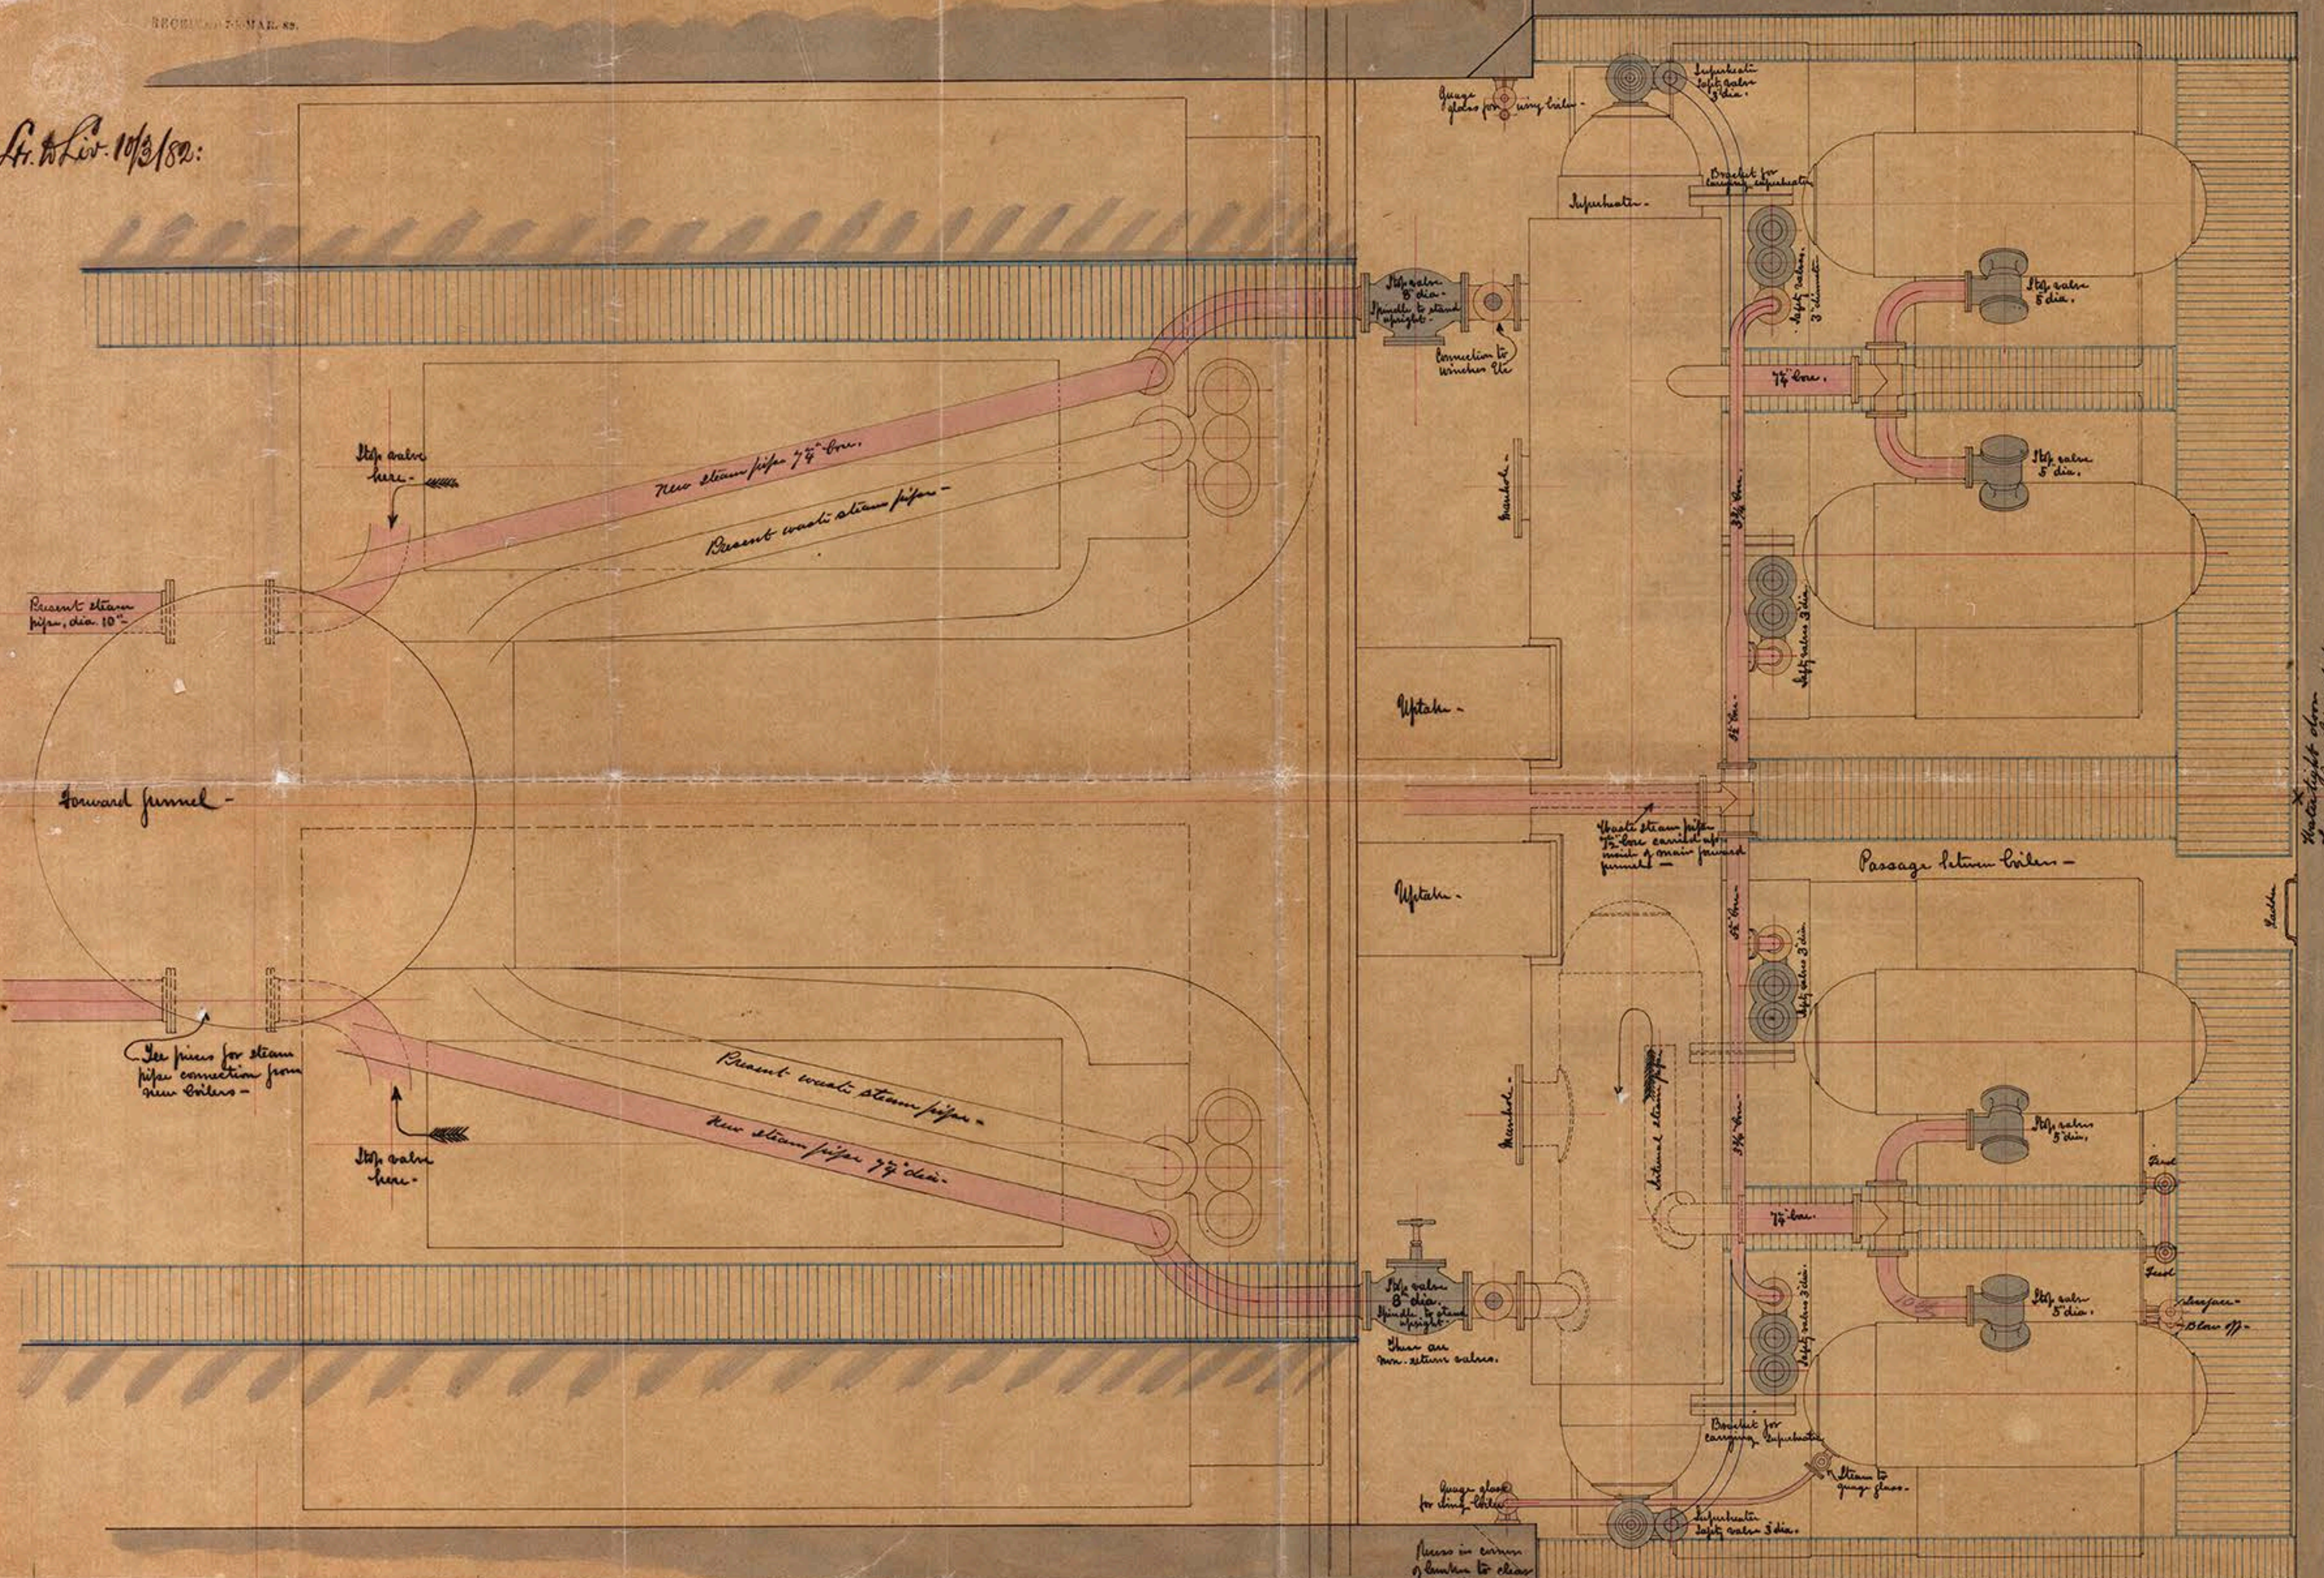

S.S. "CITY OF ROME."
Scale 1/2" = 1 ft.

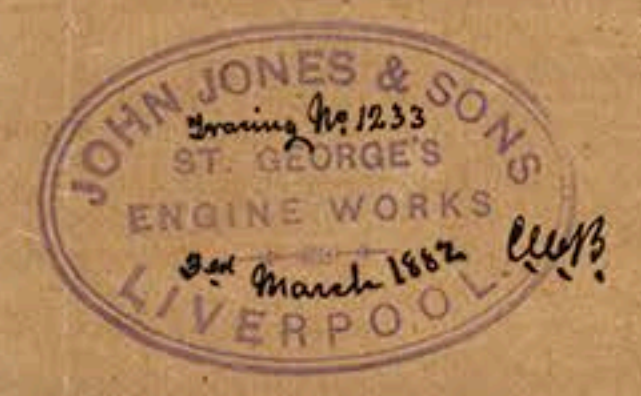

110
8/12/82