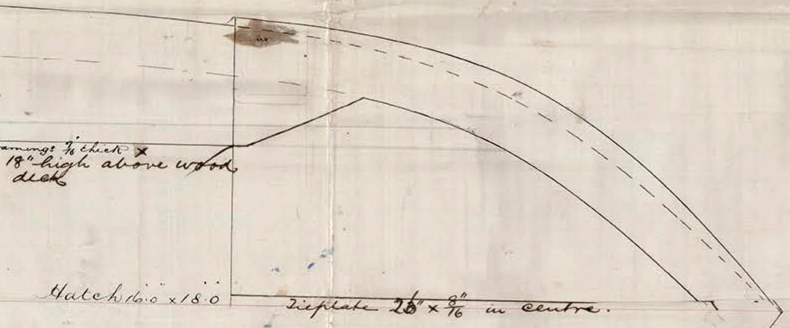
amings ⅞ thick ×
18" high above wood
deck
Hatch 16.0 x 18.0
Tieplate 2½" × 8/16" in centre.

W. GRAY & CO.
IRON & STEEL
SHIPBUILDERS
MARINE ENGINEERS
AND
WEST

AMcG. 20/1/86

West Hpl
L.
5/2/86

314

laid
addition

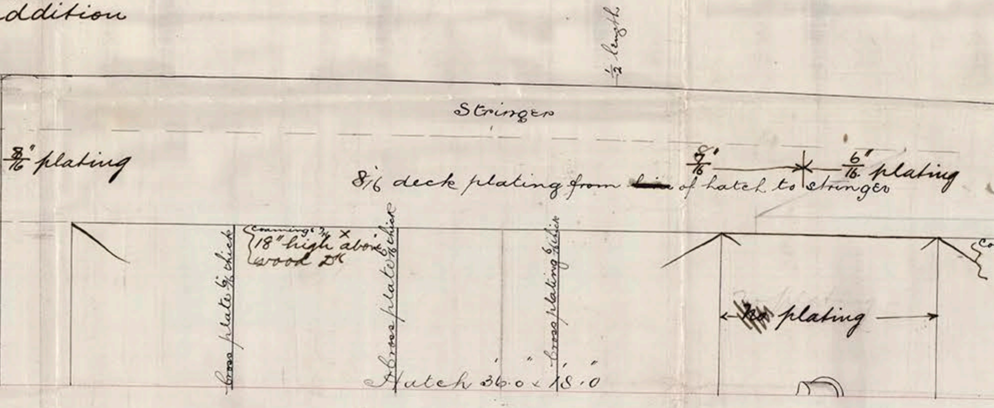
½ length
Stringer
8/16" plating
8/6 deck plating from ~~lin~~ of hatch to stringer
8/16"
6/16" plating
Cross plate 6/16 thick
Coaming 3/4 × 18" high above wood Dk
Cross plate 6/16 thick
Cross plating 6/16 thick
Hatch 36'.0" × 18'.0"
~~7/16~~ plating
Co

Deck plan of Oil Boat

Scale 1/4 - 1 foot

Complete wood deck to be all fore & aft in a to part Iron Dk

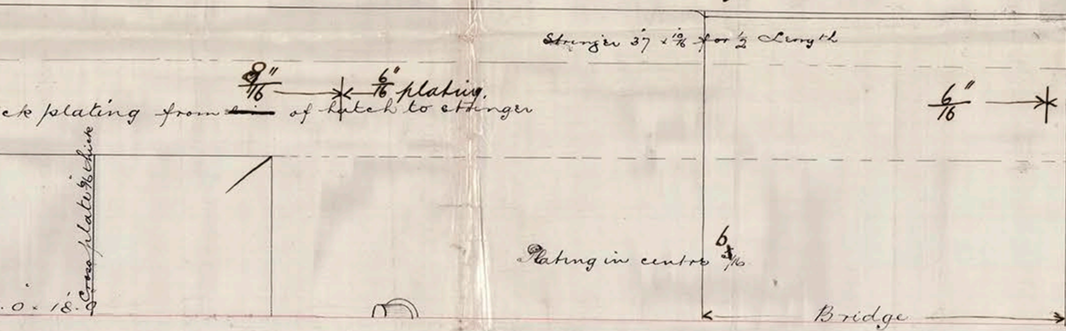
Stringer 37 × 10/16 for 1/2 Length
8″ 9/16
6″ 7/16 plating.
ck plating from of hatch to stringer
6″ 6/16
Cross plate 9/16 thick
.0 × 18.0
Plating in centre 6/16
Bridge

port No 6145

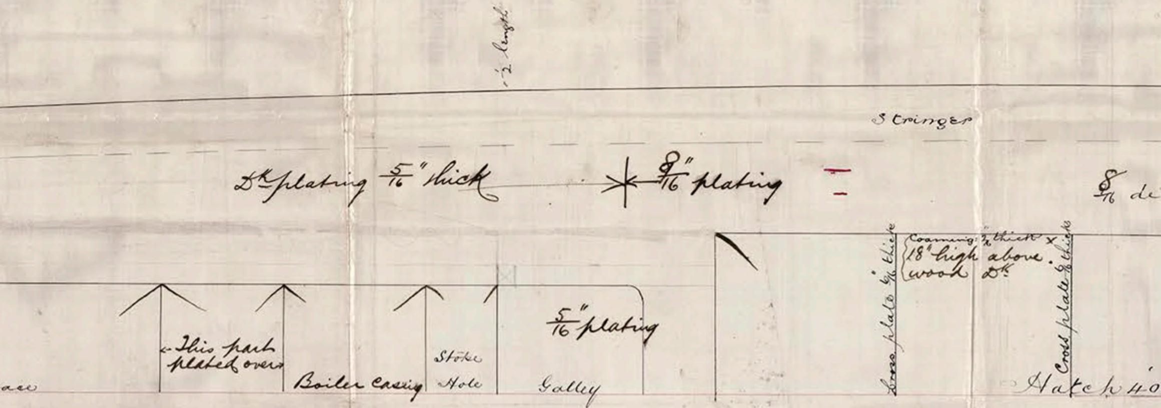
½ length
Stringers
Dk plating 5/16" thick
8/16" plating
8/16 de
Coaming: ½" thick × 18" high above wood Dk.
Cross plate 6/16 thick
Cross plate 6/16 thick
5/16" plating
← This part plated over →
ace
Boiler Casing
Stoke Hole
Galley
Hatch 40

S.S. "Bakuin" W. Hepl

© 2018 Lloyd's Register Foundation

LLOYD'S REGISTER OF SHIPPING
RECEIVED
6 FEB.
LONDON

See Ch.
12/2/86
15.3.86

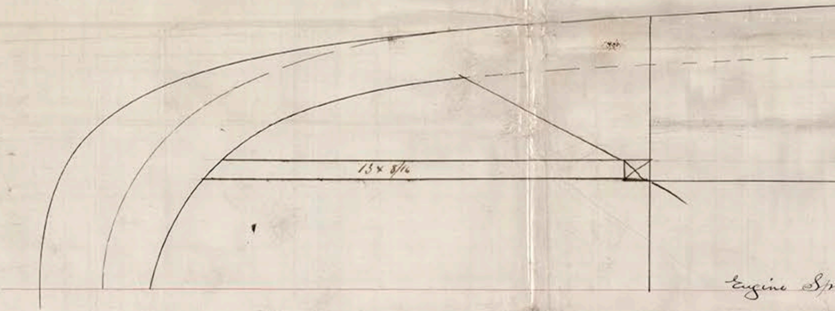
13 × 8/16
Engine Sp