


S. S. Bakwin, W. H. K. Report N. 6145

Sketch of Long Peop  
Nº 314 S.S.

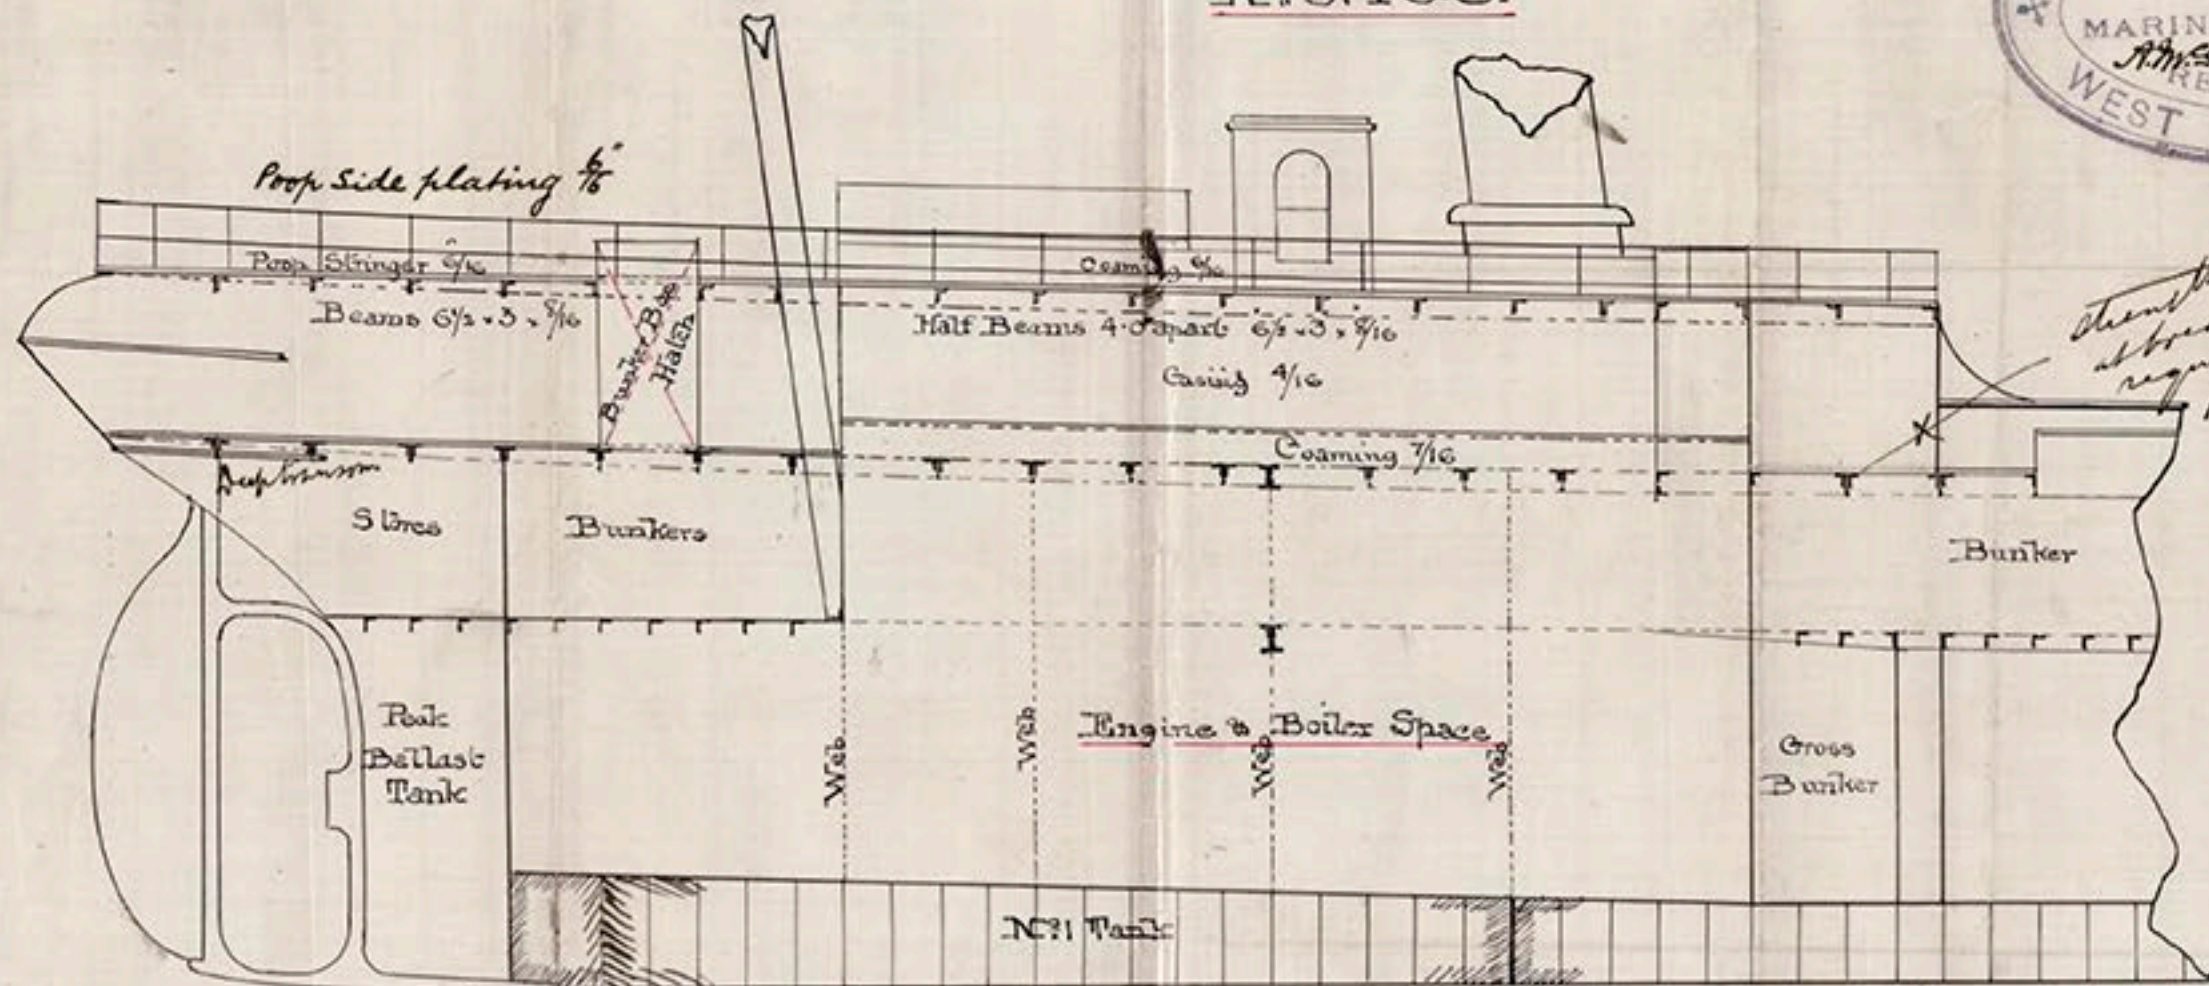

nothing  
at break  
required  
by Rules-

Scale  $\frac{1}{8}$  Inch = one foot



© 2018

Lloyd's Register  
Foundation