


17.11.87

S.S. "Bakuin" - barliff Report: 2987.

S.S. "Bakuin" Alteration in Deck Erection
 as proposed & approved
 Scale $\frac{1}{8}" = 1 \text{ foot}$



Sept 15/87

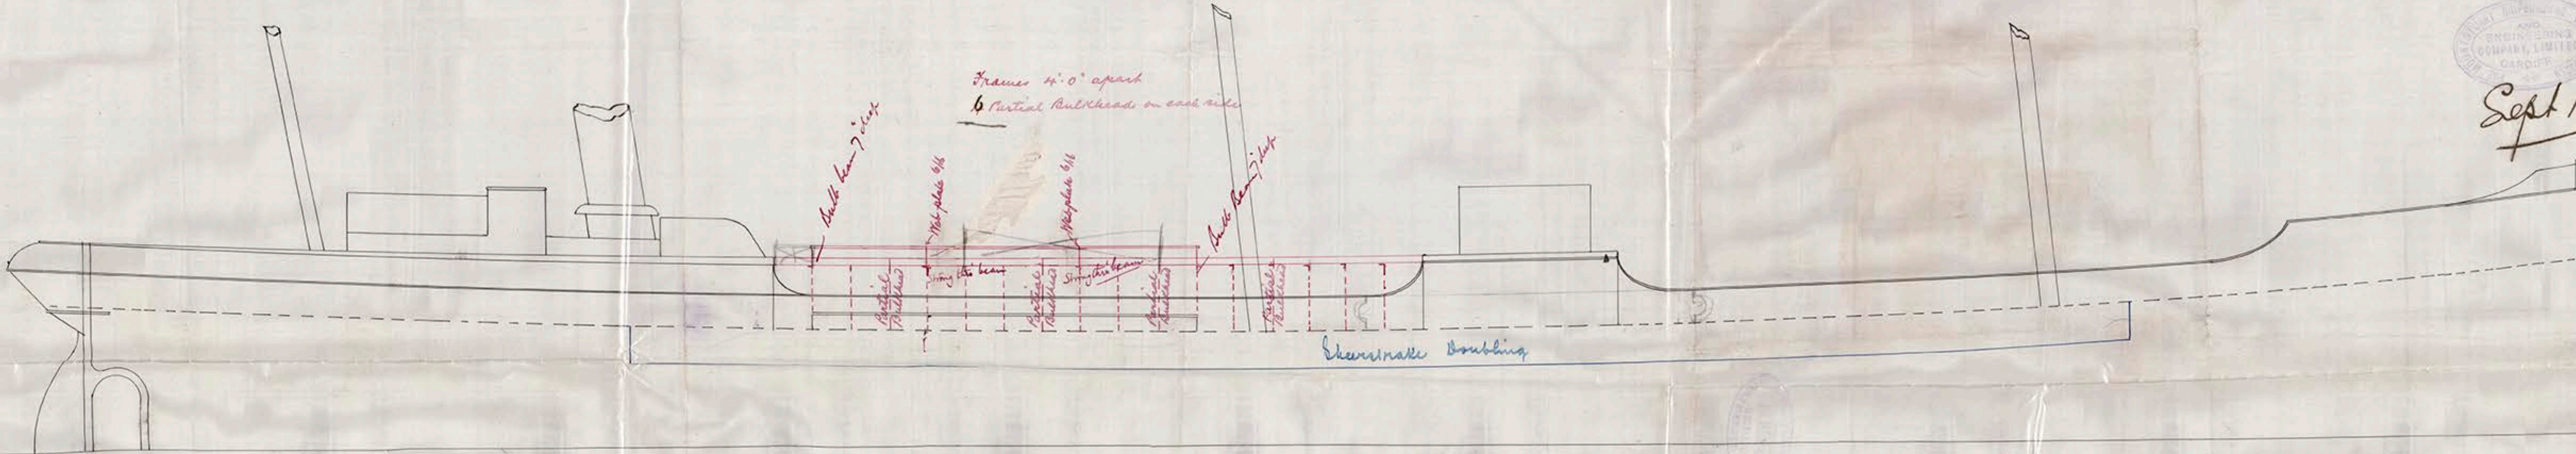

4'-0" apart
 10. Intermediate Frames

