

See Ltr.
12/2/86.

S. Bakin N. West Report No. 6115

Profile of Oil Boat
No 314 SS

17.2.86

15.3.86


26.3.86

18/5/86

13.7.86

RM

17/2/86

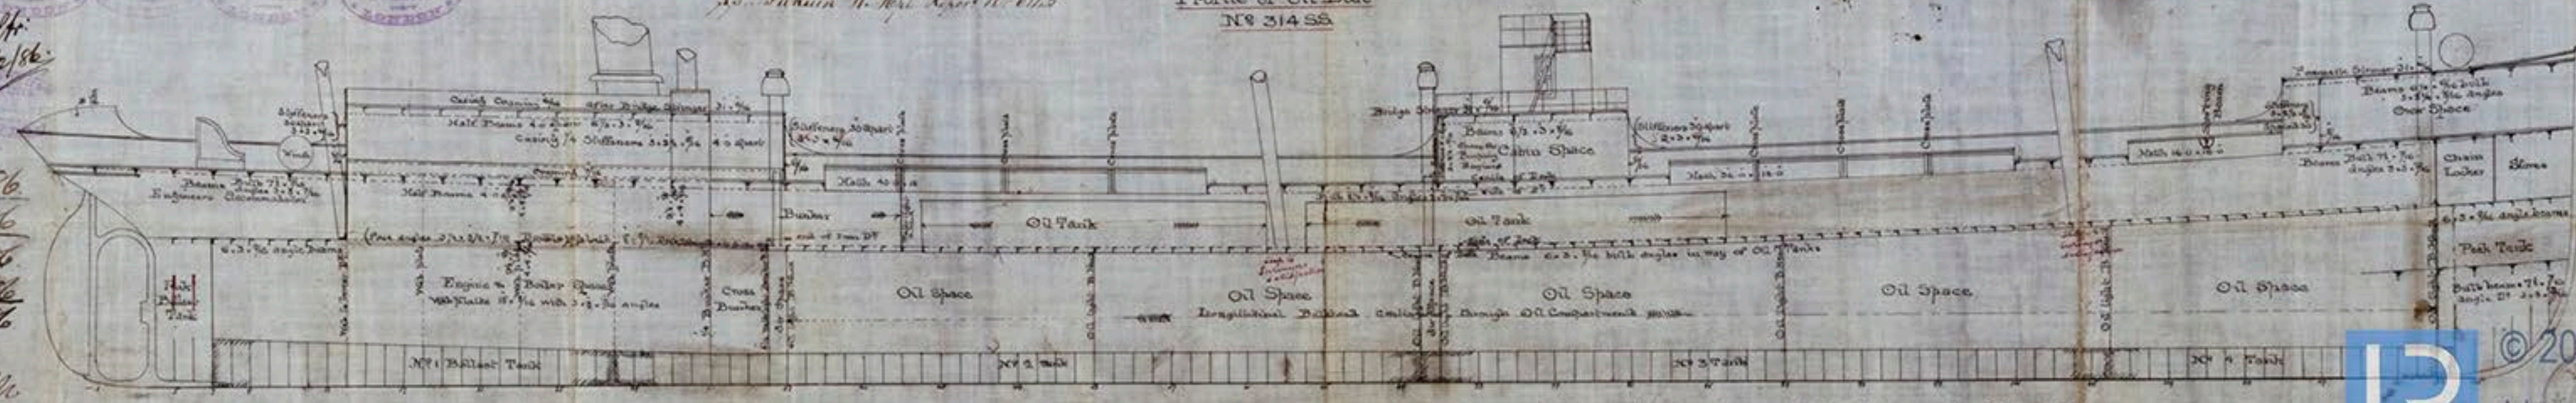

Scale 1/8" = 1'

Note: The Oil Boat will have vertical stiffeners only, all on one side. B.H.s on frames 53, 59, 106 + 123 to have a 1/2" x 1/2" built on each stiffener. B.H.s 36 + 37, and 70 + 71 to be stayed to each other by stayplates attached to the stiffeners at intervals in line of built-in stiffeners.