


Dimensions 312'-0" x 40'-0" x 28'-0" MLP. x 6'-10 1/2" Lucan. Seeps.

Scale $\frac{1}{2}$ " = 1 Foot.

TUE 27 NOV 83

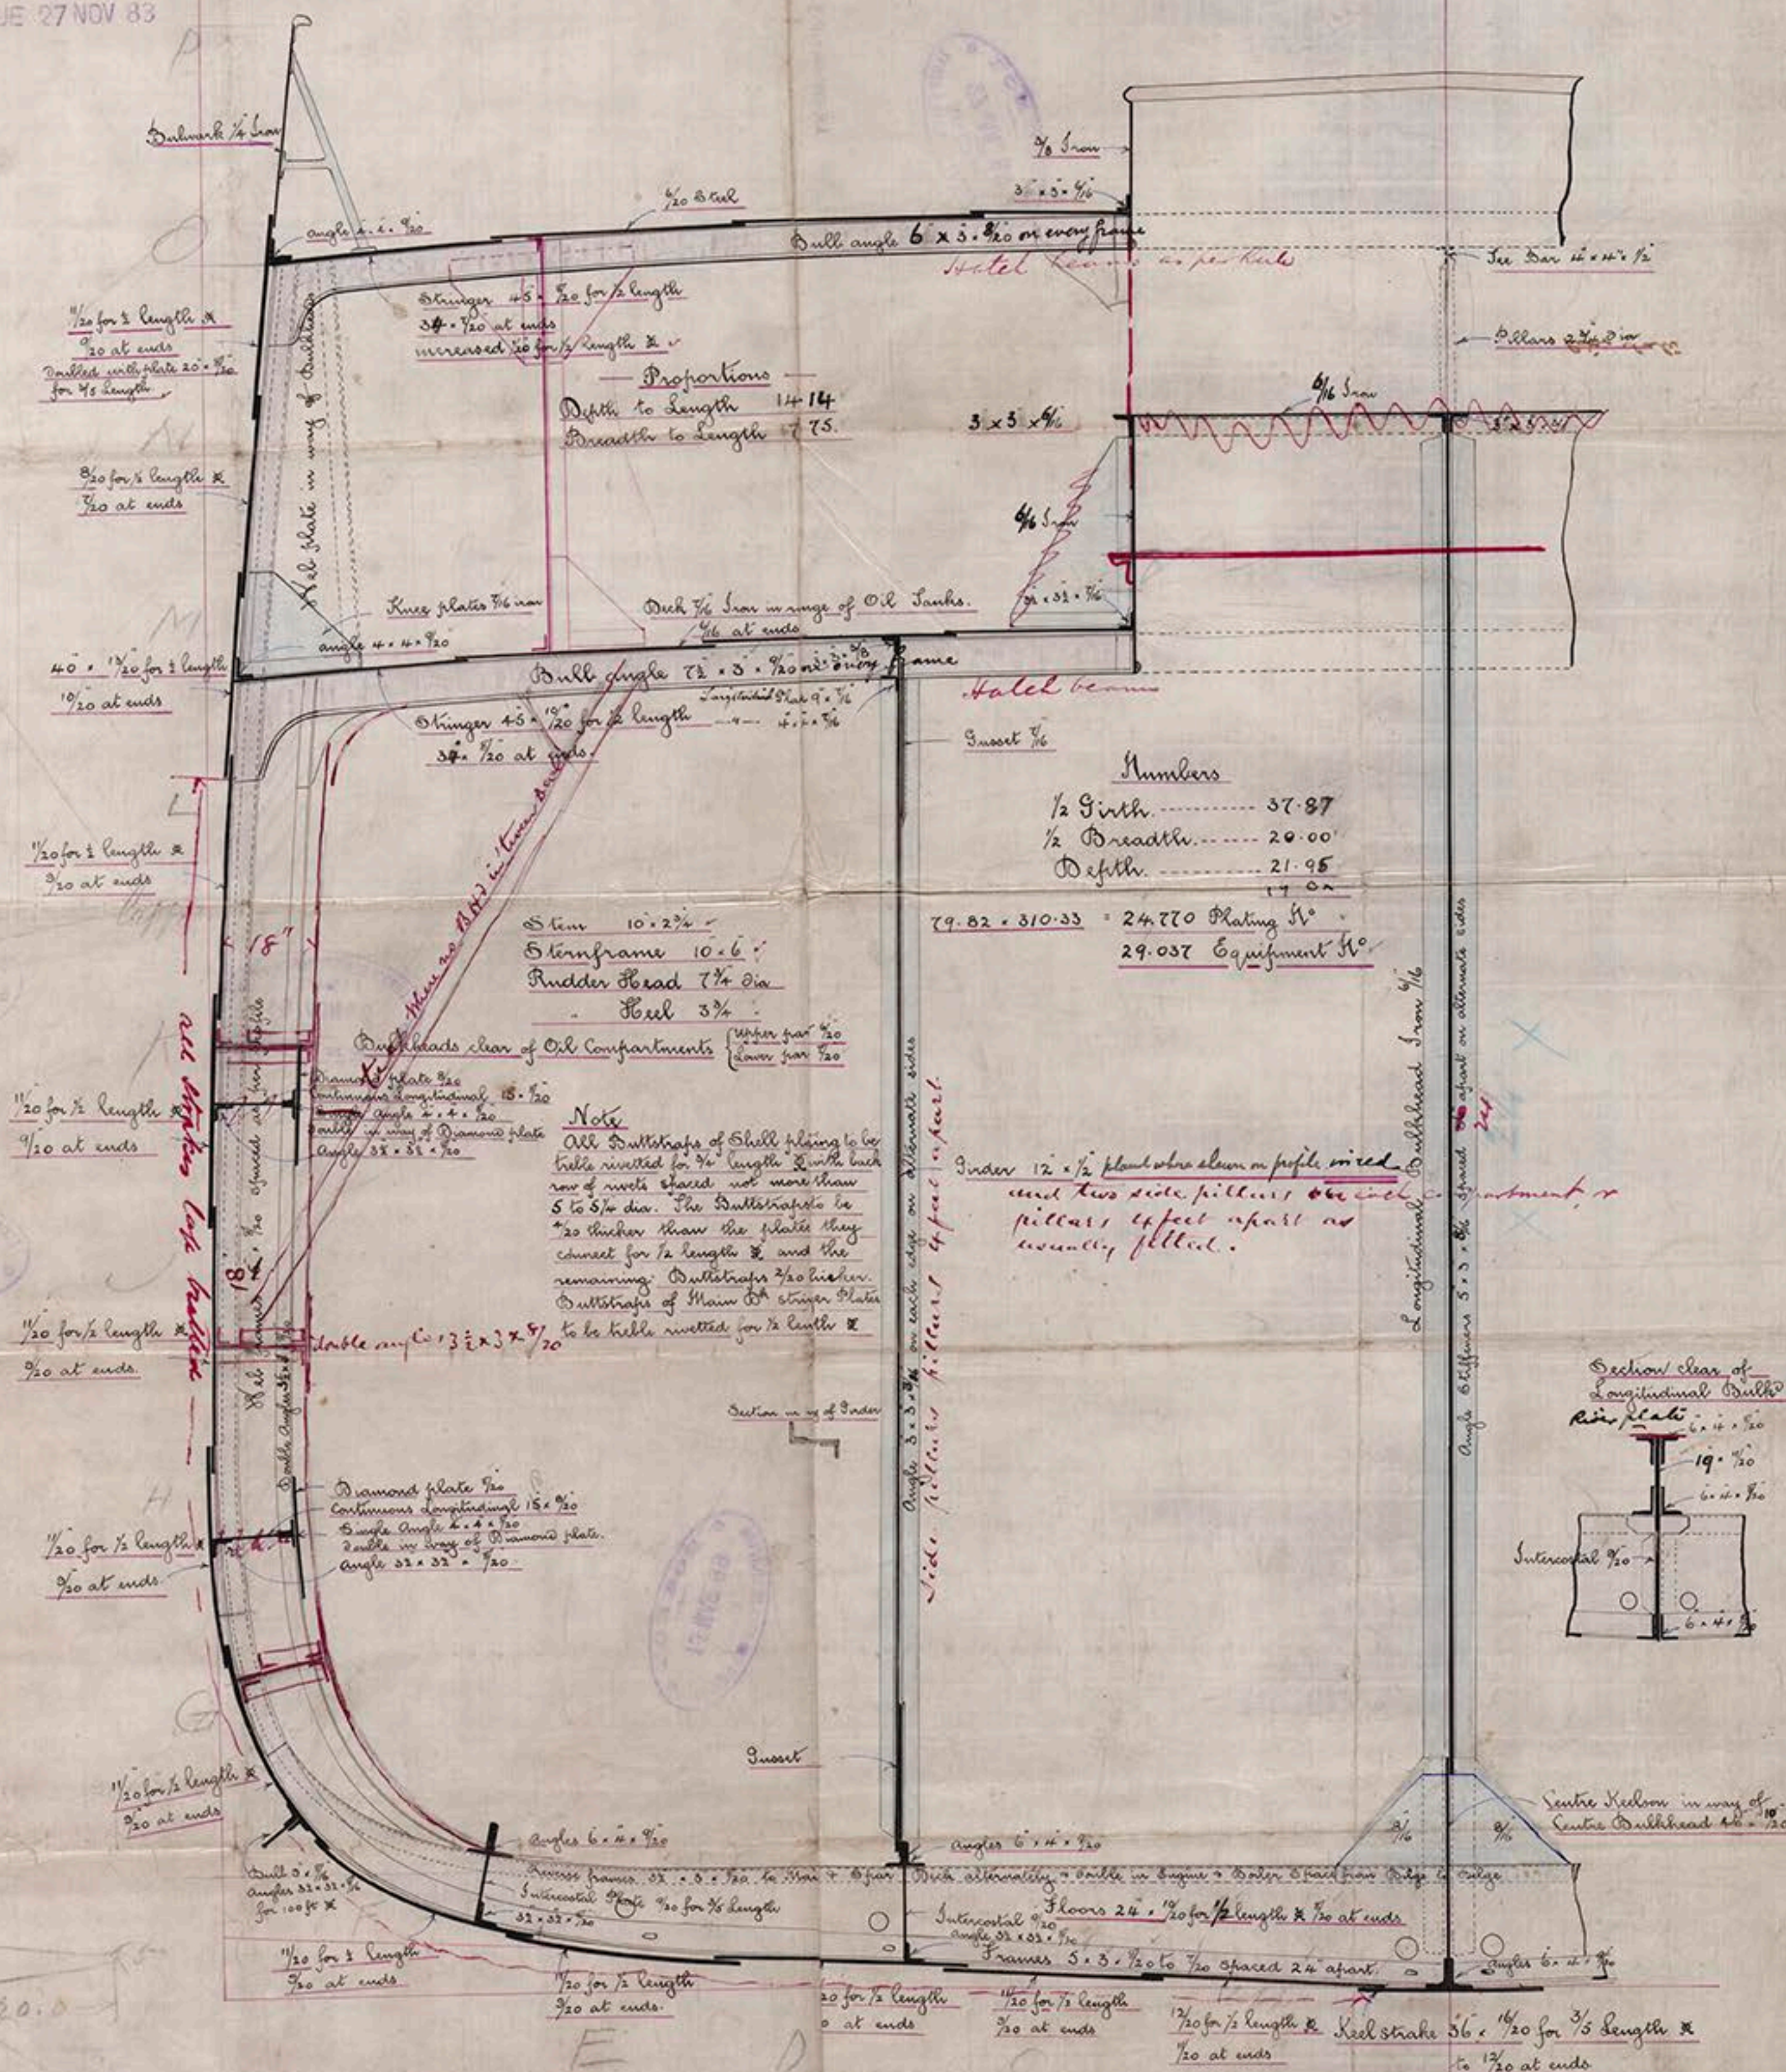

Section/ clear of
Longitudinal Bulk
in Plate . . .

Intercostal $9/20 \rightarrow$

Centre Keelson in way of
Centre Bulkhead 46 = $\frac{10}{12}$

Is. Prudentia -

22954

2 1/2





THE LLOYD'S REGISTER
SHIPPING

