

Lloyd's Register of British and Foreign Shipping.

note(Report on Vessel No. 28302 Port NEWCASTLE-ON-TYNE)No. 2281 aSHIP FORGINGS ^{and} OR CASTINGS.

I have to report that the undermentioned Iron ^{and} ~~or~~ Steel Forgings ^{and} ~~or~~ Castings, manufactured by The Darlington Forge Co. and the Westgate of Darlington & Pallion for the Vessel No. 594, being built by Messrs Armstrong Mitchell & Co. of Newcastle have been inspected by me as set forth below, and found to be, so far as can be seen, sound.

The rudder frame has been tested as required by the Rules and found satisfactory



Mark on Forgings.

Lloyd's

No. 2281 aN.C.*Joseph Cameron*

	<i>Westgate</i> STERN FRAME.	<i>Darlington Forge Co.</i> RUDDER FRAME.	<i>Sunderland.</i> STEM.
Material*	<i>Scrap iron</i>	<i>Simons steel</i>	<i>Scrap iron</i>
How made	<i>Forged</i>	<i>Cast</i>	<i>Forged</i>
Dimensions	<i>11' 6 1/2"</i>	<i>as per drawing attached</i>	<i>11' 2 1/2"</i>
Progress on Inspection .	<i>Forged & smithed</i>	<i>Cast & tested</i>	<i>Forged</i>
Dates when Inspected	<i>July 28th & Aug 27/92</i>	<i>Oct 7. Nov 11-14/92</i>	<i>Aug 26/92</i>

SKETCHES OF FRAMES SHEWING POSITION AND DESCRIPTION OF WELDS OF FORGINGS, OR PARTICULARS OF TESTS APPLIED TO CASTINGS.

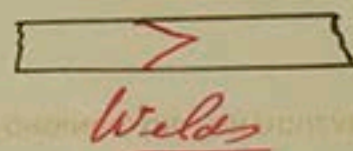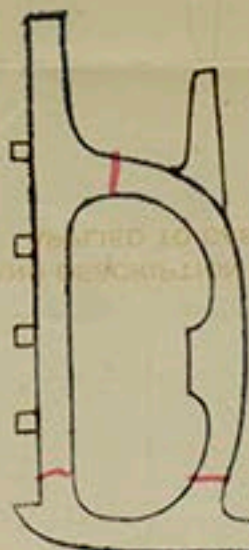

© 2018

Lloyd's Register
Foundation














A. Mitchell & Co
597

