

S. Nr 180.

Stern-frame.

Scale 1:15.

Material: Siemens Martini
or Cast-Steel.

Section a-b

Section c-d

10.1.08. C.D.

Skern - frame.

Scale 1:15.

Material: Siemens Martin Steel. (Forged)
or Cast-Steel.

Section a - b

Section C - d

Wm. Lloyd

Blohm & Voos,
Hamburg.
Ant. für Engl. Lloyd
General. Herrn Frane
N. 180

5/1.05.

.081 250 26

Charm - mraX26


"Pamir"

St 4 Mt Plc. N: 180

Blohm & Voos

Hann letter 7/1 05

Rept N: 8741

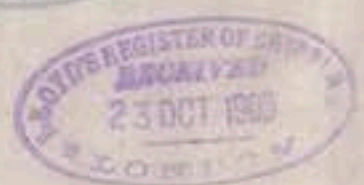

b - 2 mair

2/10



© 2018

Lloyd's Register
Foundation