


"Parrish"  
Parrish  
 Rept. N 8741  
 S. N. 180

Building by Mrs. Bloom. No  
Hamburg

Plan of Bowditch

Ham. letter 23/1 05

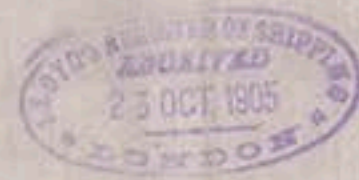

0.1% \* 8, \* 4, \* 10



25/1/02



S. No 180.  
Bouwpriit & jibboom.  
Scale 1:50.

Bonsprit & jiboon.

Scale 1:50.

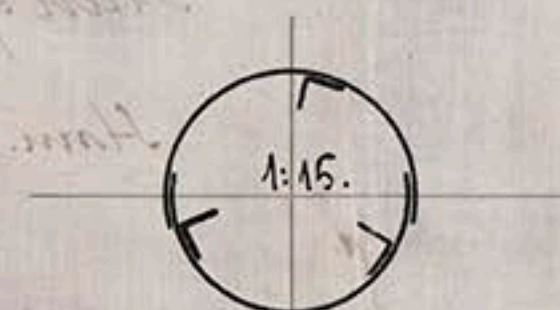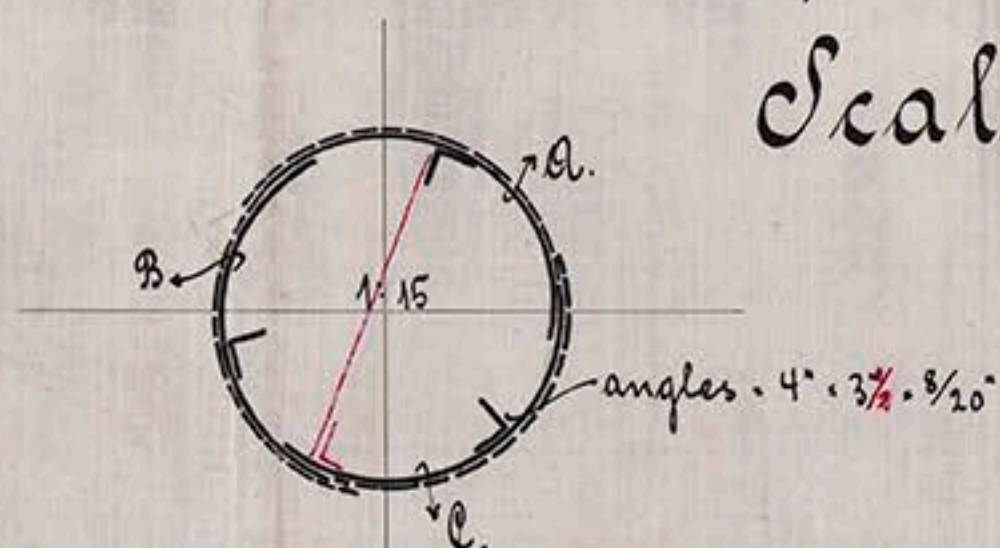

Riveting.  
Landings double riveted  
Butts triple riveted  
Straps <sup>2</sup>/<sub>3</sub> in. thicker than plates they connect

27/1/05

